


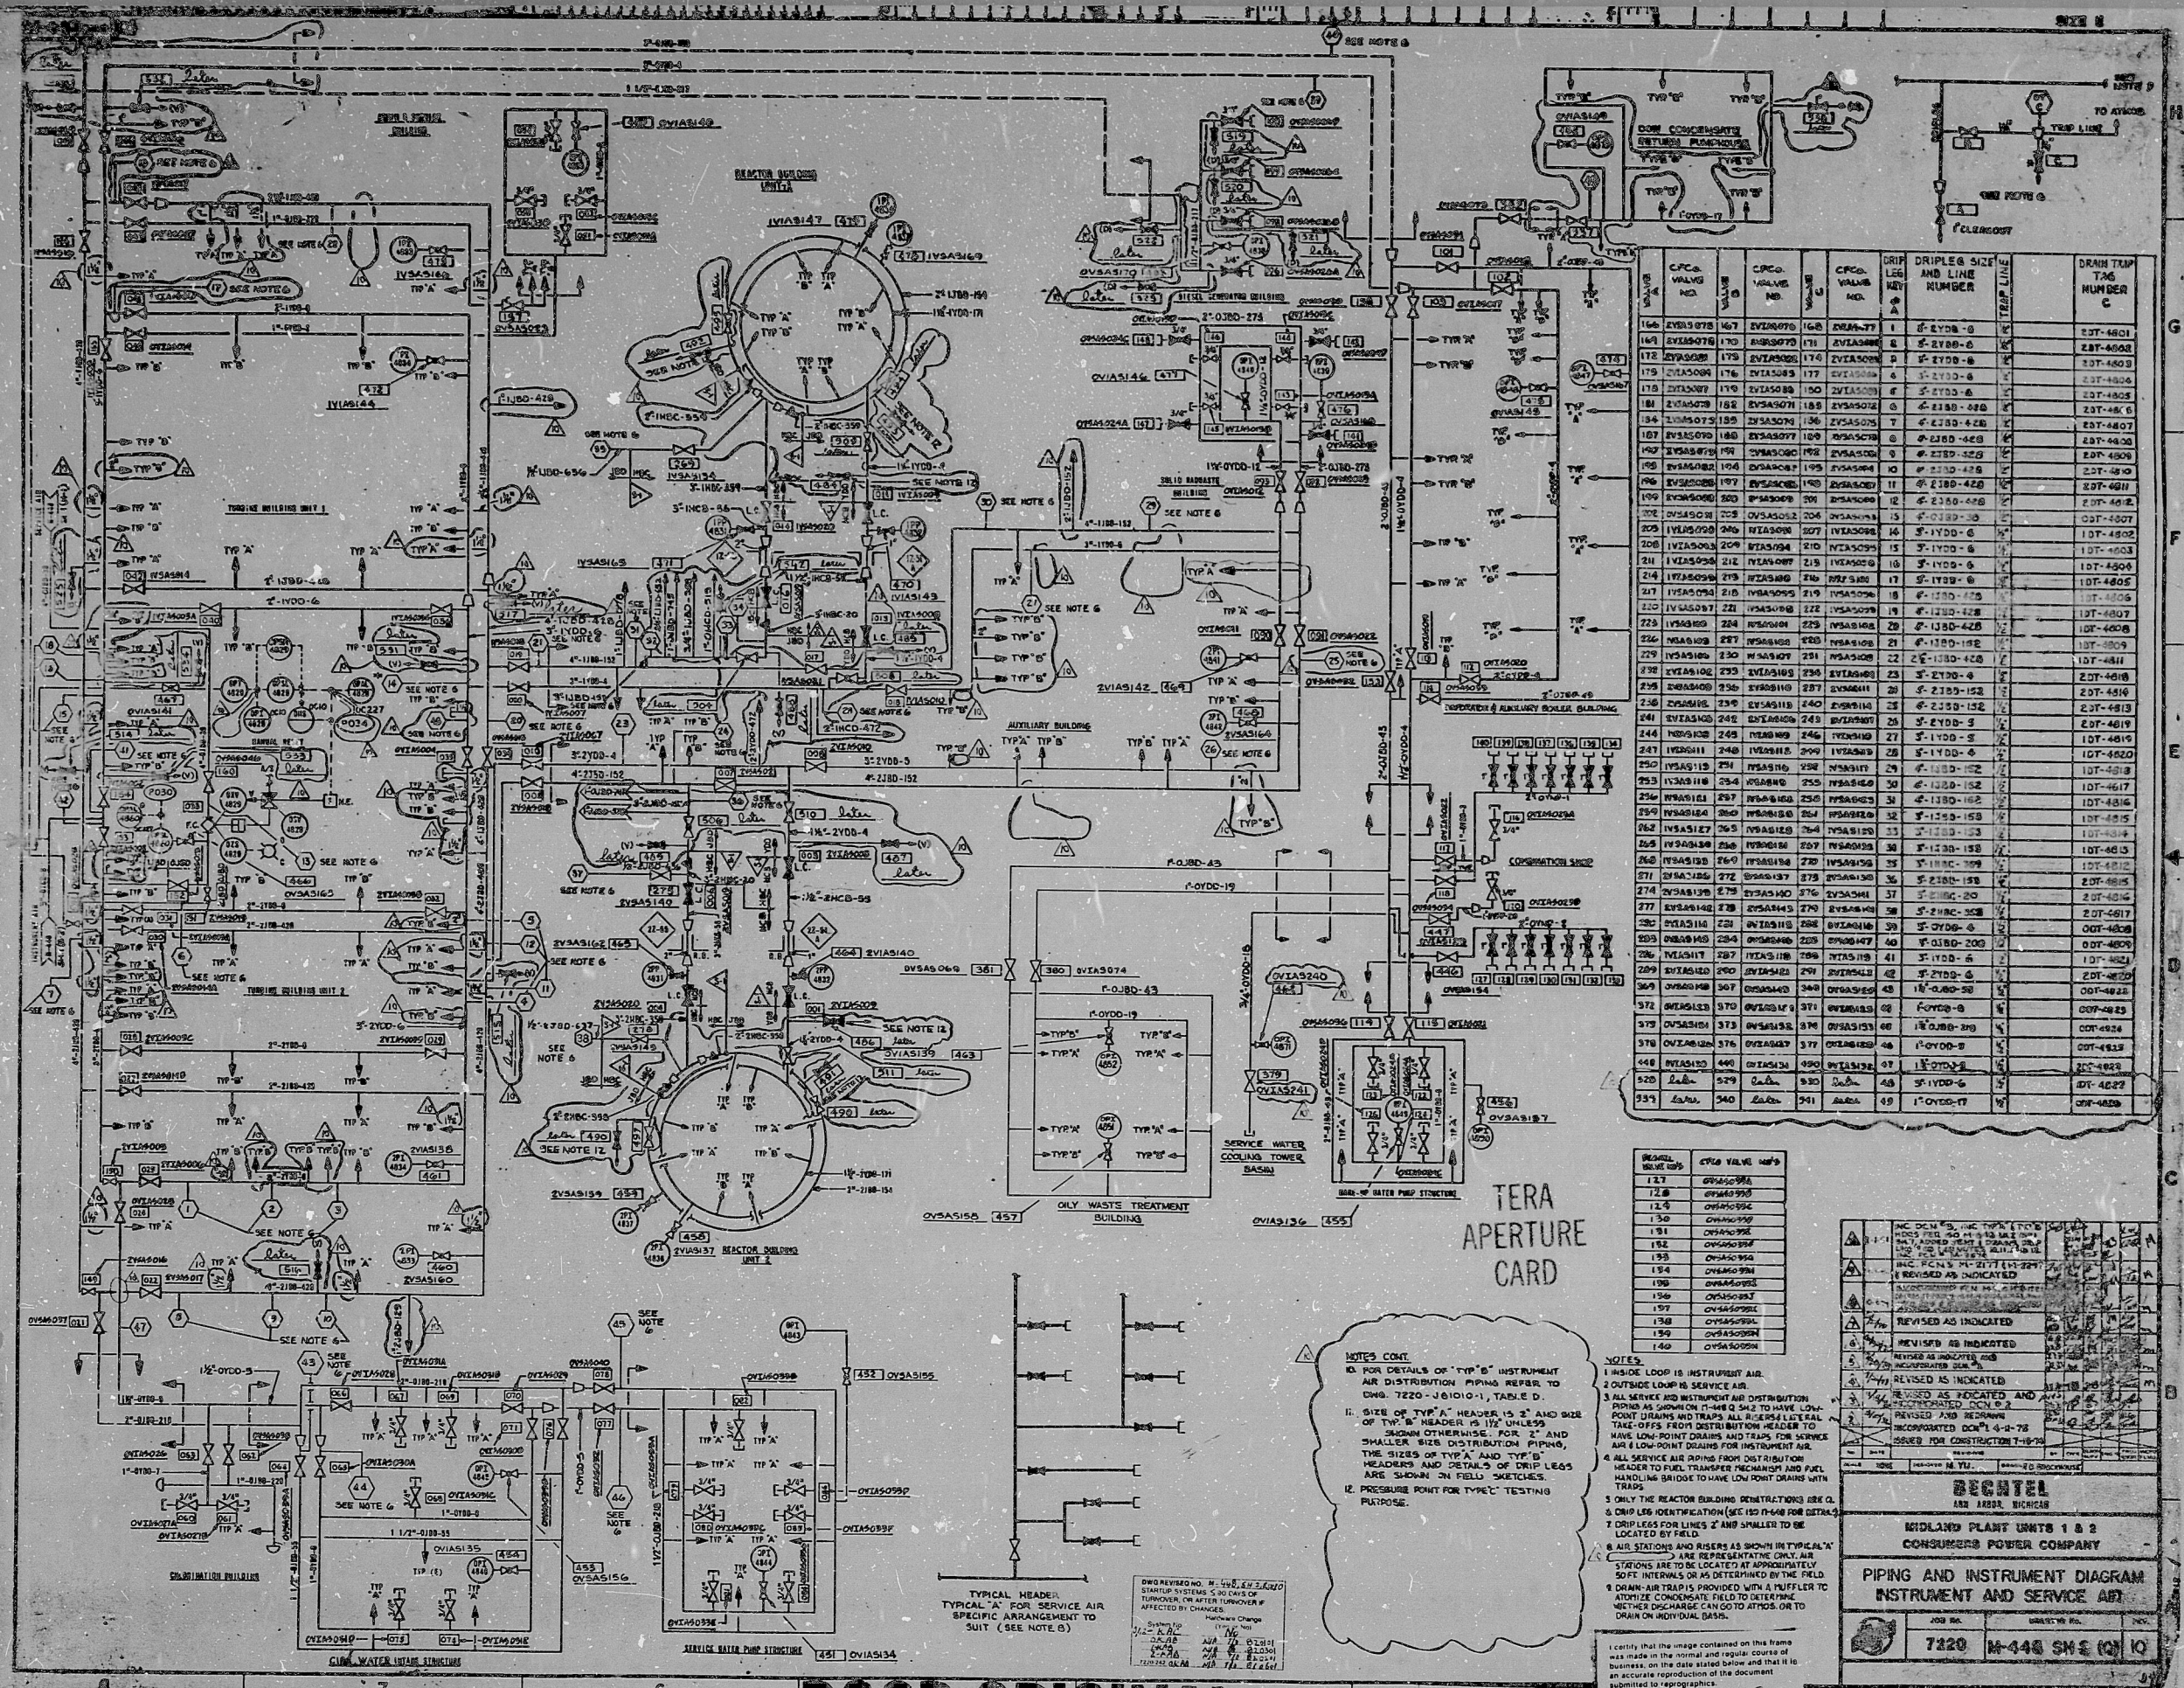


TERA
APERTURE
CARD

NOTES CONT.
1. FOR DETAILS OF "TYP" INSTRUMENT AIR DISTRIBUTION PIPING REFER TO CHG. 7220-J6101-1, TABLE D.
2. SIZE OF "TYP" HEADERS IS 2" AND SIZE OF "TYP" B' HEADERS IS 1 1/2" UNLESS SHOWN OTHERWISE. FOR 2" AND SMALLER SIZE DISTRIBUTION PIPING, THE SIZES OF "TYP" AND "TYP" HEADERS AND DETAILS OF DRIP LEGS ARE SHOWN IN FIELD SKETCHES.
3. PRESSURE POINT FOR "TYP" TESTING PURPOSES.

TYPICAL 'A' FOR SERVICE AIR SPECIFIC ARRANGEMENT TO SUIT (SEE NOTE 6)


MIDLAND PLANT UNITS 1 & 2

CONSUMERS POWER COMPANY

PIPING AND INSTRUMENT DIAGRAM

INSTRUMENT AND SERVICE AIR

7220 M-448 SH 5 (1) 10

POOR ORIGINAL 30X

RIDS

8109250056

