


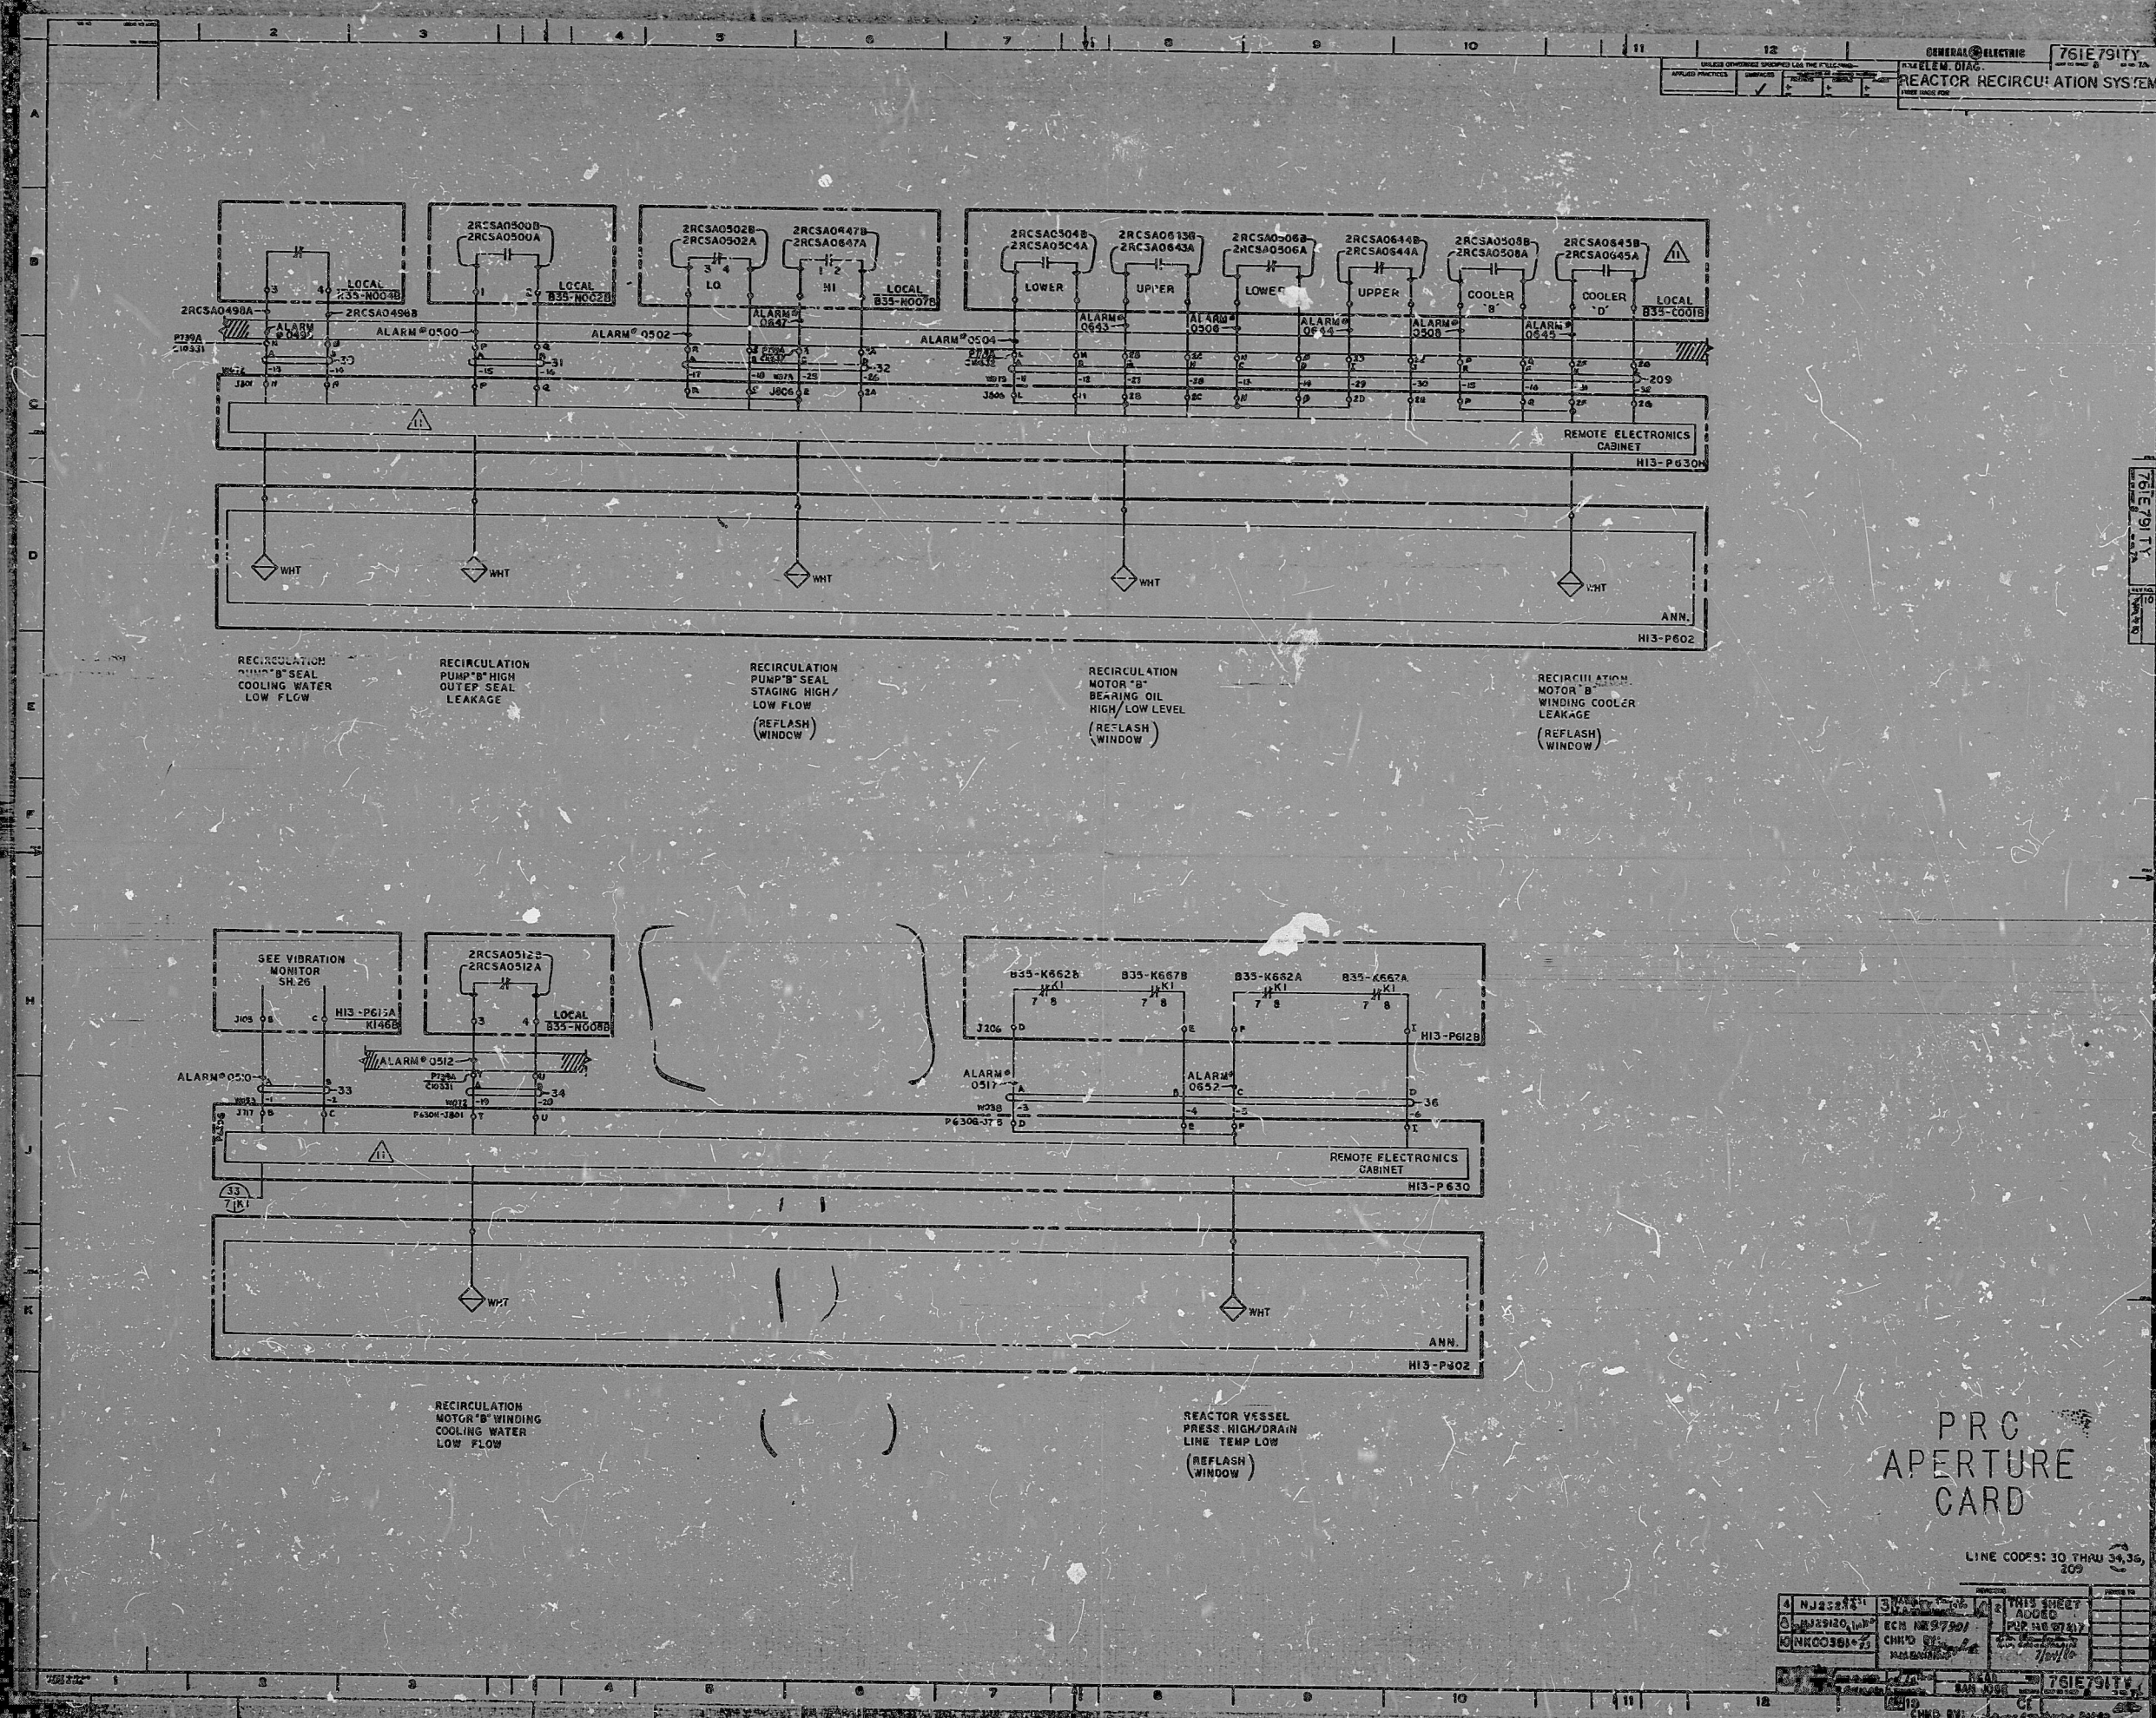

GENERAL ELECTRIC 761E791TY
REACTOR RECIRCULATION SYSTEM
761E791TY
H13-P630
H13-P602

PRC
APERTURE
CARD

LINE CODES: 30 THRU 34, 36, 209


PDR RIDS

84φ131φ50φ

