




RIDS

8303030012

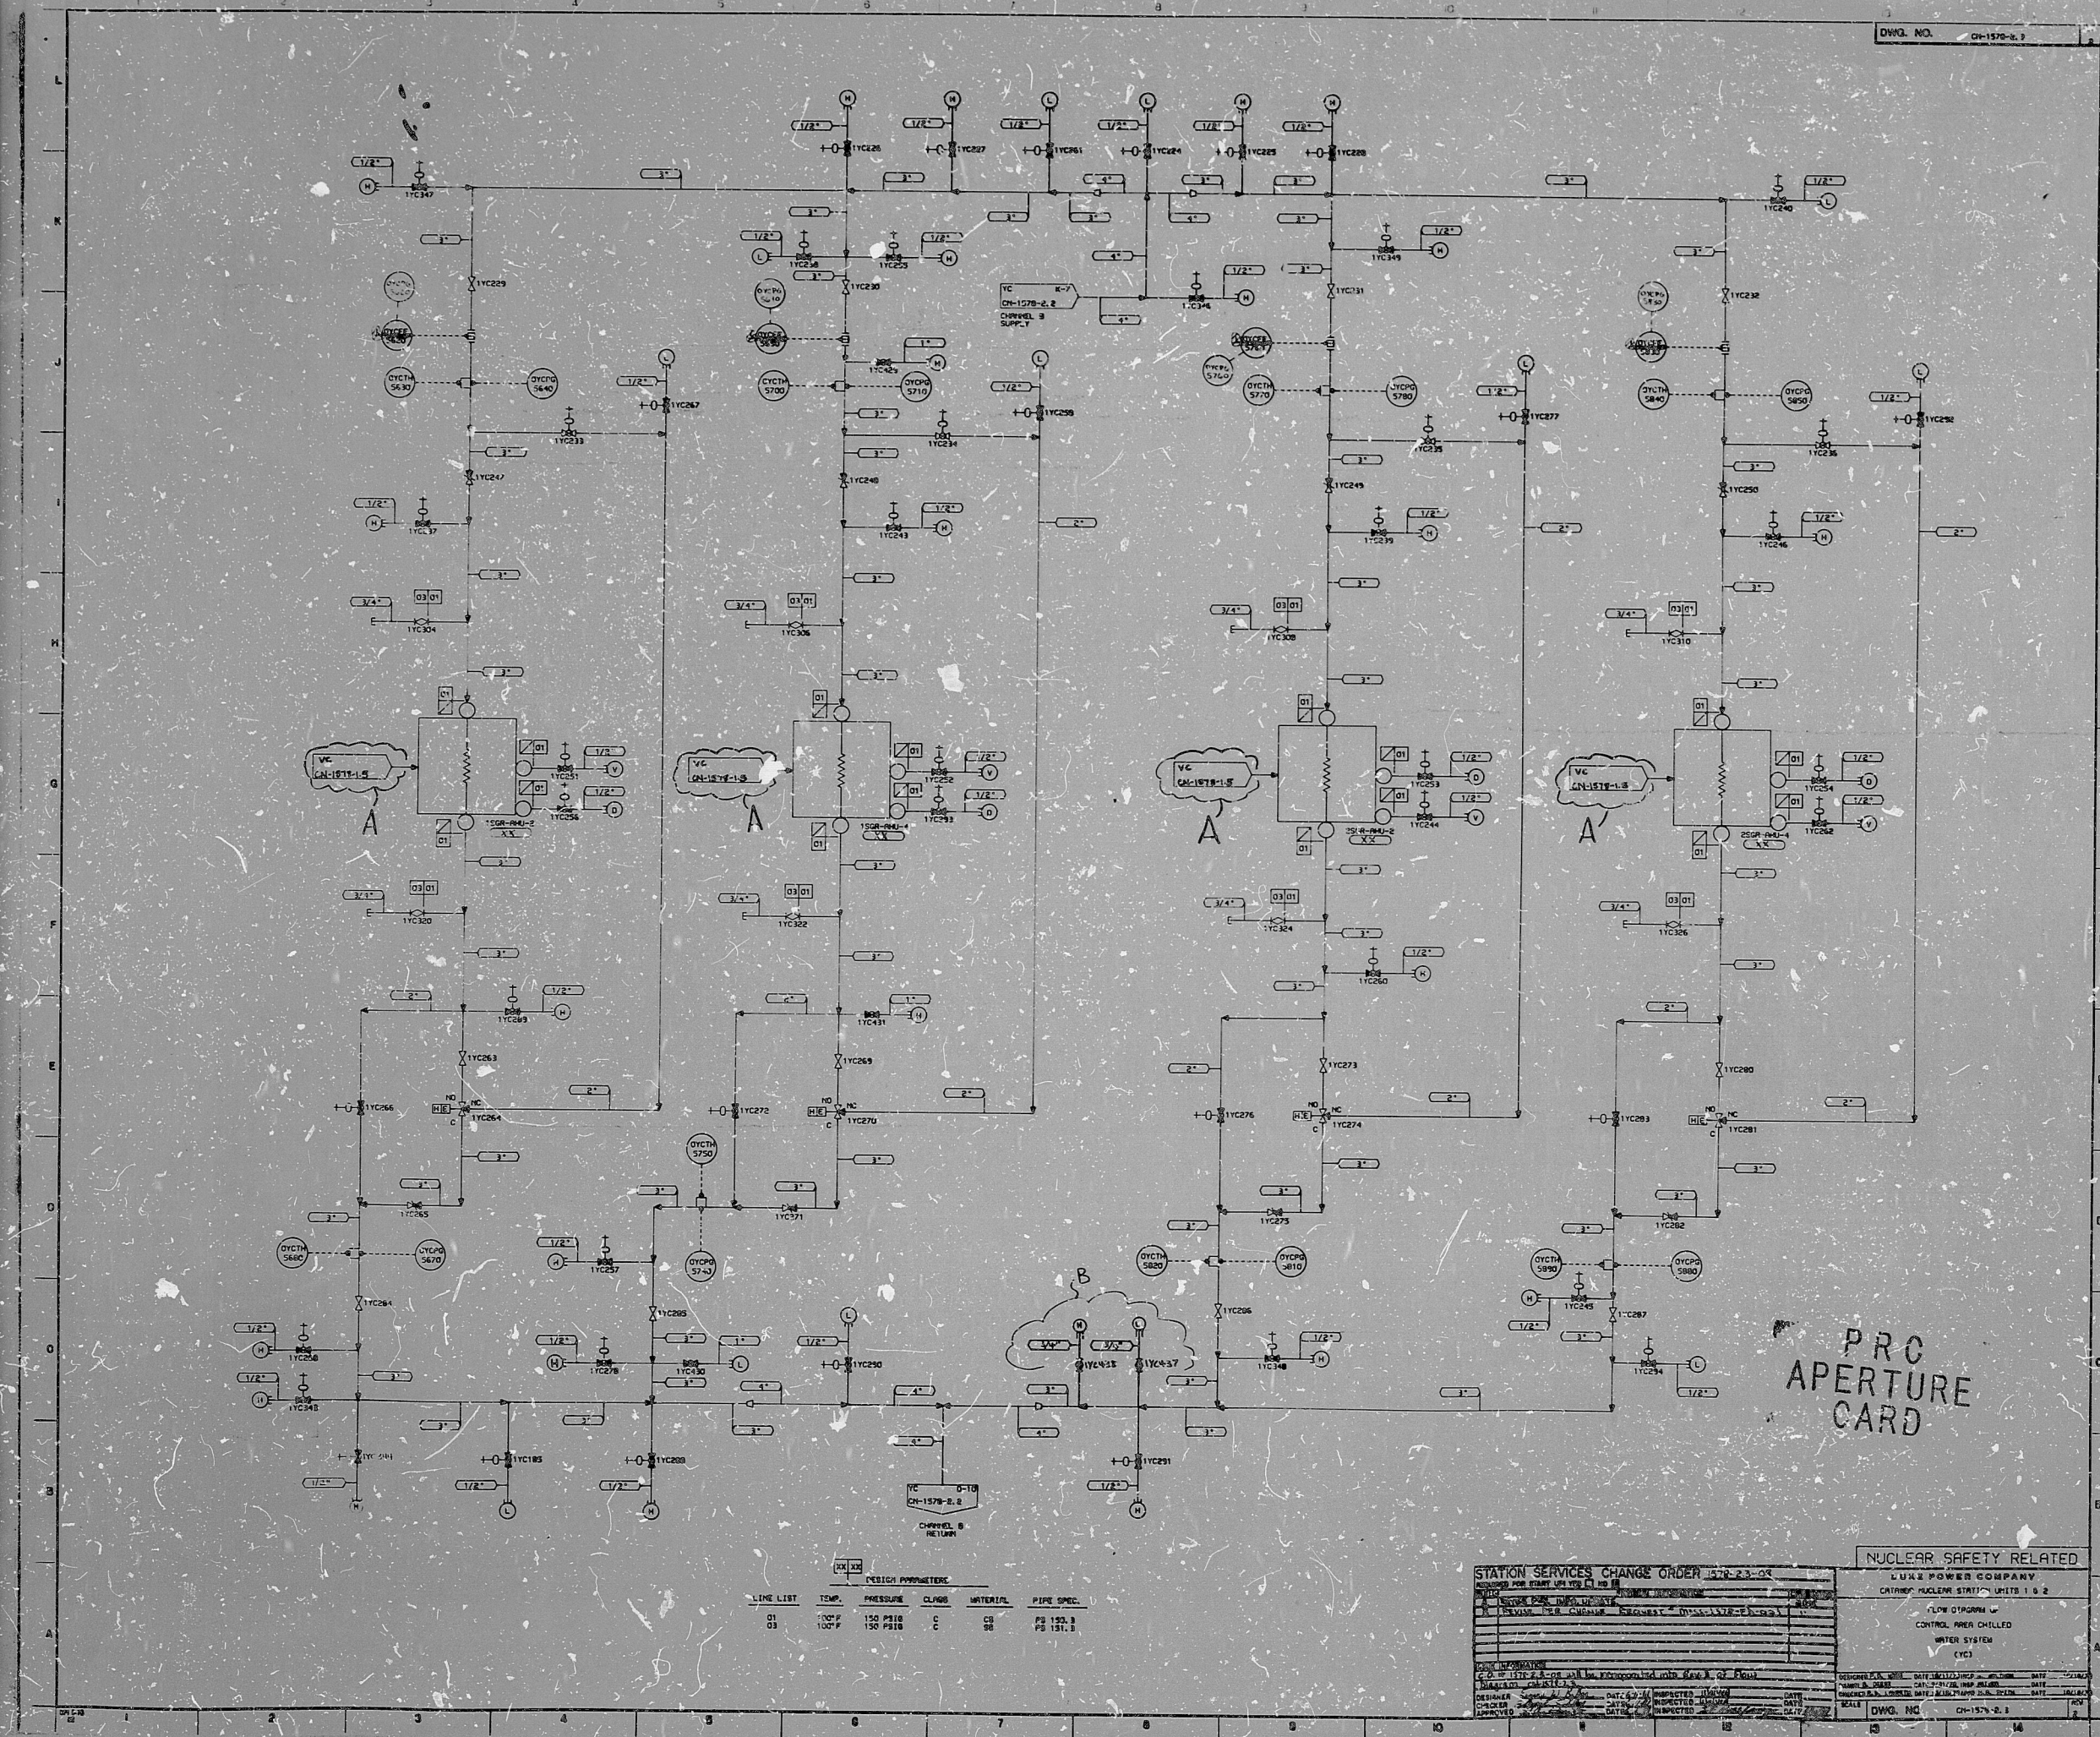