
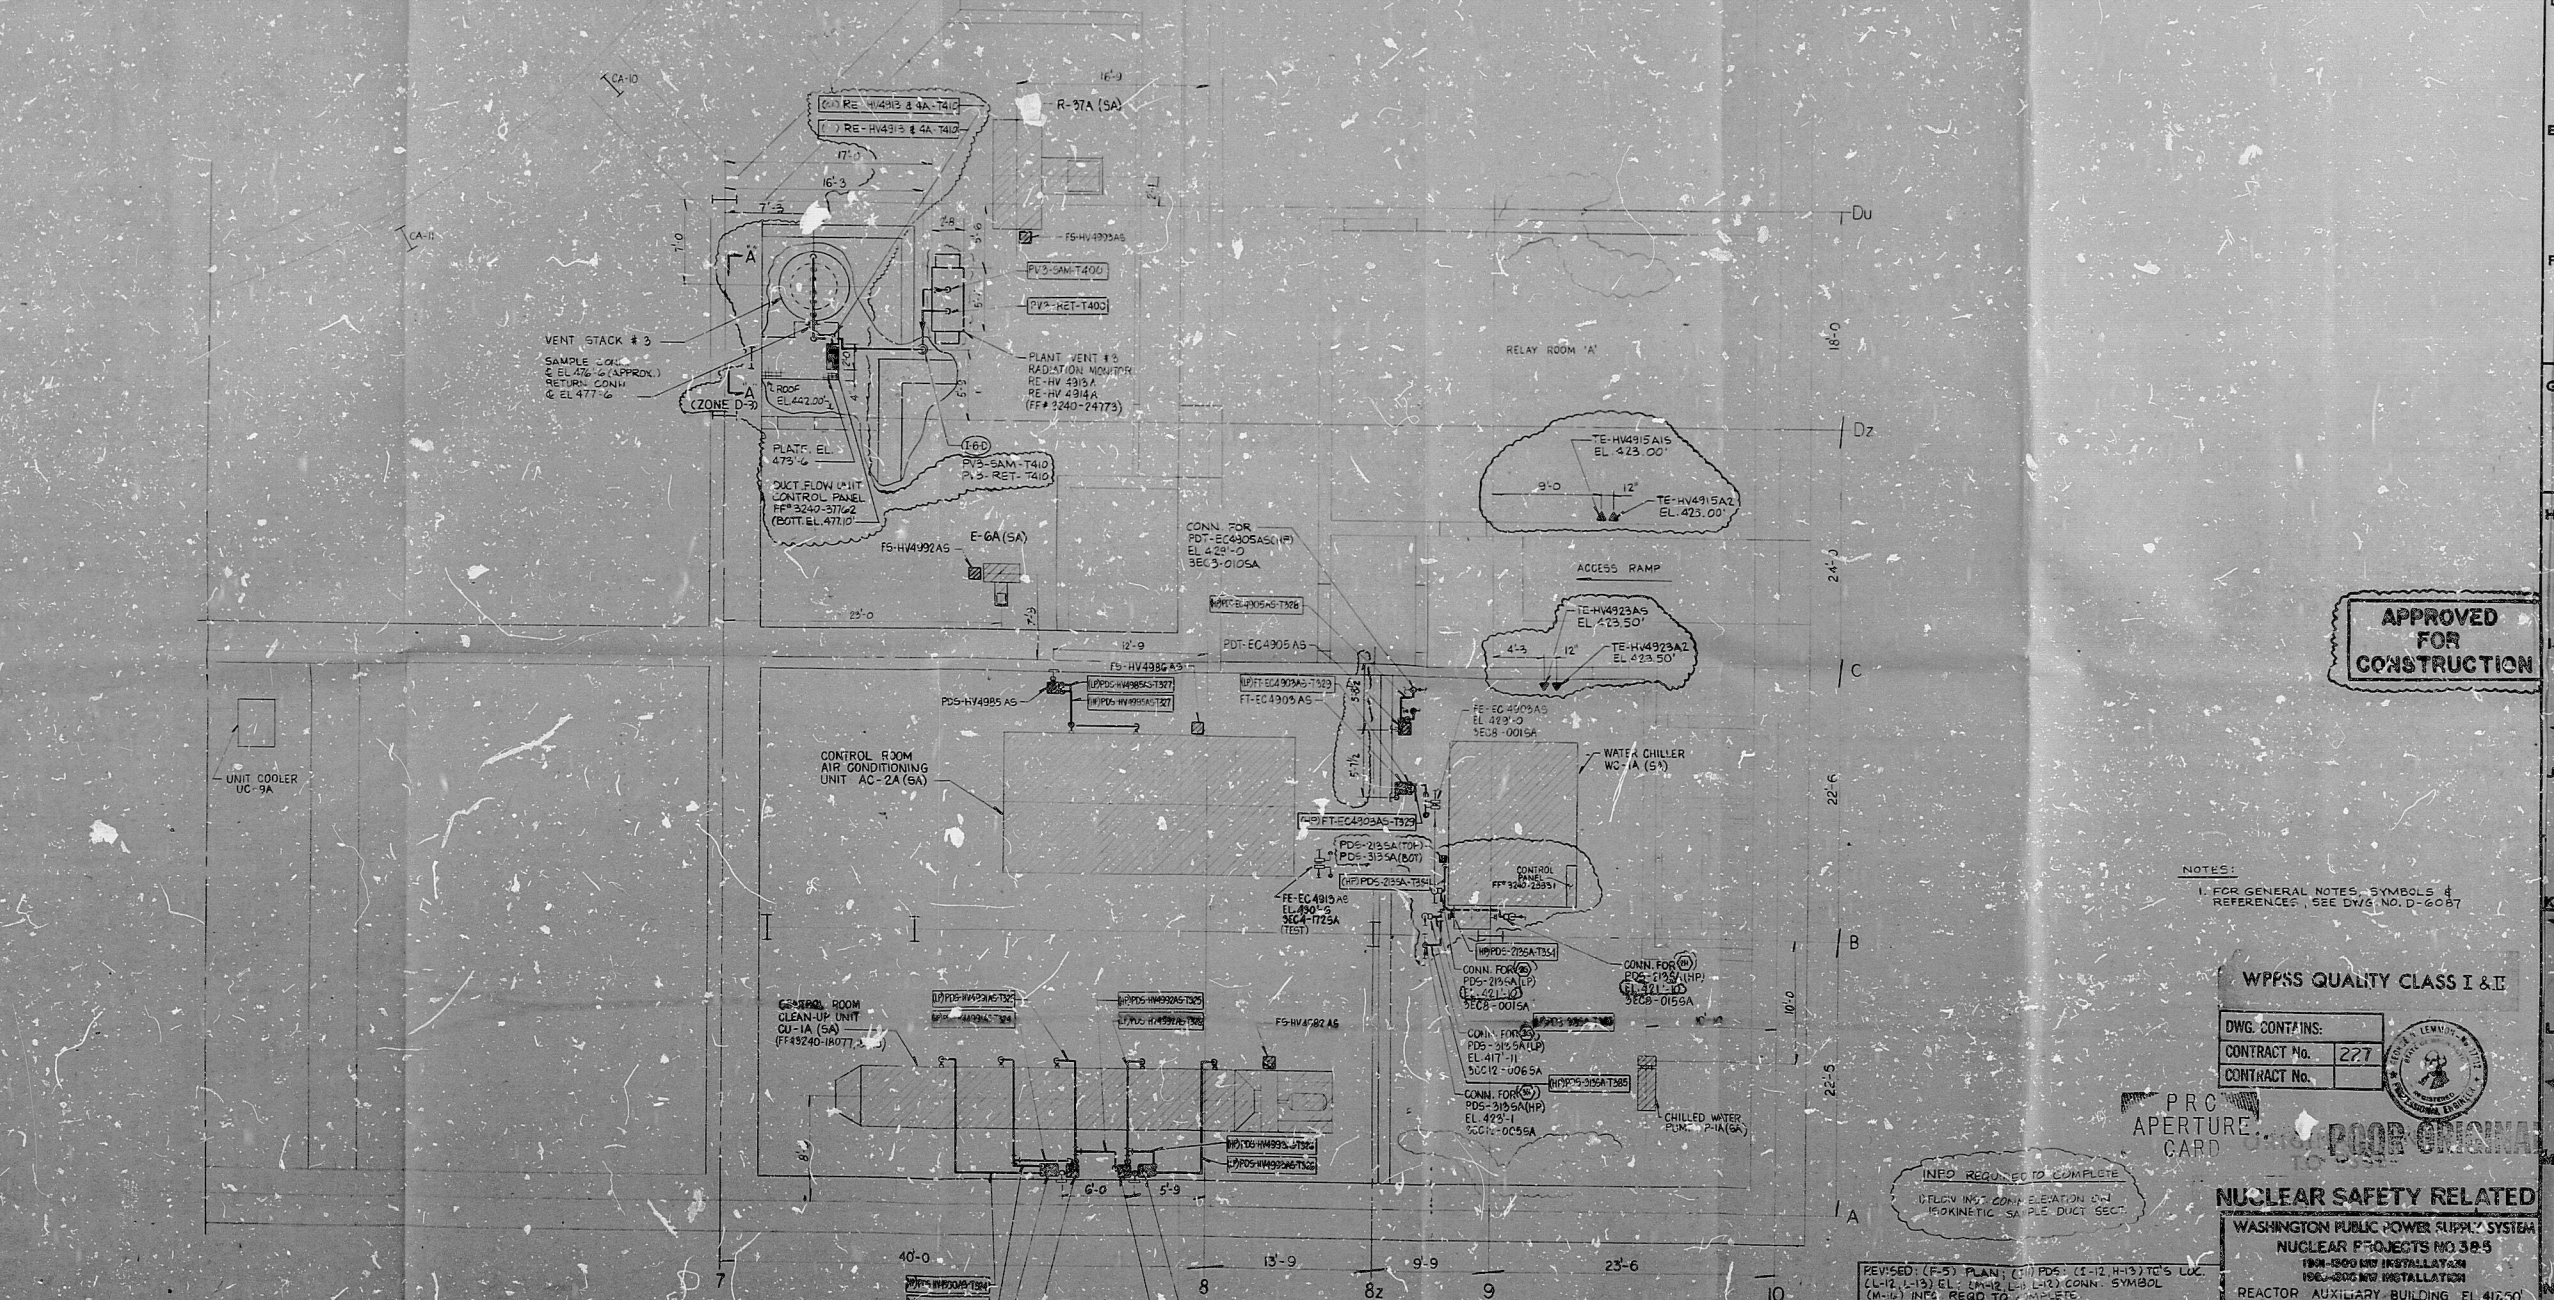
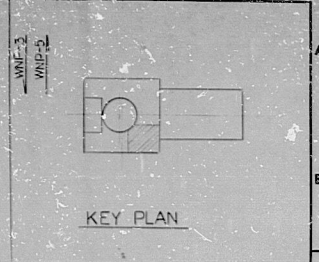
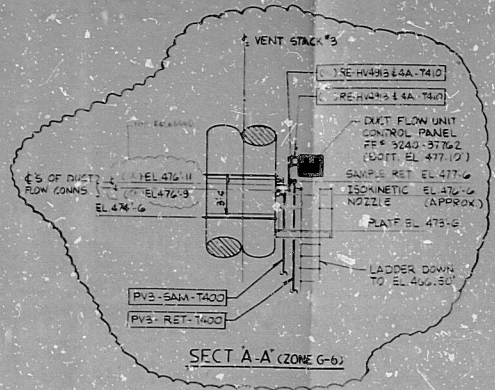


WPPS-3240-G-6507

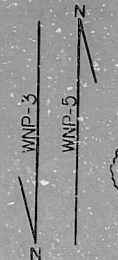

APPROVED FOR CONSTRUCTION

NOTES:
1. FOR GENERAL NOTES, SYMBOLS & REFERENCES, SEE DWG. NO. D-6057

WPPSS QUALITY CLASS I & II

DWG. CONT'NS:
CONTRACT No. 277
CONTRACT No.



PRO APERTURE CARD

NUCLEAR SAFETY RELATED

WASHINGTON PUBLIC POWER SUPPLY SYSTEM
NUCLEAR PROJECTS NO. 38.5
REACTOR AUXILIARY BUILDING EL. 412.0
HVAC SYSTEM - INST. LOCATION ARRGT. SH. 7

REVISED (P-5) PLAN; CHG. PVS (1-12) HHS-11'S LOC. (1-12, 1-13) EL. 1 PLATE (1-13) CONN. SYMBOL (M-13) INFO. REQ. TO SUPPLEMENTS
ADDED (1-10) REC. (1-10) HHS-11'S (1-10) SECT. (1-10) DIM. DELETED (P-5) SAFETY RELATED SYMBOL FROM EQUIP.

22"
17"
11"
5"
18"
11"
8.5"
11"
17"
22"

RIDS

8303030229

