
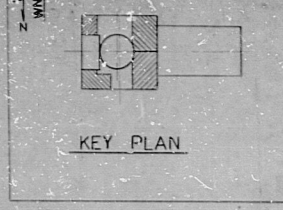


34

34

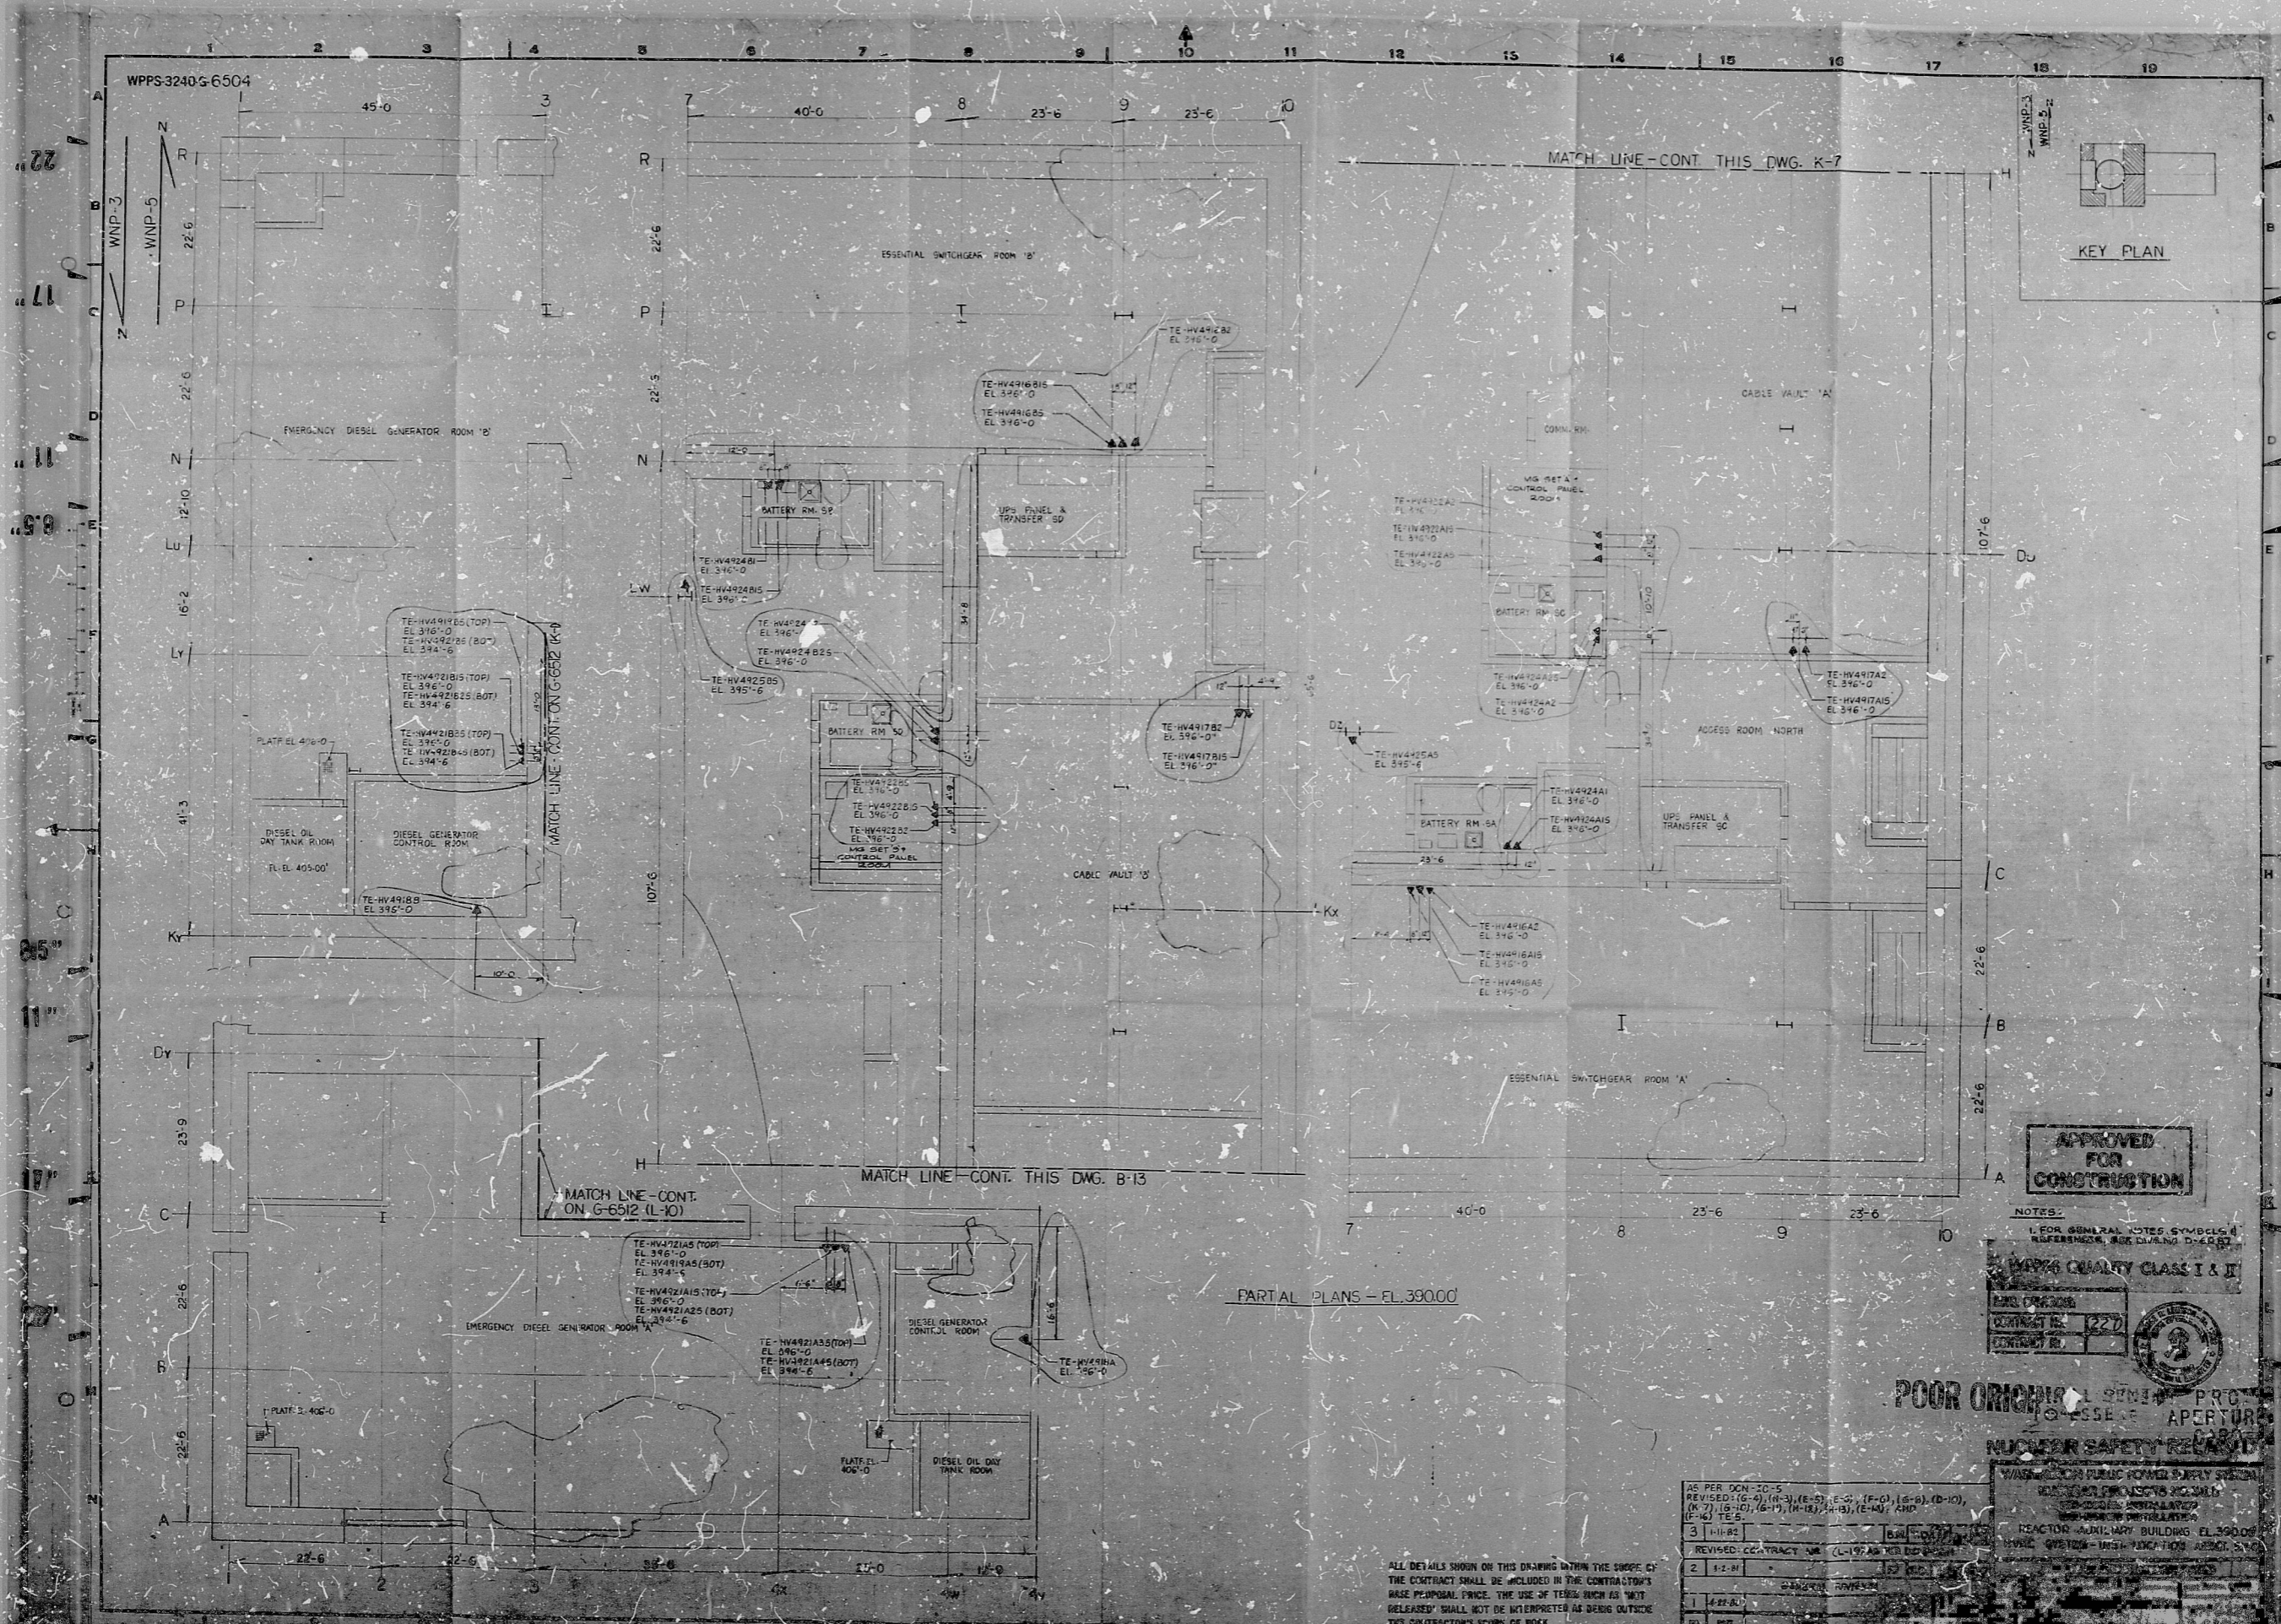

MATCH LINE - CONT. ON G-6512 (L-10)

MATCH LINE - CONT. THIS DWG. B-13

MATCH LINE - CONT. THIS DWG. K-7

PARTIAL PLANS - EL. 390.00

APPROVED FOR CONSTRUCTION

NOTES:
 1. FOR GENERAL NOTES SYMBOLS & REFERENCES, SEE DRAWING D-4002.
WPPSS QUALITY CLASS I & II
 CONTRACT NO. (22)
 COMPANY NO.

POOR ORIGINAL DESIGN PROCEDURE APERTURE
NUCLEAR SAFETY RELATED

AS PER DCN 30-5	DATE
REVISED (G-4), (H-3), (E-5), (E-6), (F-0), (G-8), (D-10), (R-7), (B-10), (6-11), (H-12), (H-13), (E-14), AND (E-15)	DATE
3 11-82	DATE
2 1-1-81	DATE
1 4-1-80	DATE

ALL DETAILS SHOWN ON THIS DRAWING WITHIN THE SCOPE OF THE CONTRACT SHALL BE INCLUDED IN THE CONTRACTOR'S BASE CONTRACT PRICE. THE USE OF TERMS SUCH AS "NOT RELEASED" SHALL NOT BE INTERPRETED AS BEING OUTSIDE THE CONTRACTOR'S SCOPE OF WORK.

34

RIDS

8303030239 05

