


J-05-0 SHT. 2

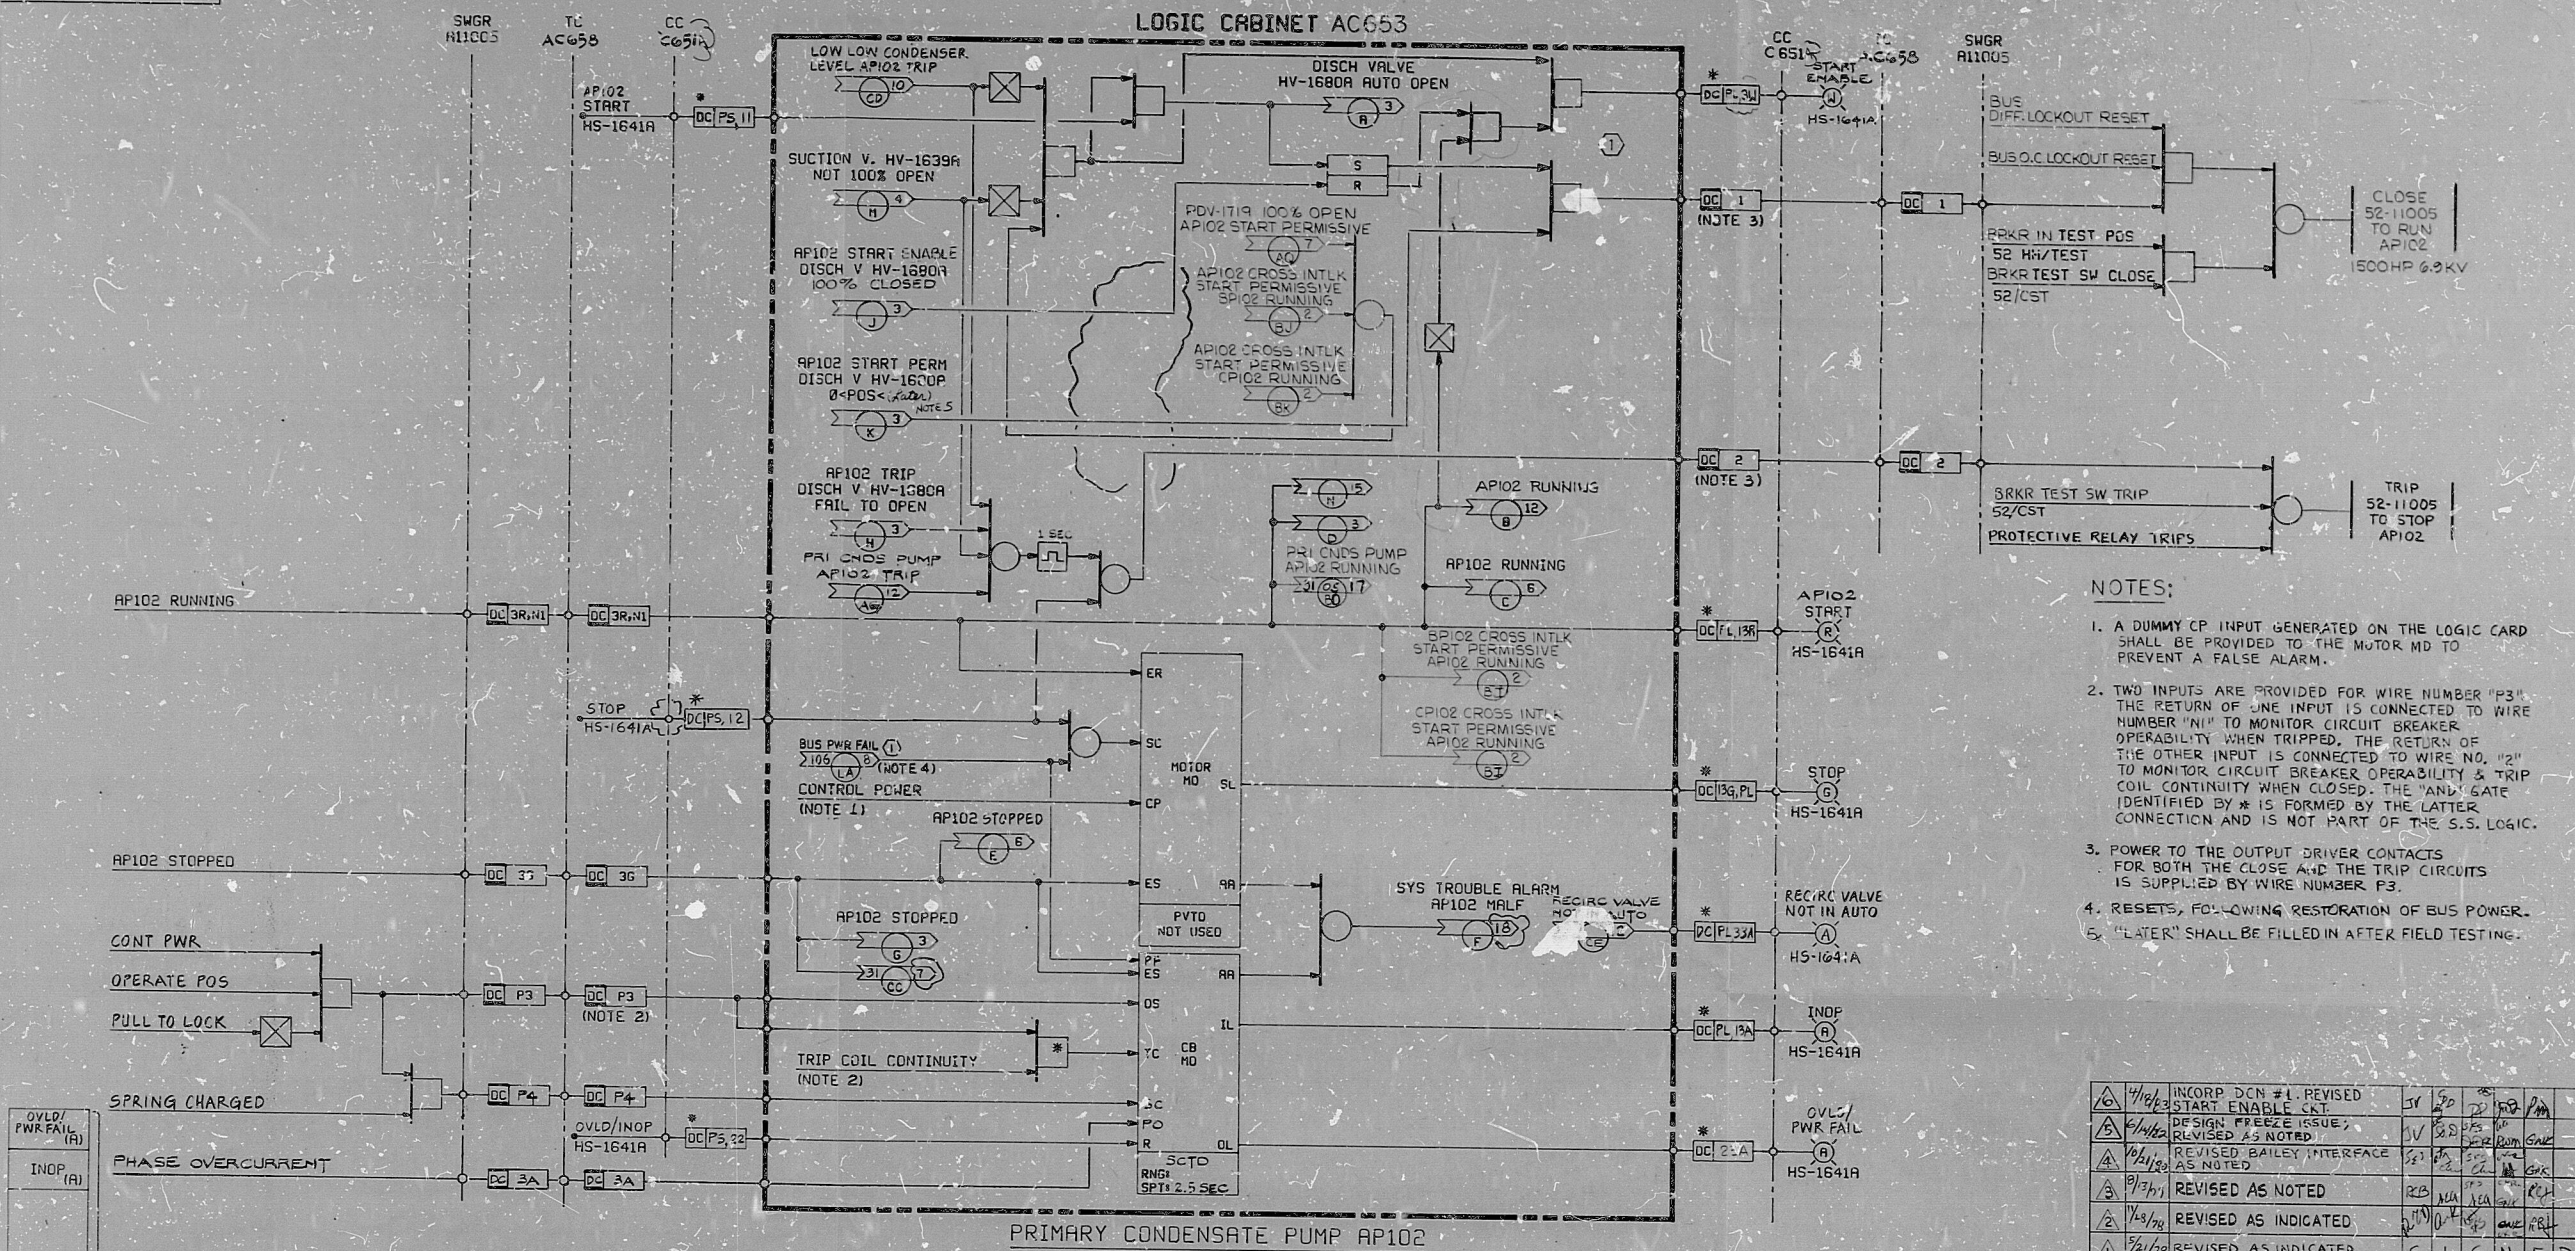

OVLD/ PWR FAIL (R)
INOP (R)
RECIRC VALVE NOT IN AUTO (A)
START ENABLE, (A)
AP102 START (A)
STOP (S)
MOMENTARY

CROSS REFERENCE TABLE

PUMP NO.	HAND SWITCH	DISCH. VALVE NO.	SUCTION VALVE NO.	BRKR NO.	SWGR.	TERMINATION CABINET	LOGIC CABINET	BUS PWR FAIL REF. J-106-0	CIRCUIT NO.	VOLTAGE	PLMP CROSS INTERLOCK START PERMISSIVE OUTPUT	RECIRC VALVE NOT IN AUTO
AP102	HS-1641A	HV-1639A	HV-1639A	52-11005	A11005	AC658	AC653	LA, SHT. 8	1	6.9KV	ARROW BI	ARROW V CE
BP102	HS-1641B	HV-1639B	HV-1639B	52-12005	A12005	BC658	BC653	MA, SHT. 8	2	6.9KV	ARROW BJ	CF
CP102	HS-1641C	HV-1639C	HV-1639C	52-10208	A10208	CC658	CC653	KE, SHT. 7	3	4.0KV	ARROW BK	CG

PRO APERTURE CARD

SCALE NONE		DESIGNED J.V.	CHECKED R.C.B.			
BECHTEL SAN FRANCISCO PUBLIC SERVICE ELECTRIC AND GAS COMPANY HOPE CREEK GENERATING STATION LOGIC DIAGRAM CONDENSATE SYSTEM PRIMARY CONDENSATE PUMPS						
JOB No.	DRAWING No.	REV.				
10855	J-05-0 SHT. 2	6				

S/U - AD

PDR RIDS

84Φ2Φ2ΦΦ6Φ

