



34"

34"

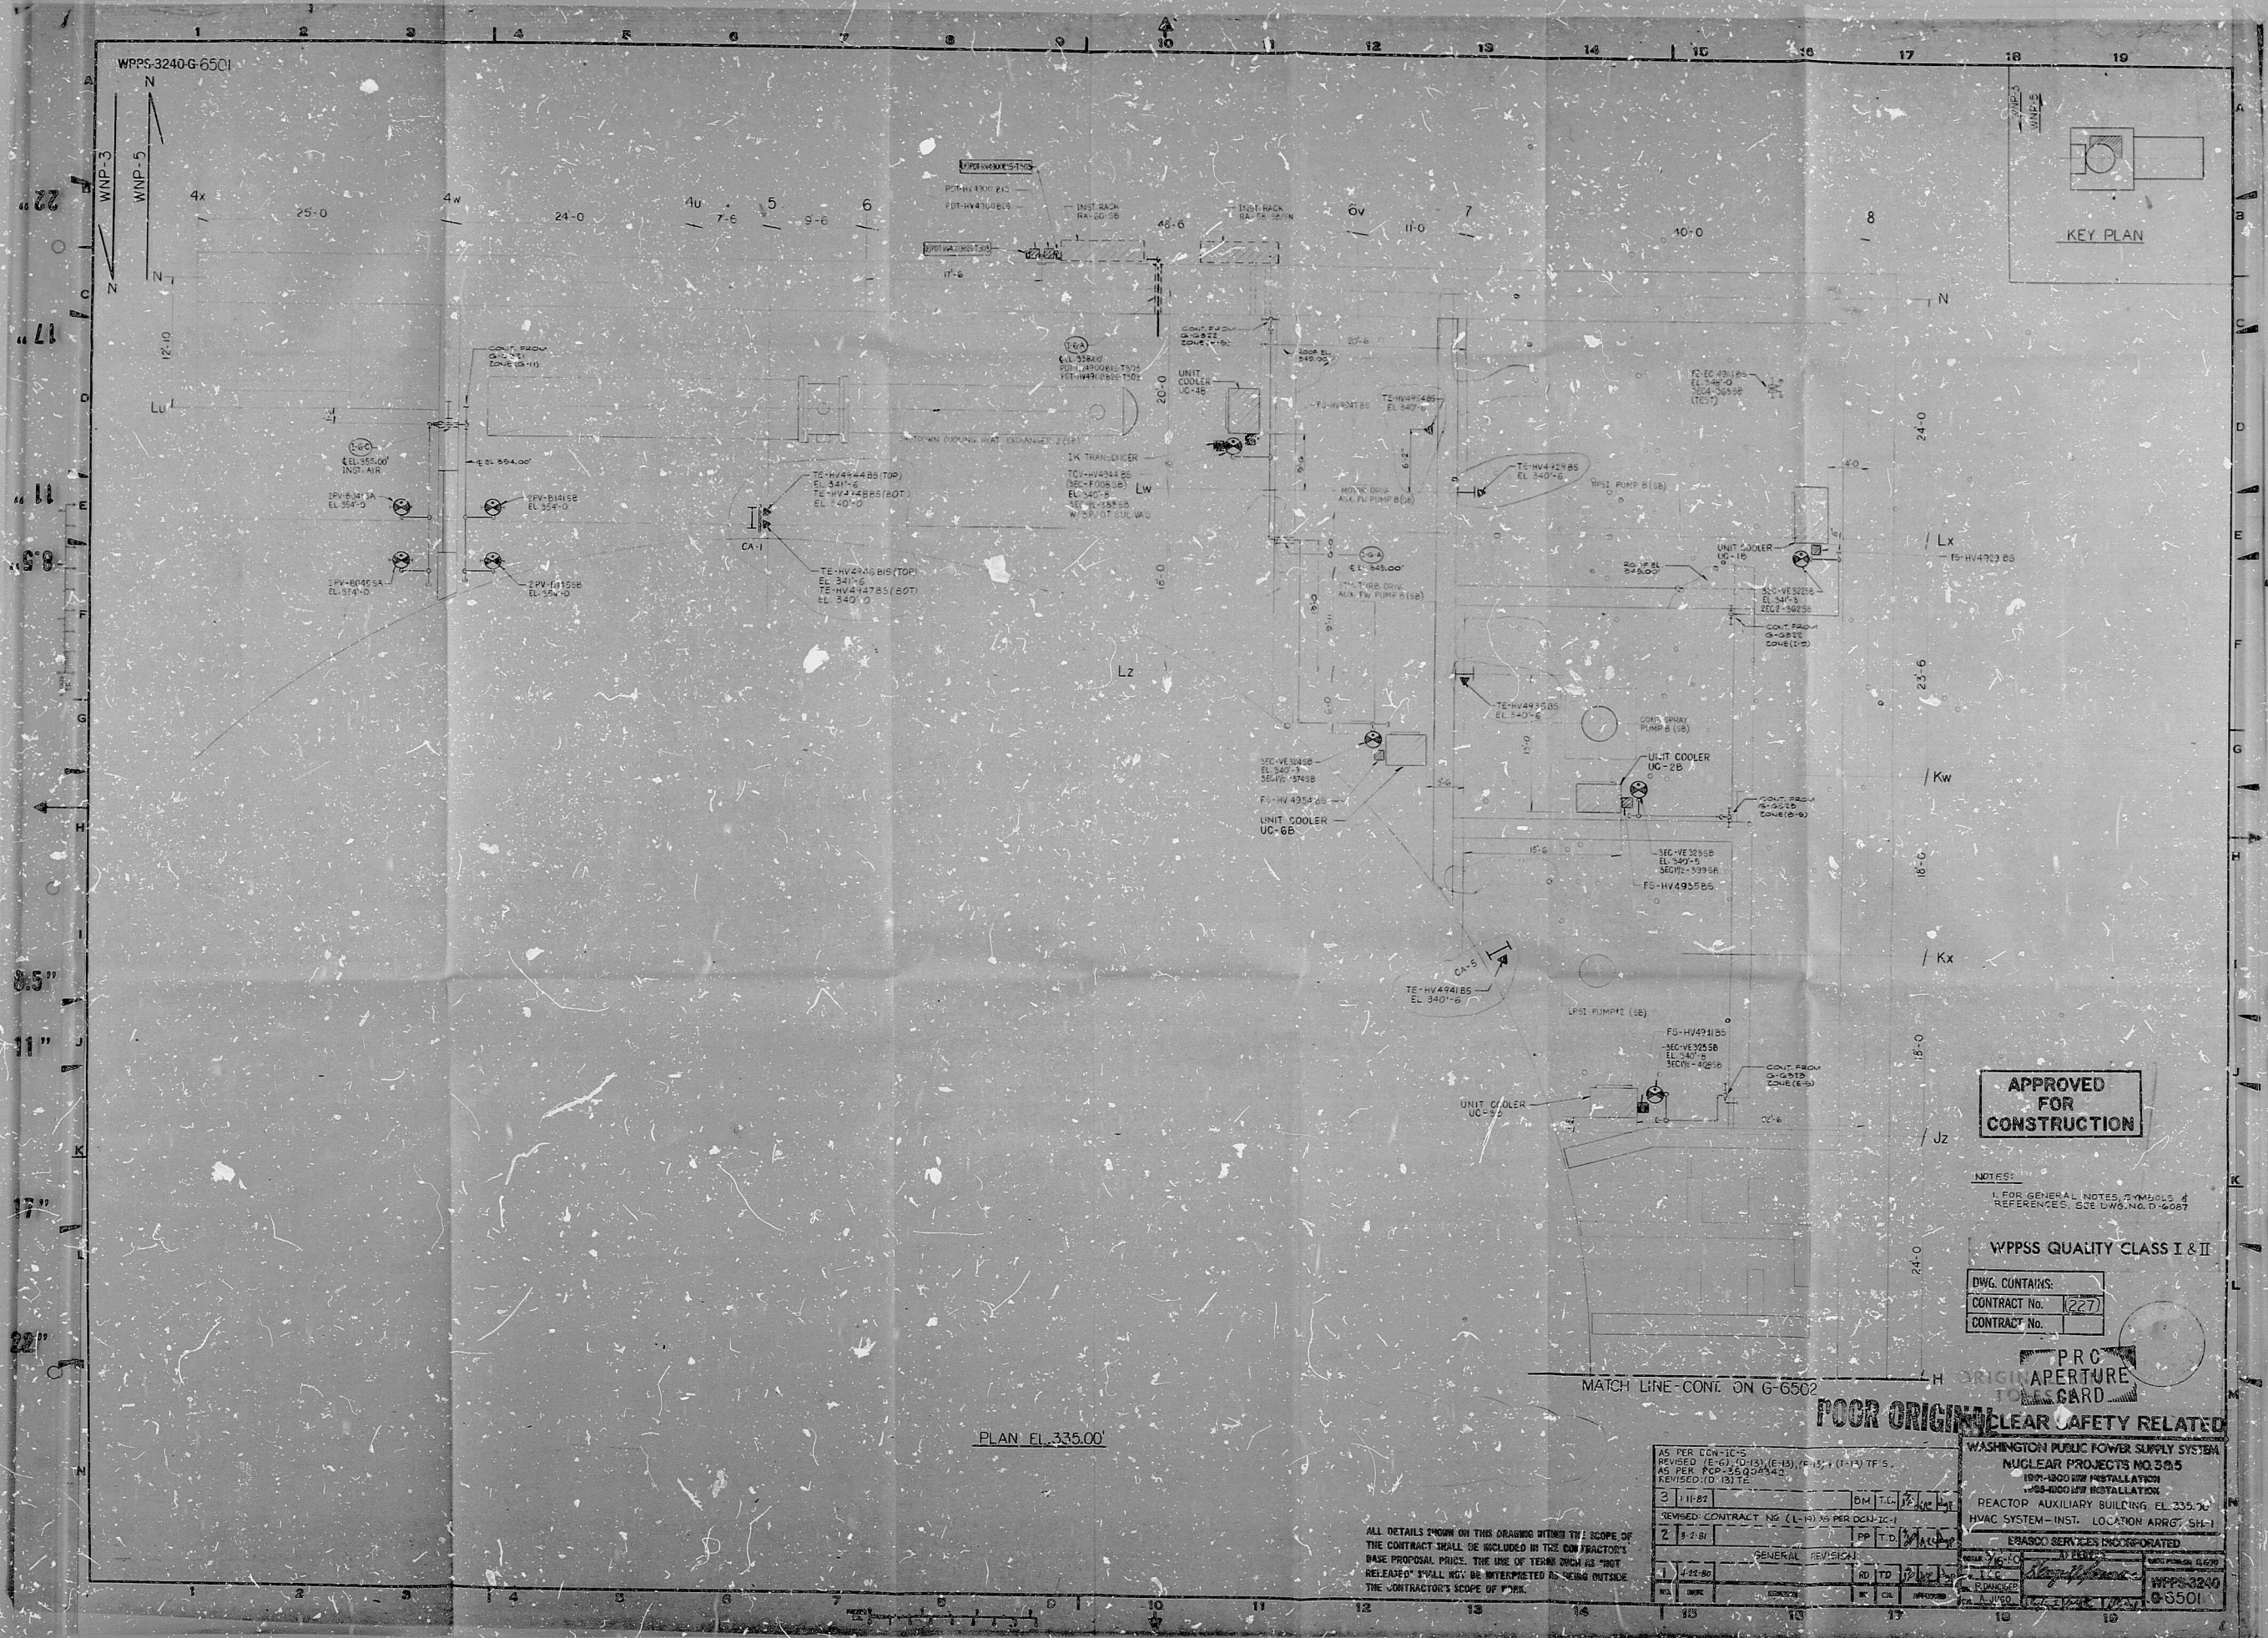

PLAN EL. 335.00'

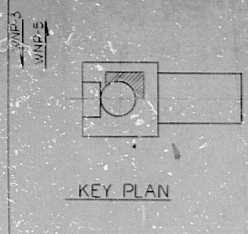

**APPROVED FOR CONSTRUCTION**

NOTES:  
1. FOR GENERAL NOTES, SYMBOLS & REFERENCES, SEE DWG. NO. D-6087

WPPSS QUALITY CLASS I & II

DWG. CONTAINS:  
CONTRACT No.

FOR ORIGINAL APERTURE TO BE MADE TO THIS CARD

**POOR ORIGINAL CLEAR SAFETY RELATED**

AS PER CONTRACTS	REVISED (E-G) 10-13 (E-13) 10-15 (E-15) 11-5
AS PER PCP-250-00942	REVISED (D) 13-75
3 11-82	DM T.C. J.C. H.L.
2 1-2-81	FP T.D. M.C. H.L.
1 1-22-80	GENERAL REVISION
NO. DATE	BY CHK. APPROVED BY

WASHINGTON PUBLIC POWER SUPPLY SYSTEM  
 100%-100% NEW INSTALLATION  
 100%-100% NEW INSTALLATION  
 HVAC SYSTEM - INST. LOCATION ARRGT. SHEET  
 EBASCO SERVICES INCORPORATED  
 WPPSS-3240  
 G-6501

ALL DETAILS SHOWN ON THIS DRAWING WITHIN THE SCOPE OF THE CONTRACT SHALL BE INCLUDED IN THE CONTRACTOR'S BASE PROPOSAL PRICE. THE USE OF TERMS SUCH AS "NOT RELEASED" SHALL NOT BE INTERPRETED AS BEING OUTSIDE THE CONTRACTOR'S SCOPE OF WORK.

34"

34"



RIDS

8303030249

