
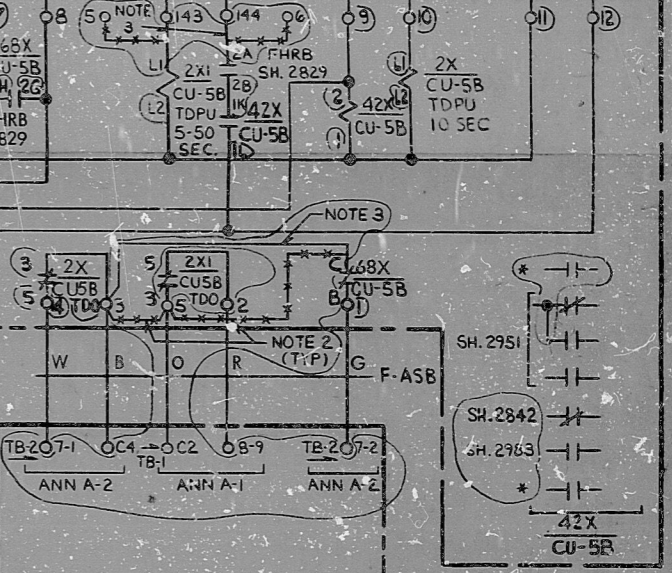


CONTACT	POSITION FRONT VIEW		CWD
	STOP	AUTO START/DRIVE	
1		X	*
2	X		*
3		X	*
4	X	X	*

CS: SPRING RETURN TO AUTO
* THIS SHEET

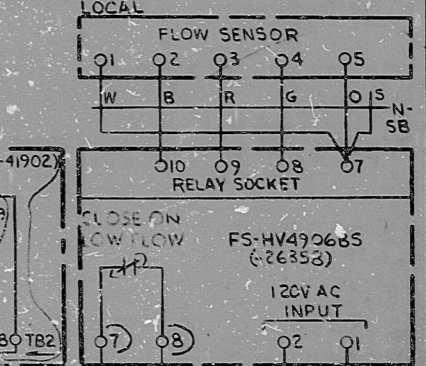

- NOTES
1. FOR TRANSFER SW TS11-1 DEVELOPMENT SEE SH. 2112
 2. *** FIELD TO DISCONNECT.
 3. FIELD TO WIRE.
 4. CONTACT CLOSES ON HIGH DIFF. PRESSURE.

NUCLEAR SAFETY RELATED WPPSS QUALITY CLASS I

EBASCO SERVICES INCORPORATED DIV. CONTROL DR. A.M. CH. V. ALKSNINIS DATE JUNE 8, 1978				WASHINGTON PUBLIC POWER SUPPLY SYSTEM NUCLEAR PROJECTS NO. 3 & 5 CONTROL WIRING DIAGRAM ECCS AREA EXHAUST CLEAN-UP UNIT CU-5B FAN				WPPS-3240 D-6001 SHEET 2850	
REV.	DATE	BY	APPROVED	APPROVED [Signature]					

DDAELE

RIDS

8303030309

