



- NOTES**
1. FOR TRANSFER SWITCH TSI DEVELOPMENT SEE SH.2112
  2. FIELD TO VERIFY SOLENOID VOLTAGE BEFORE ENERGIZING.

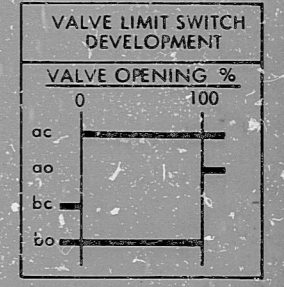

125V DC BUS  
PNL 4B-SB  
CKT 2

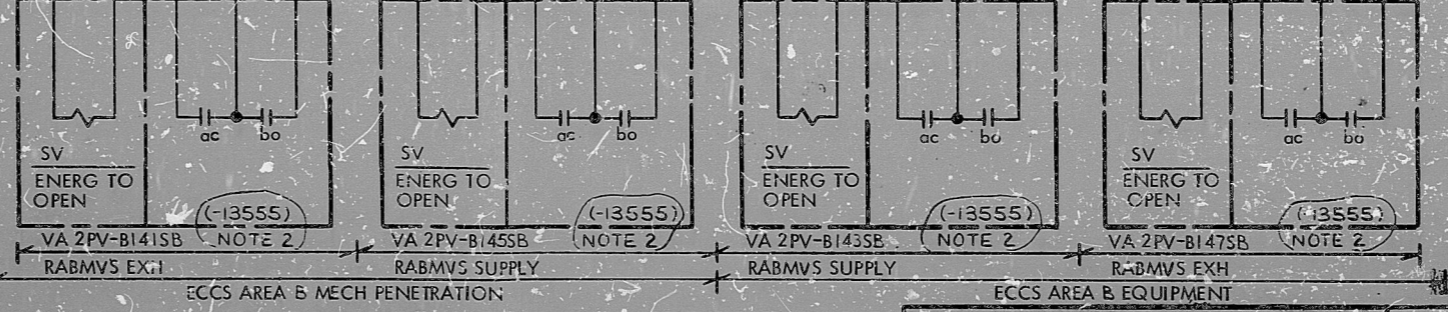

**NUCLEAR SAFETY RELATED**      **WPPSS QUALITY CLASS I**

REV.	DATE	BY	APPROVED
3	6-7-82	CV	VA
2	9-11-81	CV	VA
1	4-10-79	VT	VA

**EBASCO SERVICES INCORPORATED**

DIV. CONTROL DR. A.M.  
CH. V. ALKSNINIS

DATE JUNE 8, 1978

WASHINGTON PUBLIC POWER  
SUPPLY SYSTEM

NUCLEAR PROJECTS NO. 3 & 5  
CONTROL WIRING DIAGRAM

ECCS AREA B RABMVS ISO  
VA 2PV-B141SB, B143SB, B145SB, B147SB

**WPPSS-3240**

**D-6001**

**SHEET 285B**

**PRC APERTURE CARD**

RIDS

8303030327

