


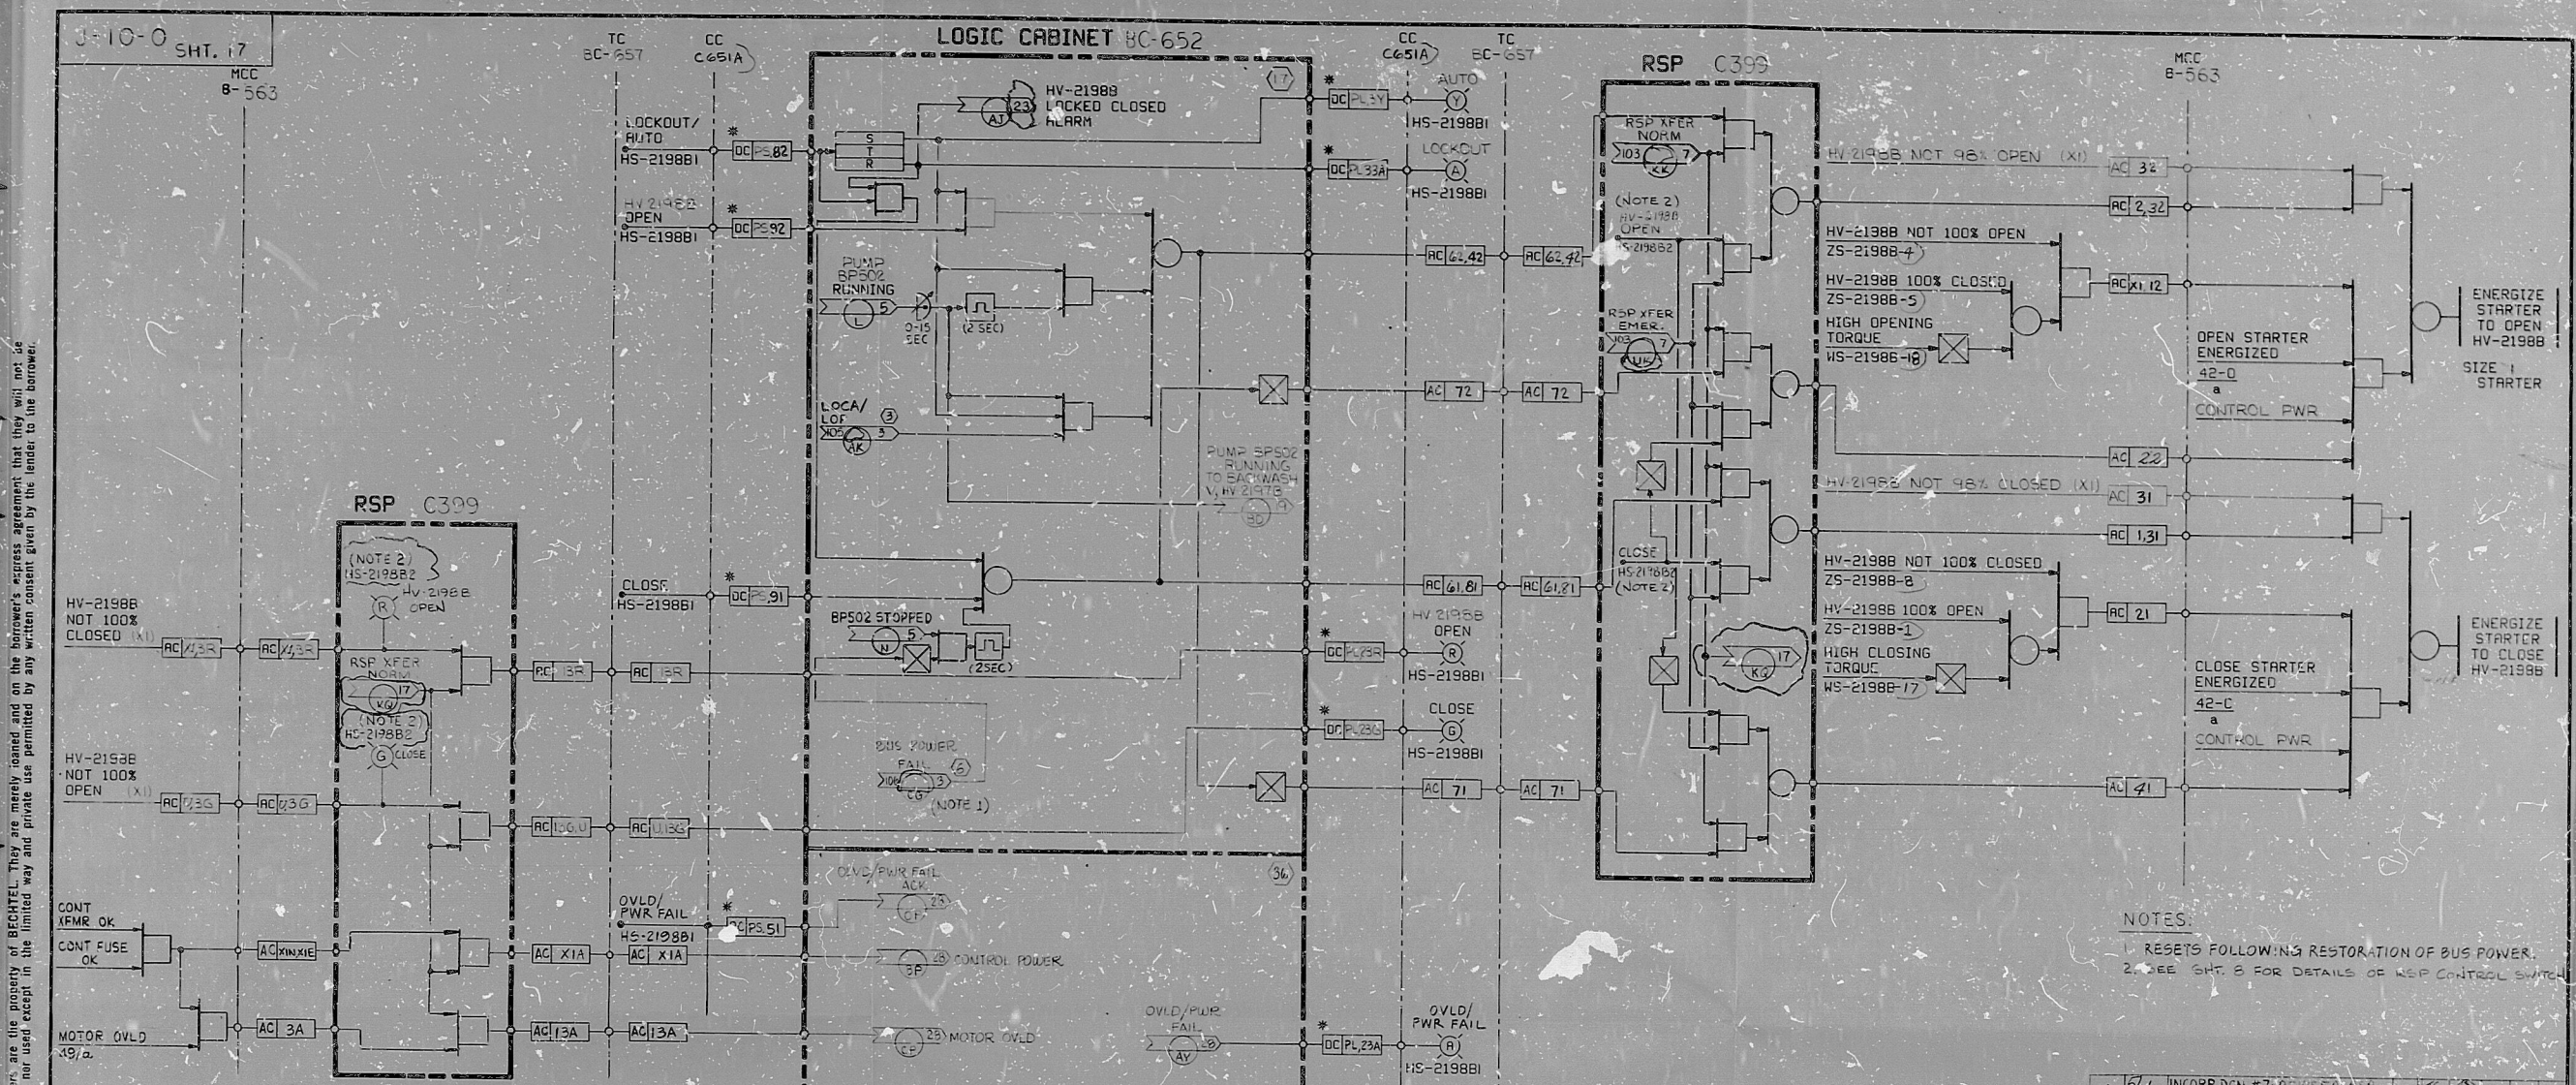

NOTES:

1. RESETS FOLLOWING RESTORATION OF BUS POWER.

2. SEE SHT. B FOR DETAILS OF RSP CONTROL SWITCH.

CROSS REFERENCE TABLE

SERVICE	SEWS PUMP	DISCH. V.	CONTROL SW.	POSITION SW.	TORQUE SW.	CC	LOGIC CAB.	TC	RSP	MCC	CLASS 1E CHANNEL	CIRCUIT NO.	BACKWASH VALVE	BUS PWR FAIL (NOTE 1)	RSP XFER NORM	LOCA/LOP	RSP XFER EMERG.	CIRCUIT NO. FOR OFF ARROWS	RSP XFER NORM
LOOP B PUMP DISCH	BP502	HV-21988	HS-21988-1	HS-21988-2	ZS-21988-3	WS-21988-4	C651A	BC652	BC65T	C399	B563	B	7	HV-2197B	J-106-0, SHT 3, CTG 6, ARROW 6A	ARROW KK, J105, SHT 7	J105-0, SHT 3, ARROW UK, J105, SHT 7	(36)	ARROW KQ, SHT 17
	DP502	HV-21988	HS-21988-1	HS-21988-2	ZS-21988-3	WS-21988-4	C651A	DC652	DC65T	C399	B563	D	19	HV-2197D	J-106-0, SHT 5, CTG 16, ARROW 6B	ARROW LR, J105, SHT 8	J105-0, SHT 3, ARROW VZ, J105, SHT 8	(38)	ARROW KQ, SHT 17

BECHTEL
SAN FRANCISCO

PUBLIC SERVICE ELECTRIC AND GAS COMPANY
HOPE CREEK GENERATING STATION

LOGIC DIAGRAM
STATION SERVICE WATER SYSTEM
LOOP B PUMP DISCH. VALVES

JOB No.	DRAWING No.	REV.
10855	J-10-0 SHT. 17	7 Q

S/U - ER

PDR RIDS

8402020 437

