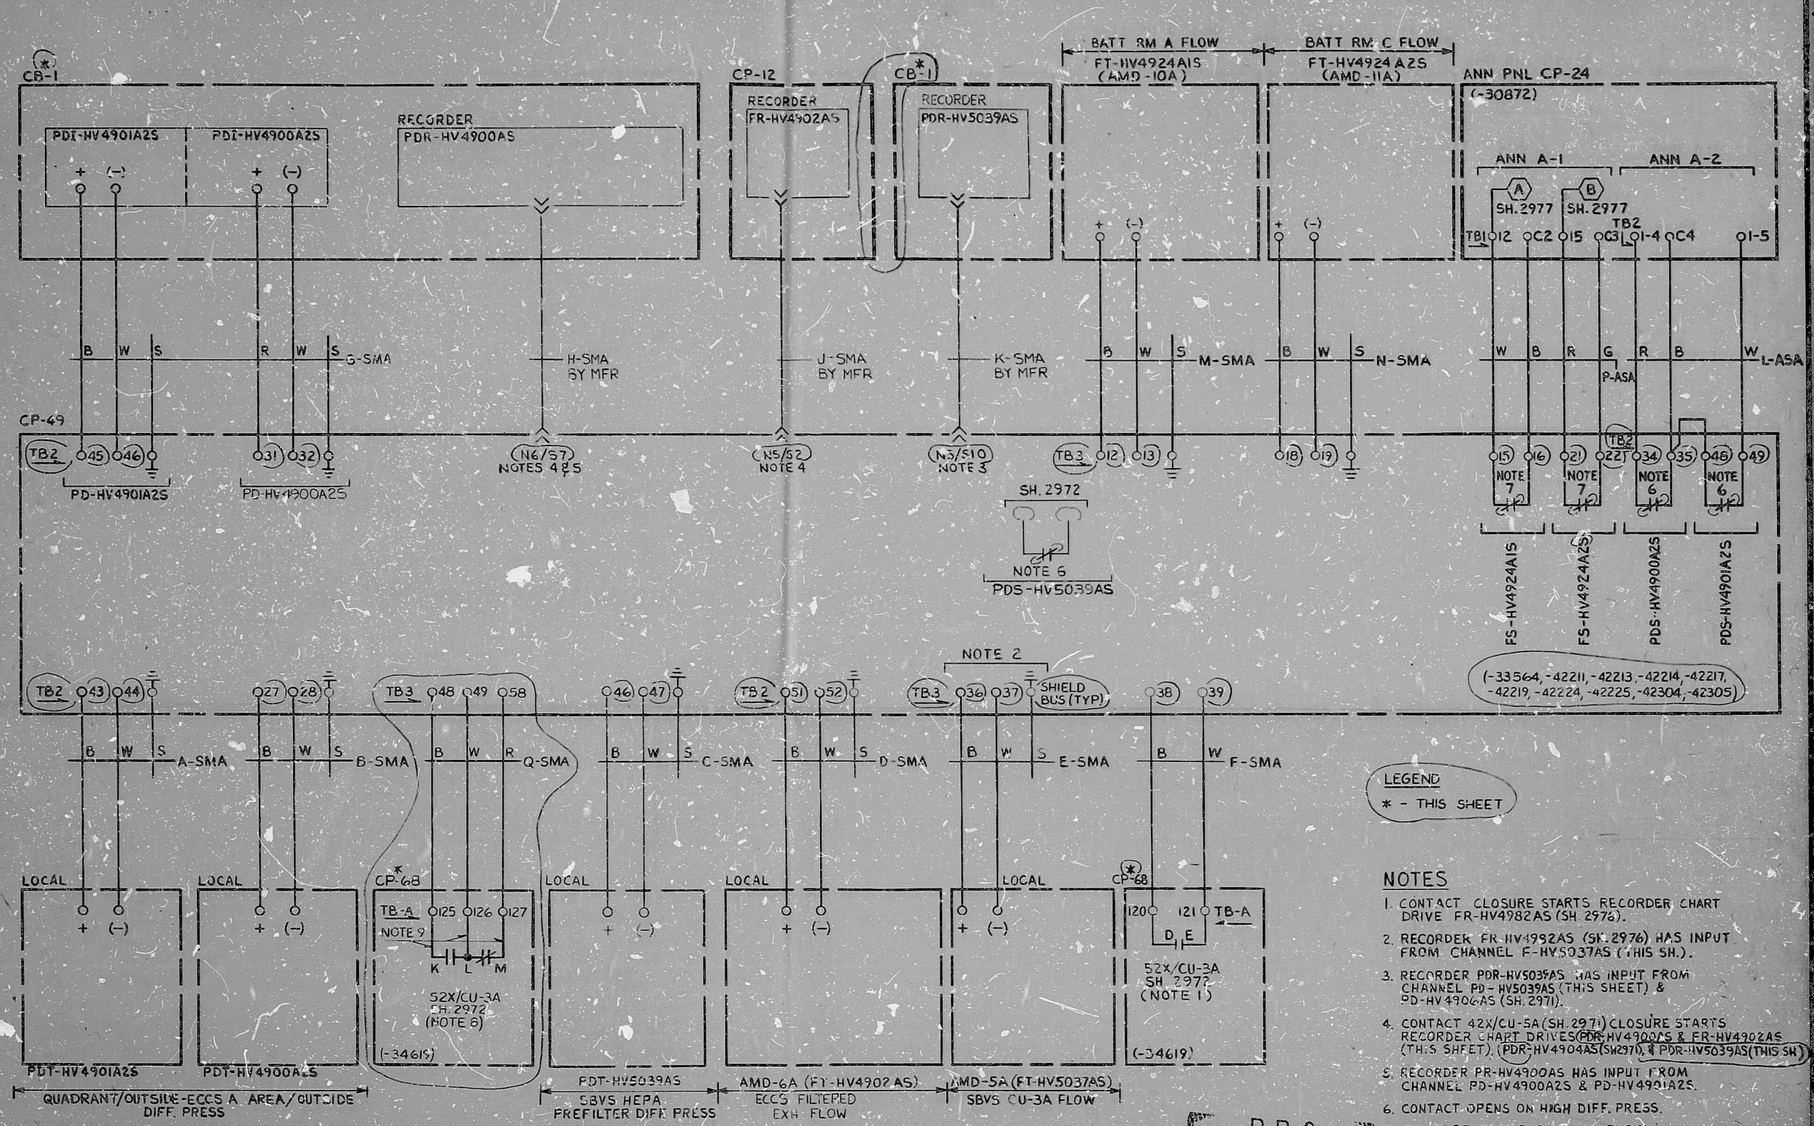

LEGEND

* - THIS SHEET

NOTES

1. CONTACT CLOSURE STARTS RECORDER CHART DRIVE FR-HV4982AS (SH. 2976).
2. RECORDER FR-HV4992AS (SH. 2976) HAS INPUT FROM CHANNEL F-HV5037AS (THIS SH.).
3. RECORDER PDR-HV5039AS HAS INPUT FROM CHANNEL PD-HV5039AS (THIS SHEET) & PD-HV4906AS (SH. 2971).
4. CONTACT 42X/CU-5A (SH. 2971) CLOSURE STARTS RECORDER CHART DRIVES (PDR-HV4900AS & FR-HV4902AS (THIS SHEET), (PDR-HV4904AS (SH. 2971), & PDR-HV5039AS (THIS SH.)
5. RECORDER PR-HV4900AS HAS INPUT FROM CHANNEL PD-HV4900A2S & PD-HV4901A2S.
6. CONTACT OPENS ON HIGH DIFF. PRESS.
7. CONTACT OPENS ON LOW FLOW.
8. CONTACT CLOSURE STARTS RECORDER CHART DRIVE PDR-HV5039AS (THIS SHEET) & BLOCKS CHART DRIVES PDR-HV4900AS & FR-HV4902AS.
9. FIELD TO WIRE.

PRC APERTURE CARD

NUCLEAR SAFETY RELATED | WPPSS QUALITY CLASS I

REV.	DATE	BY	APPROVED
5			
4	7-23-82	LB	
3	12-15-81	RJP	
2	8-7-81	RJP	
1	7-27-79		

EBASCO SERVICES INCORPORATED

DIV. CONTROL DR. PAIVA
CH. A. SEN
DATE JUN 9, 1978
APPROVED

WASHINGTON PUBLIC POWER SUPPLY SYSTEM
NUCLEAR PROJECTS NO. 3 & 5
CONTROL WIRING DIAGRAM
HVAC SA INSTRUMENTATION SH. 1

WPPS-3240
D-6001
SHEET 2970

RIDS

8303030533

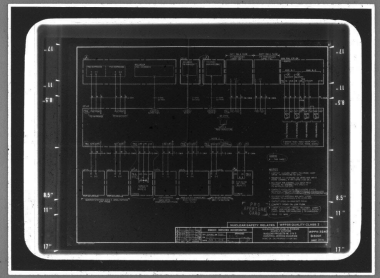

MMM 5824 — FILMSORT® Brand Aperture & Camera Cards and DUPLICARD® Brand Copy Cards — Product of 3M Company, St. Paul, Minn.