


ANN PANEL CP-79

(-30877)

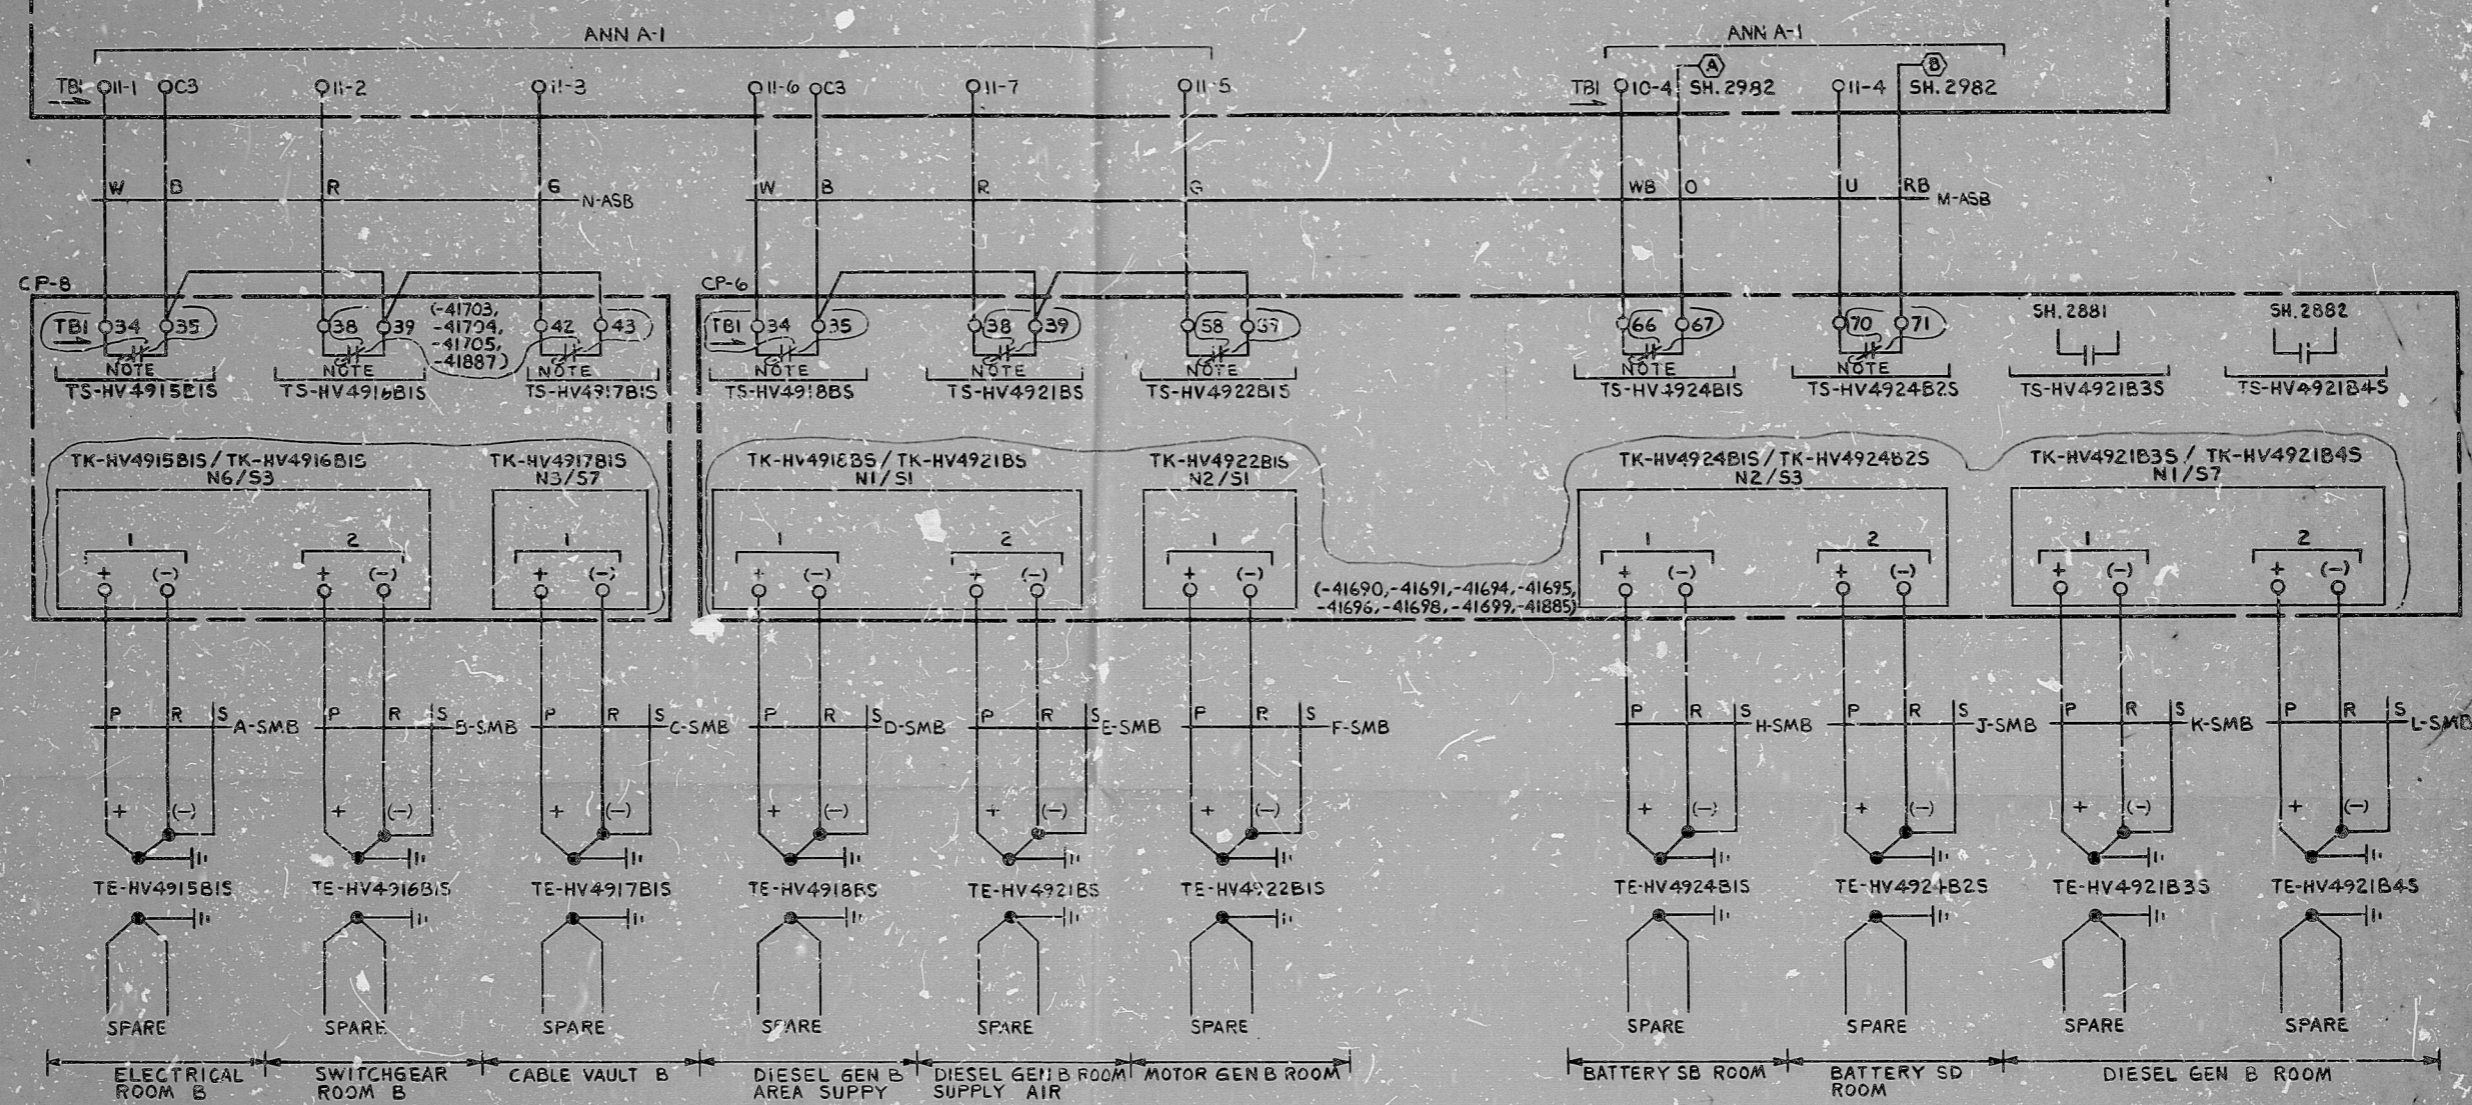

NOTE
CONTACT OPENS ON HIGH TEMP.

PRC
APERTURE
CARD

NUCLEAR SAFETY RELATED | WPPSS QUALITY CLASS I

<table border="1"> <tr> <td>5</td> <td></td> <td></td> <td></td> </tr> <tr> <td>4</td> <td>3-26-82</td> <td>RJF</td> <td>VA</td> </tr> <tr> <td>3</td> <td>12-15-81</td> <td>RJF</td> <td>VA</td> </tr> <tr> <td>2</td> <td>10-29-81</td> <td>PJ</td> <td>VA</td> </tr> <tr> <td>1</td> <td>7-22-81</td> <td>PW</td> <td>VA</td> </tr> <tr> <td>REV</td> <td>DATE</td> <td>BY</td> <td>APPROVED</td> </tr> </table>				5				4	3-26-82	RJF	VA	3	12-15-81	RJF	VA	2	10-29-81	PJ	VA	1	7-22-81	PW	VA	REV	DATE	BY	APPROVED	EBASCO SERVICES INCORPORATED DIV. CONTROL DR. C. K. CH. A. SEN DATE JUN 9, 1978		WASHINGTON PUBLIC POWER SUPPLY SYSTEM NUCLEAR PROJECTS NO. 3 & 5 CONTROL WIRING DIAGRAM HVAC SB INSTRUMENTATION SH. 8		WPPSS-3240 D-6001 SHEET 2989	
5																																	
4	3-26-82	RJF	VA																														
3	12-15-81	RJF	VA																														
2	10-29-81	PJ	VA																														
1	7-22-81	PW	VA																														
REV	DATE	BY	APPROVED																														

11

11

11

8.5"

11"

17"

RIDS

8303030581

