


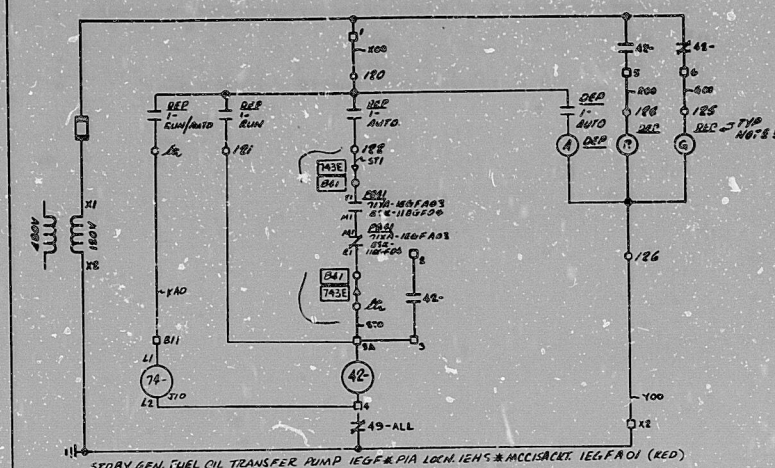

#1 | 2 #2 SPARE
 #3 | 4 #4 ALARM 0379
 ESK-10ANN38
 #5 | 6 #6 AMBES LT.
 ESK-75C03
 #7 | 8 #8 SPARE
 74-

NOTES
1. ALL EQUIPMENT LOCATED AT MCC
UNLESS OTHERWISE NOTED.
2. LOGIC DIAG LSK-8-9-2
3. REFER TO DELVAL DWS
OO-500-74039 & OO-500-74039
54 & 069. FOR DEVICES AT DEP
FURNISHED BY DELVAL.

TERA
APERTURE
CARD

NUCLEAR SAFETY RELATED
QA CAT. I, II

ELEM DIAG-480V CONT CKT
RIVER BEND STATION-UNIT I
GULF STATES UTILITIES COMPANY
A12210-ESK-6EGF01

<u>C9</u>	<u>DETAIL</u>	<u>ASK</u>	<u>SPARES</u>	<u>USED</u>
1-186FA01	- BY DELAVAL SEE NOTE 3			

DESIGN CHANGE IN PROGRESS REISSUE REQUIRED FOR FSAR

SEPIA COPY

22"

RIDS

8109250306

