

22"

17"

11"

8.5"

11"

17"

22"

34"

22"

17"

11"

8.5"

11"

17"

22"

34"

22"

17"

11"

8.5"

11"

17"

22"

34"

22"

17"

11"


8.5"

11"

17"

22"

34"

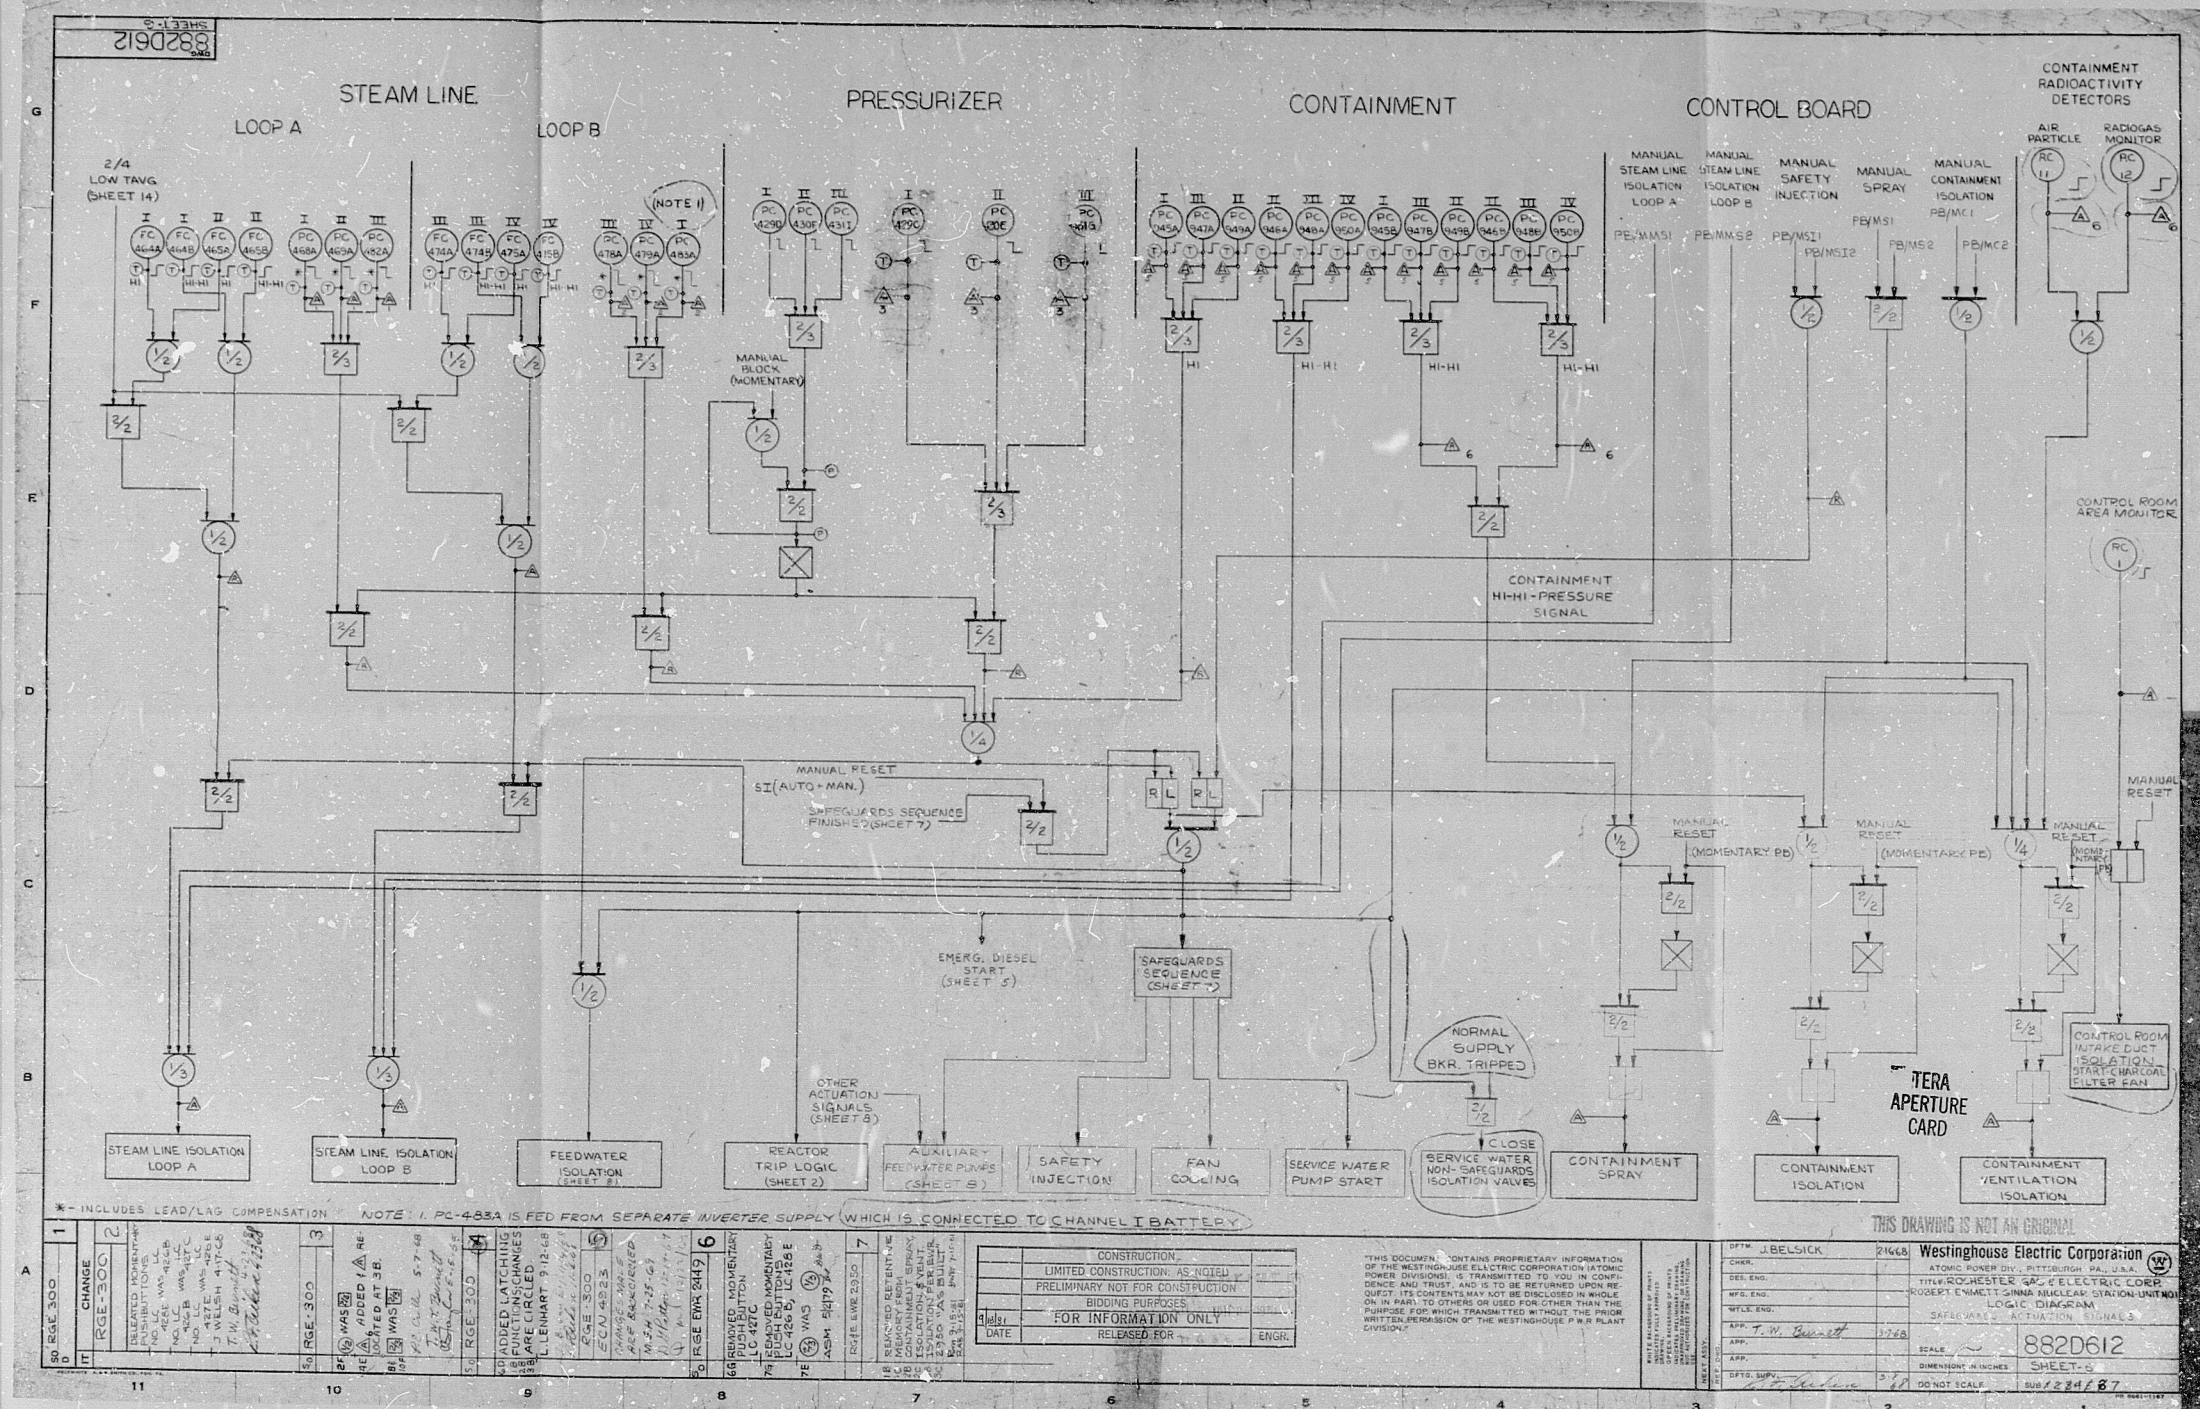

8104250378



Rips

8109250378

