


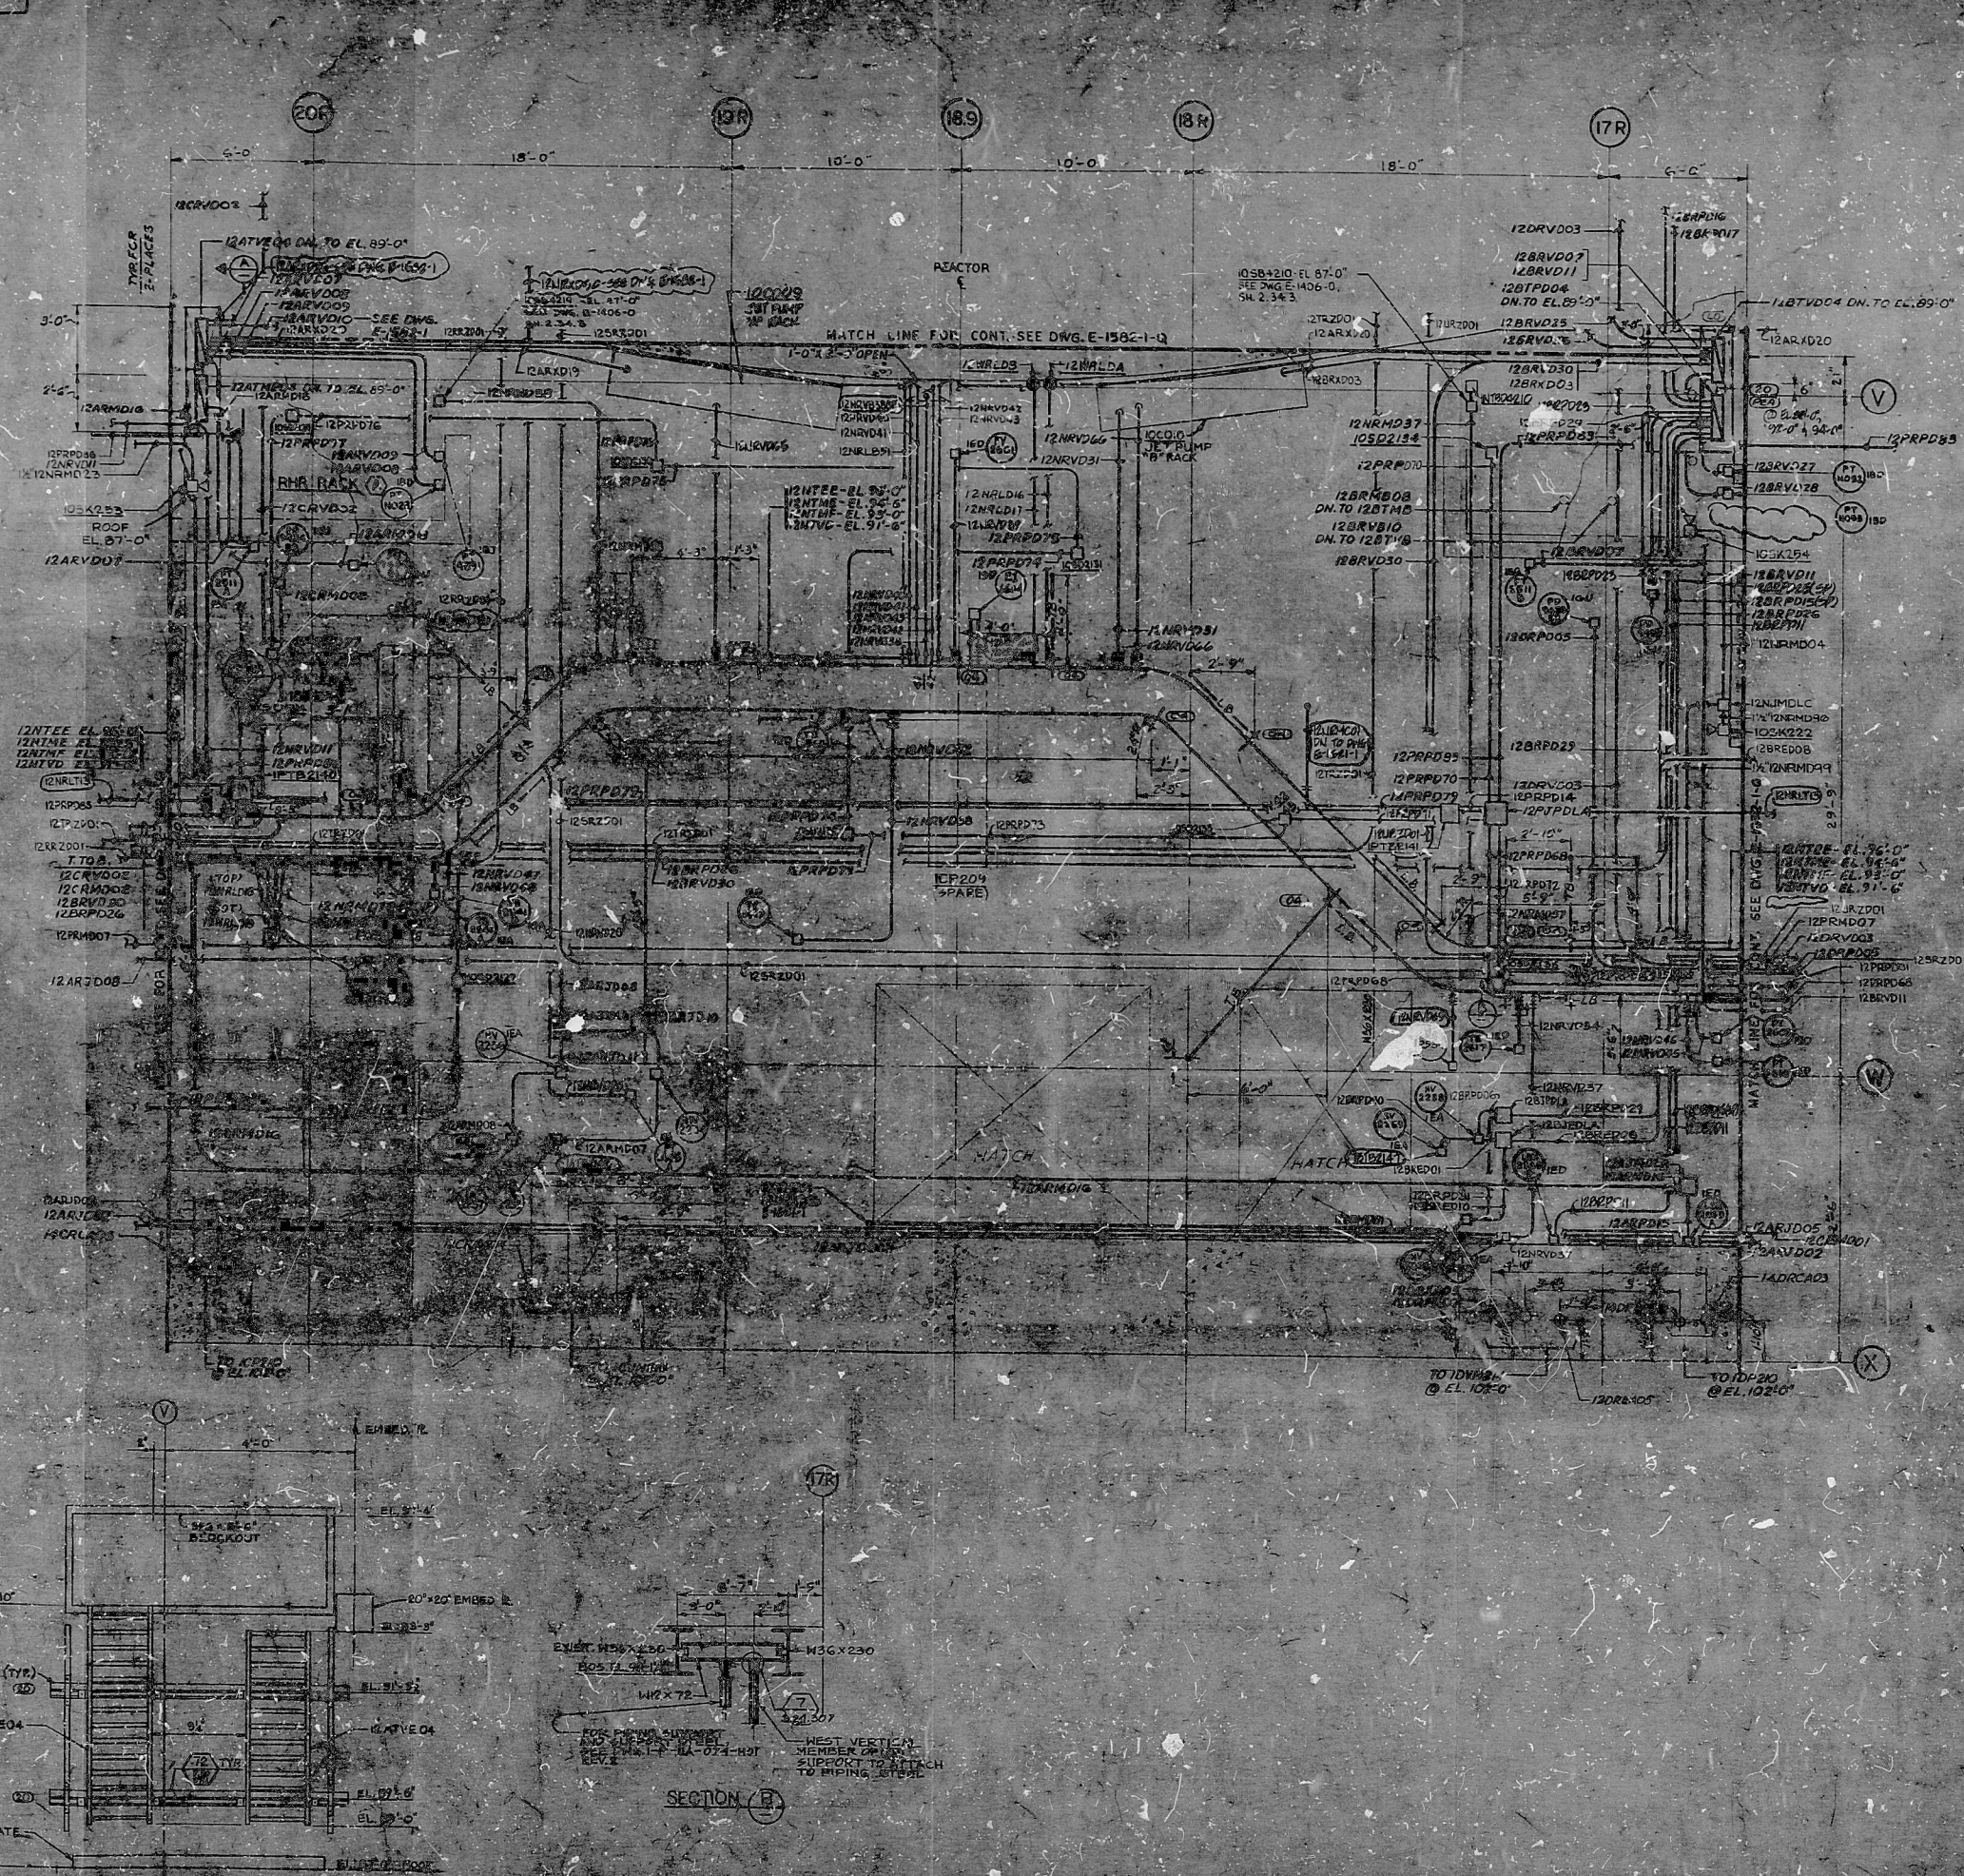

02	12	40	61	54	82	09	04
03	47	49	69	65	57	33	68
05	01	08	09	12	11	16	08
06	28	29	25	31	28	22	21
10	57	70	72	73	72	72	71
08	04	07	13	20	16	14	13
09	07	03	68	30	18	17	10
11	09	03	87	77			
01	64	59	21	20	21	20	20
04	07	02	09	20	24	23	22

NOTES:

1. ALL CABLE TRAYS ARE 24" UNLESS SHOWN OTHERWISE.
2. CLASS IE RACEWAY-TRAY & CONDUIT, ETC.-ARE IDENTIFIED FOR "Q" LISTED INSTALLATION BY LETTERS A,B,C,D, W,X,Y OR Z IN THIRD CHARACTER OF THE RACEWAY NUMBER.
3. ALL FIRE DETECTORS ARE MOUNTED ON THE CEILING.

REFERENCE DRAWINGS:

- P-2302-1-PIPING
- C-0311-1-CIVIL-STRUCTURAL
- P-9232-1-HEATING & VENTILATING
- P-9232-1-PLUMBING
- E-1406-0-RACEWAY NOTES
- SYMBOLS & DETAILS
- C-0803-1-STRUCTURAL STEEL
- C-0538-1-FLOOR ELEVATION 102'-0"
- P-0042-1-EQUIP LOCATION UNIT
- EL-7'-0"
- J-12302-1-INSTRUMENT LOCATION

RACEWAY ELEMENTS & JOCK POSITION TABLE NO. 6	
RACEWAY NO. ELEMENT NO. CIRCUIT NO.	

PRC
APERTURE
CARD

[illegible]

RENTED
SAN FRANCISCO

PUBLIC SERVICE ELECTRIC AND GAS COMPANY
NOPE CREEK GENERATING STATION

RACEWAY PLAN
REACTOR BUILDING - AREA 23
PLAN - EL 77'-0"

DATE	FILE NO.	REV.
1965	E-1622-1	9

PDR RIDS

8402060625

