



J-57-0 SH. 13

LOGIC CABINET DC 652

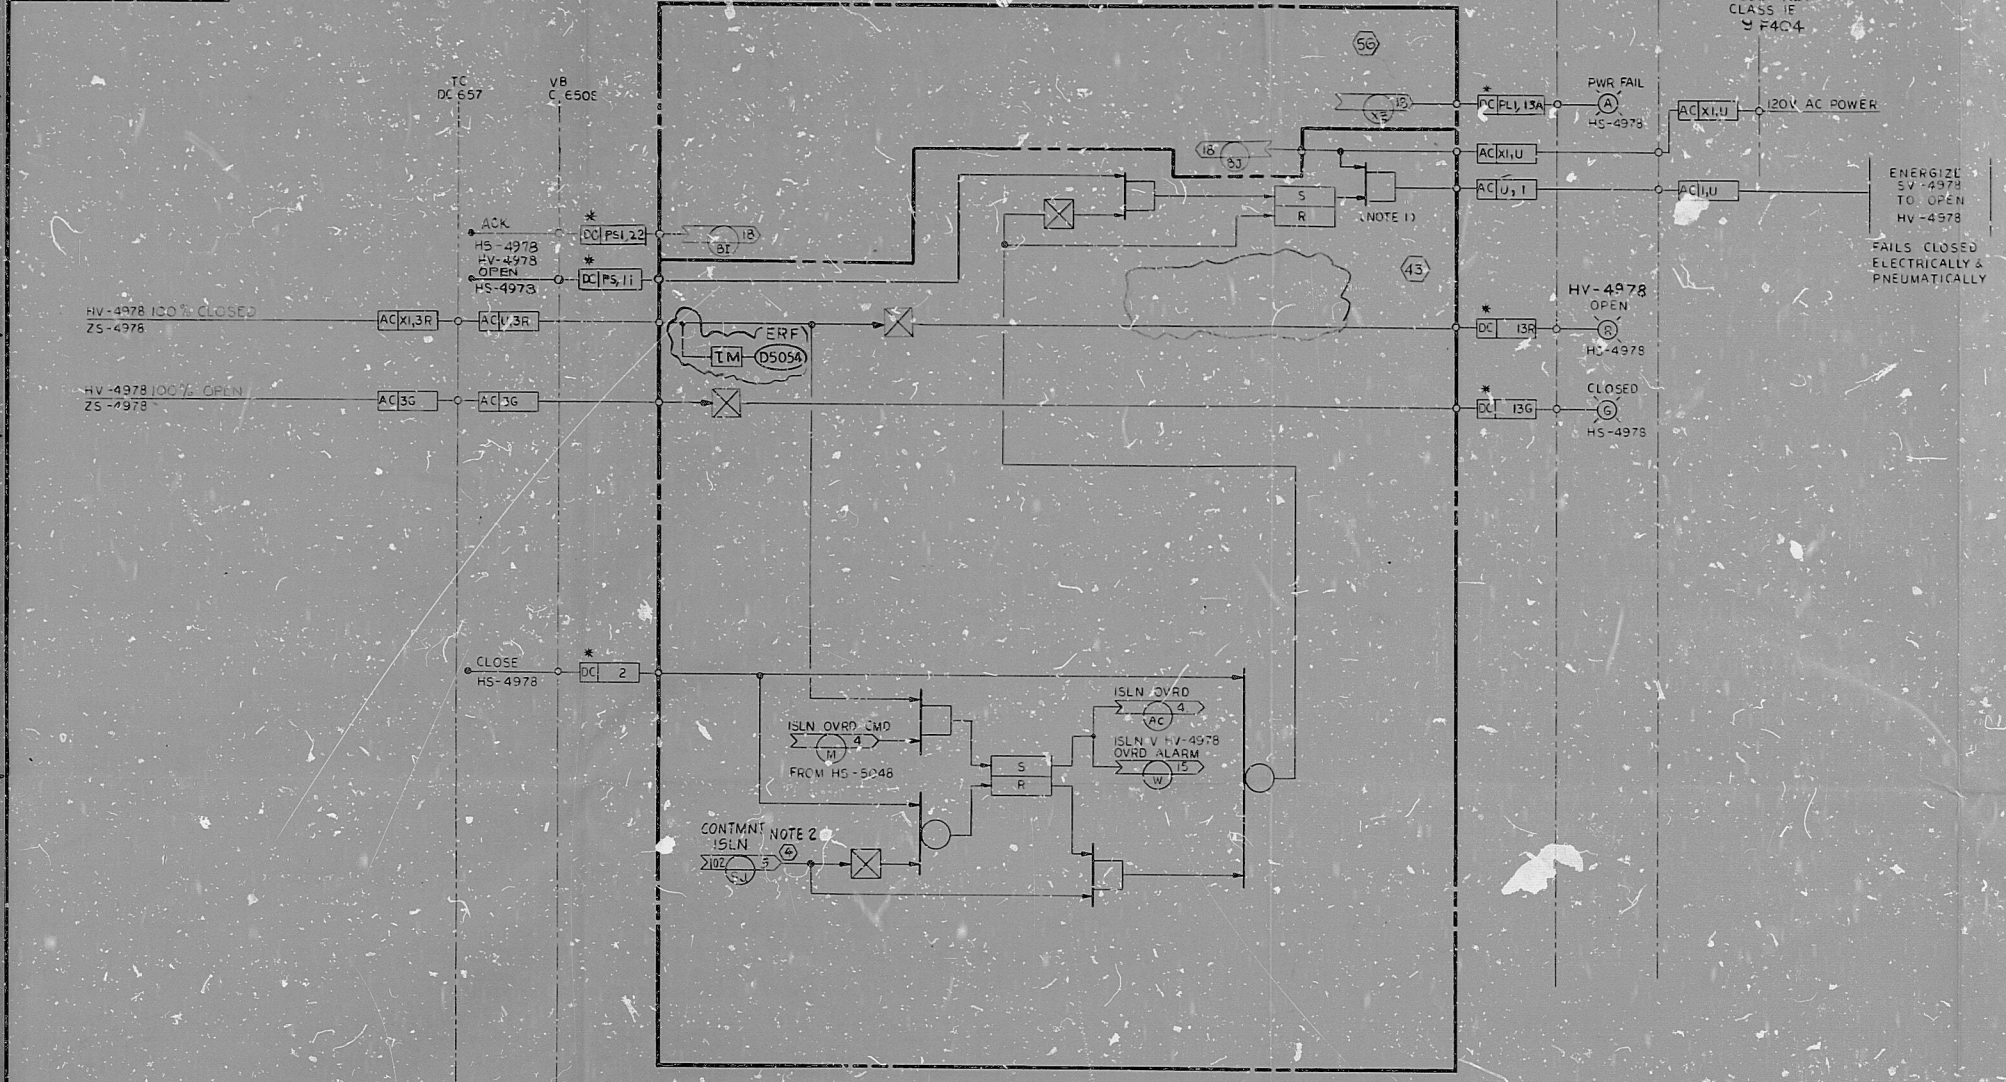

ISOLATION VALVE HV-4978
CLASS IE CHANNEL D

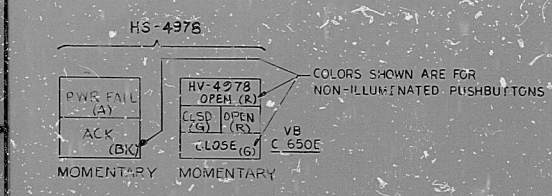

NOTES:

1. THIS "AND" GATE IS FORMED BY A CONTACT OF THE OUTPUT RELAY WHICH SWITCHES POWER SUPPLIED BY WIRE NO. X1.
2. CIRCUIT NO. APPLIES TO AND ORIGINATES ON J-102-0.

PRO APERTURE CARD

10/63	INCORPORATED DCN #11	DESIGNED	BY	DATE
11/72	DESIGN FREEZE ISSUE	DESIGNED	BY	DATE
1/74	REVISED SALES INTERFACE AS NOTED	DESIGNED	BY	DATE
4/74	INC DCN #1	DESIGNED	BY	DATE
1/77	REVISED AS NOTED	DESIGNED	BY	DATE
7/77	ISSUED FOR CONSTRUCTION	DESIGNED	BY	DATE
REVISIONS				
No.	DATE	BY	CHKD	ENGR
1				
2				
BECHTEL
SAN FRANCISCO

PUBLIC SERVICE ELECTRIC AND GAS COMPANY
MOPE CREEK GENERATING STATION

LOGIC DIAGRAM CONTAINMENT ATMOSPHERE CONTROL			
REACTOR BLDG. N2 SUPPLY ISLN VALVE			
JOB No.	DRAWING No.	REV.	
10855	J-57-0	SH-13	5 Q

SU-65

22 x 34 "D" SIZE

PDR RIDS

84 02 07 04 71

