


J-52-0 SHT. 7

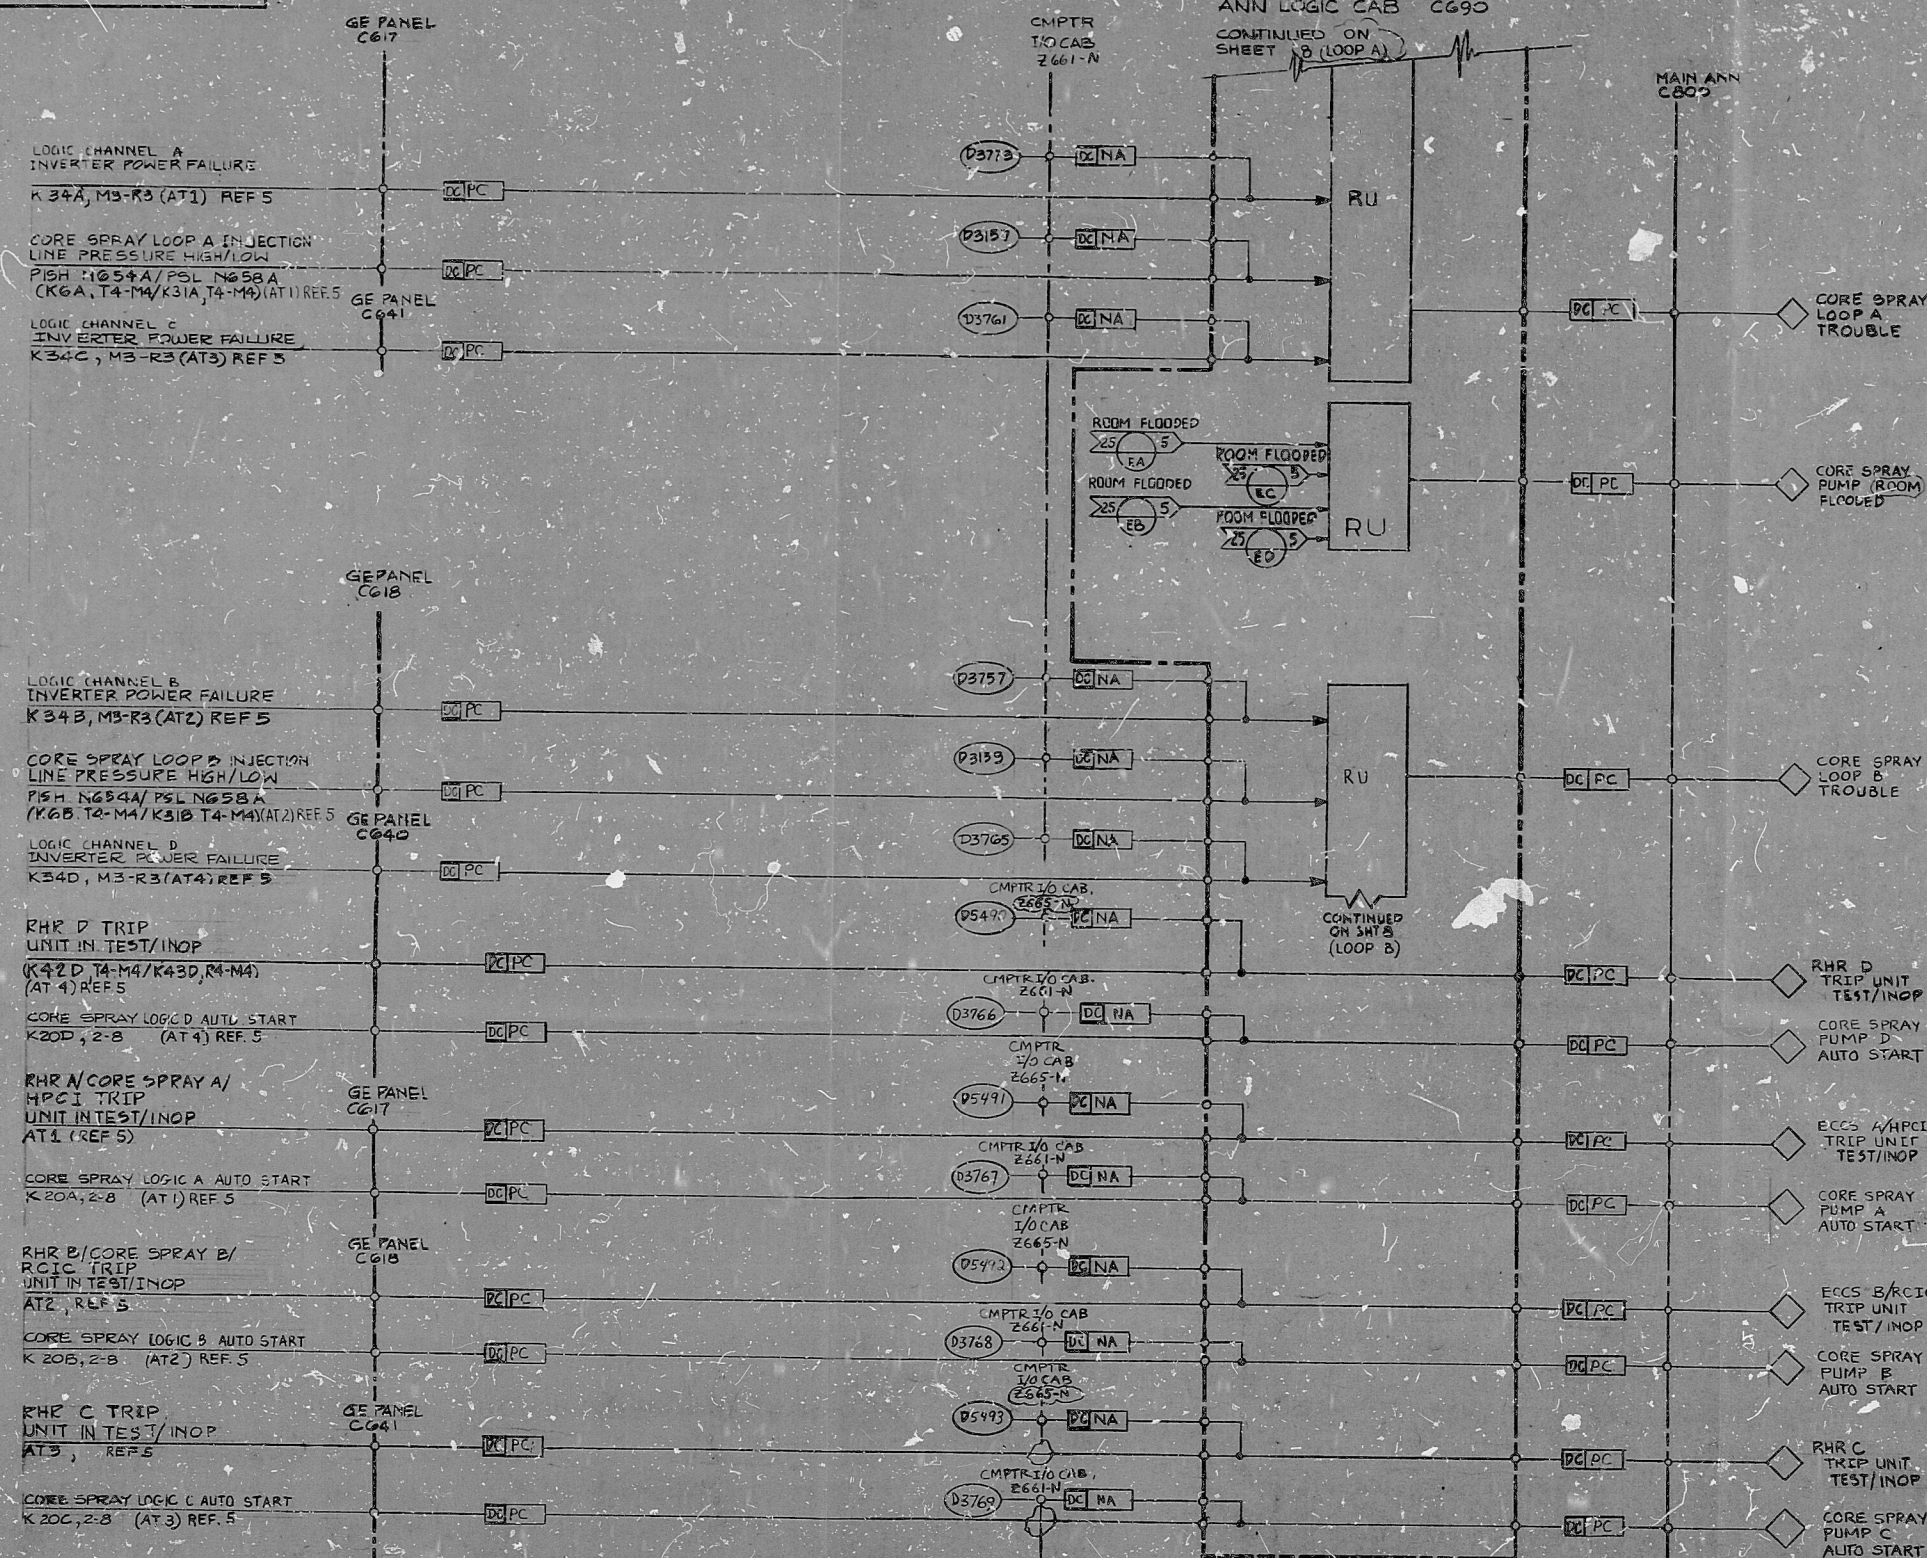

CORE SPRAY SYSTEM ALARMS

NO.	DATE	REVISION	BY	CHKD	RECHK	APPV	REAPPV
S I G N E D							
DEGTEL SAN FRANCISCO PUBLIC SERVICE ELECTRIC AND GAS COMPANY HOPE CREEK GENERATING STATION							
LOGIC DIAGRAM CORE SPRAY SYSTEM CORE SPRAY ALARMS							
JOB NO.	DRAWING NO.	REV.					
10055	J-52-0 SHT 7	5					

PDR RID

84020800 86

