


CONTACT	POSITION FRONT VIEW		CWD
	STOP	AUTO START	
1	X		*
2		X	*
3		X	*
4	X	X	*

SPRING RETURN TO AUTO, MAINTAINED IN STOP-AT REMOTE SHUTDOWN PANEL CS-1 IS SPRING RETURN TO NORMAL

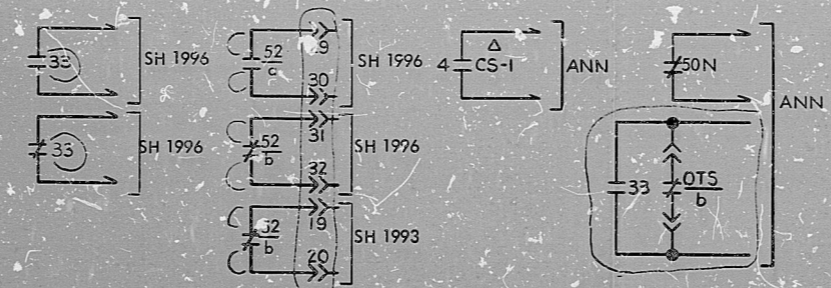

- LEGEND:
- △ AT MAIN CONTROL BOARD
 - AT REMOTE SHUTDOWN PANEL
 - AT AUX PANEL
 - ◆ ISOLATION DEVICE

- NOTES:
1. THIS ELEMENTARY IS SIMILAR FOR CHARGING PUMP 2 (SB); CHARGING PUMP 3 (GA/B) CHANNEL A & CHANNEL B.
 2. TS TRANSFER SWITCH DEVELOPMENT IS SHOWN ON SHEET 21-1.

PRC APERTURE CARD

NUCLEAR SAFETY RELATED WPPSS QUALITY CLASS I&II

5							
4							
3							
2							
1	6-7-79	AS	CD	W			
REV.	D. TE	BY	APPROVED	DATE	AUG 7, 1978		

EBASCO SERVICES INCORPORATED		WASHINGTON PUBLIC POWER SUPPLY SYSTEM	
DIV. CONTROL DR. LVT	CH. E OVALLE	APPROVED	DD Price
DATE AUG 7, 1978		NUCLEAR PROJECTS NO. 3 & 3	
		CONTROL WIRING DIAGRAM	
		CHARGING PUMP 1 (SA) ELEMENTARY	

WFPS-3240
D-6001
SHEET 1995E

RIDS

8303040100

