


J-42-0 / SHT
2

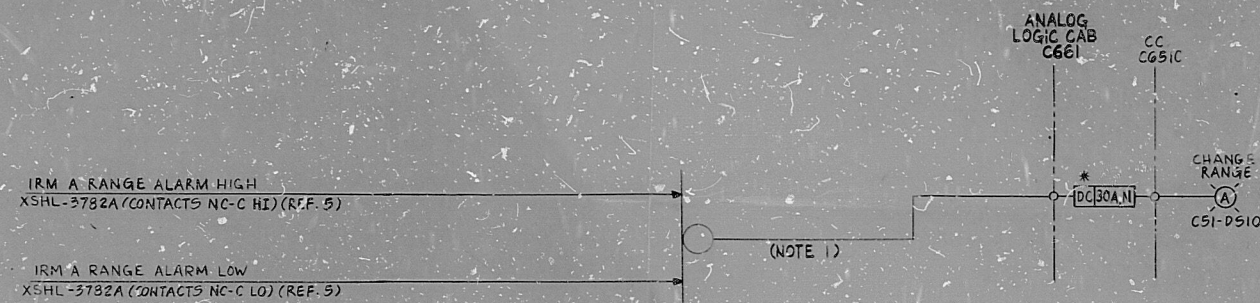


NOTES:

1. 24V DC FOR INPUTS TO HARDWIRED "OR" GATE IS SUPPLIED FROM ANALOG LOGIC CABINET.
2. DELETED

IRM CHANNEL A CHANGE RANGE ALERT

IRM CHANGE RANGE ALERT
CROSS REFERENCE TABLE

IFM CHANNEL	(REF.) CHANGE RANGE INDICATOR	BISTABLE
A	CS1-DS10	XSL33782A
C	11	
E	12	
G	13	
B	14	
D	15	
F	16	
H	17	

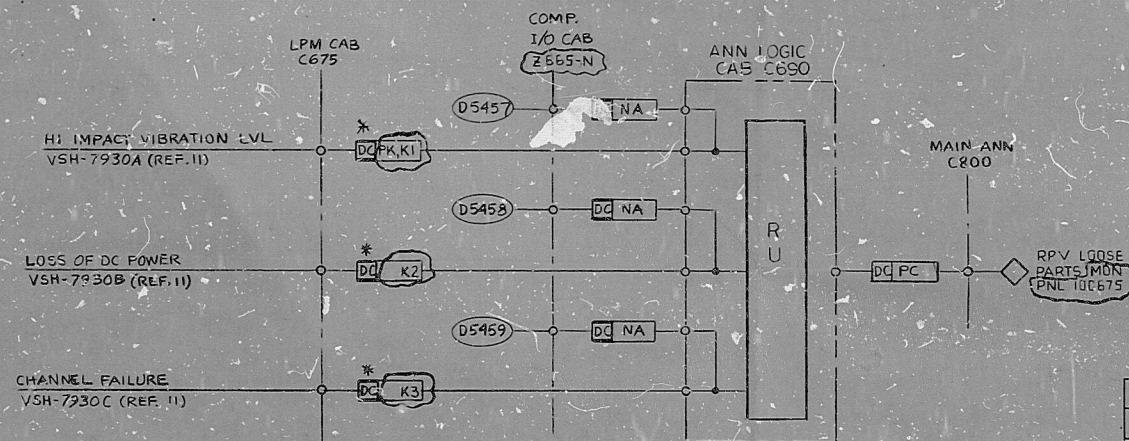

LOOSE PART MONITOR SYSTEM ALARM

PRC
APERTURE
CARD

10/5/8	REVISED CHPTR 1 TO CAG AND W/IRRE NUMBERS	17/8	11/6	11/6
6/14/8	DESIGN FREEZE ISSUE	30	20	14/5 ECU
11/11/80	WIS SHT I CHANGED TO SH2. REVISED AS NOTED.	30	20	14/5 CAN
3/4/79	INCORPORATED REVISIONS SHOW ON DCN # 1	SW	25	14/5 CAN
11/4/78	ISSUED FOR CONSTRUCTION	0.000	2	14/5 CAN
PP DATE	REVISIONS	BY	CHECKED	DATE
SCALE NONE	DRAWING AMK	MADON WL	KRICK KAPP	EKEK PAGE 1A
BECHTEL SAN FRANCISCO				
PUBLIC SERVICE ELECTRIC AND GAS COMPANY HOPE CREEK GENERATING STATION				
LOGIC DIAGRAM NUCLEAR BOILER VESSEL INSTR.				
CHANGE RANGE ALERTING / LOOSE PART MON SYS A ARM				
	JOB No.	DRAWING No.	REV.	
	19955	J-42-O	SHT 2	4

S/U-SE, SC

PDR BIDS

8402080284

