


J-110, 5HT33

[illegible]

PDR RIDS

8402090599

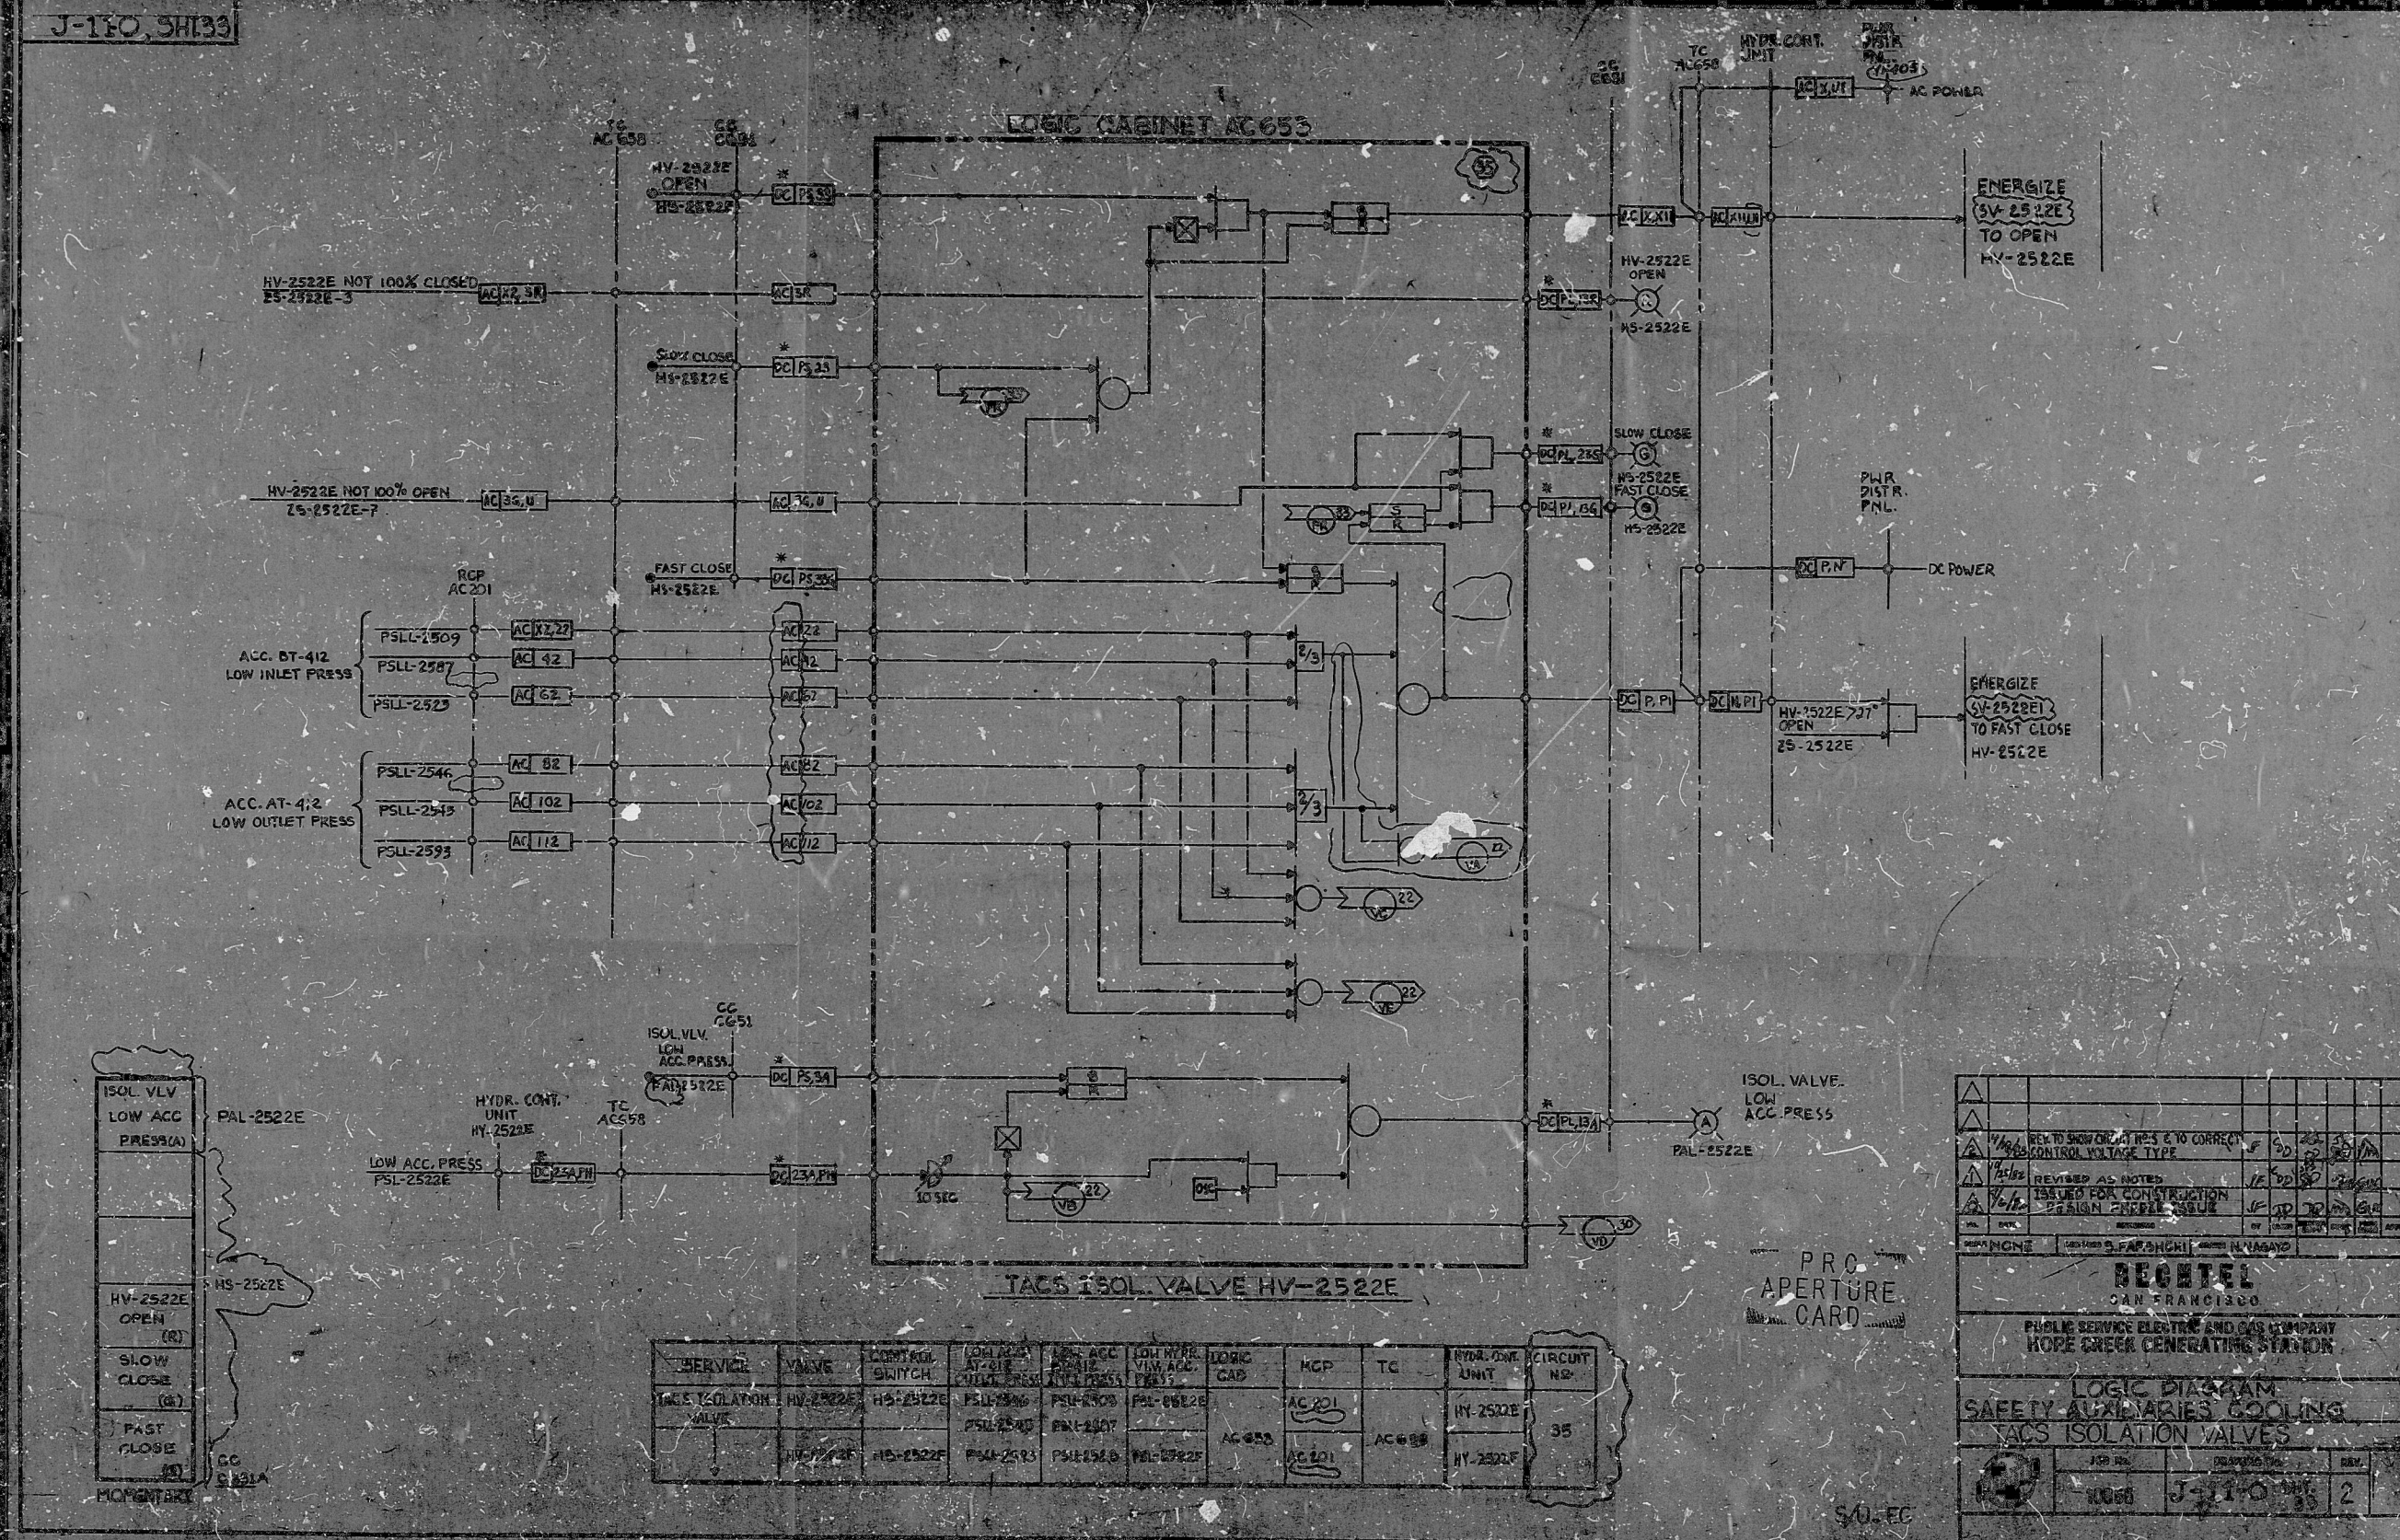