


J-11504-1

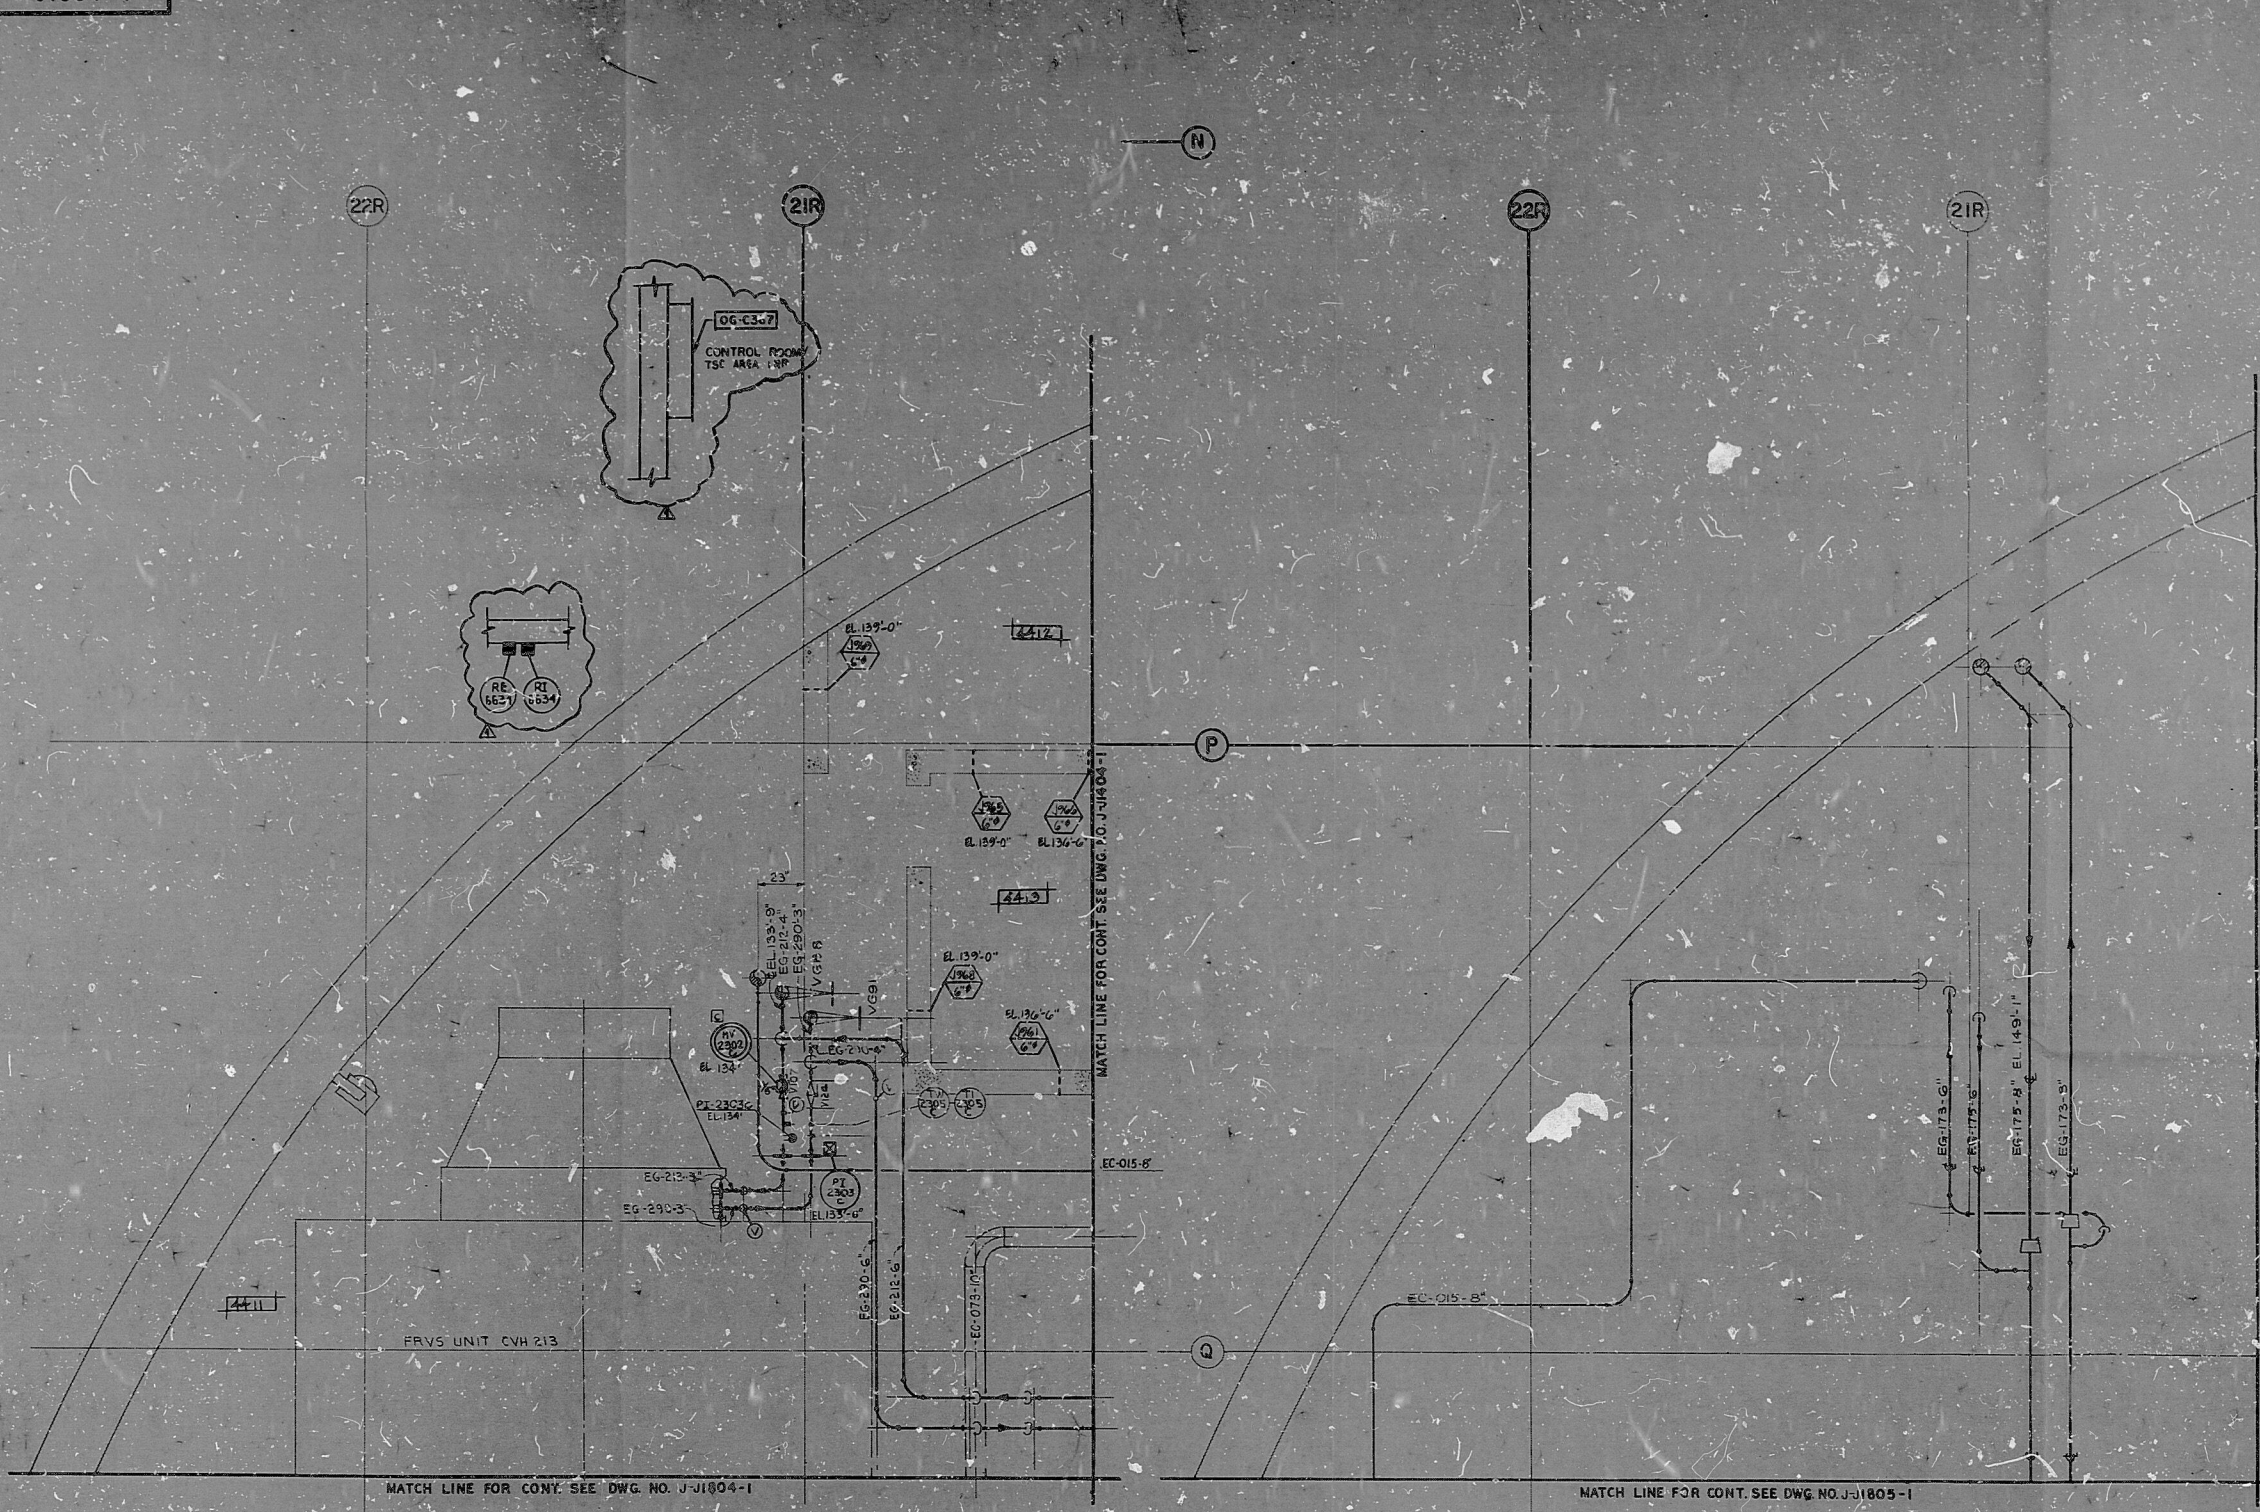


KEY PLAN

01	02	
----	----	-----

PLANT REFERENCE DRAWINGS:
 M-11-12
 M-26-12
 PIPING:
 P-1504-1

- NOTES:
1. FOR GENERAL NOTES AND LEGEND SEE DRAWING J-1001
 2. ALL INSTRUMENTS ON 2" AND UNDER FIELD RUN PIPING WILL NOT APPEAR ON THE LOCATION DRAWING, AND WILL READ FIELD IN THE INSTRUMENT INDEX IN THE EQUIPMENT COLUMN
 3. FOR THE EXACT LOCATION OF THE PRIMARY POINT REFER TO THE ENGINEERING AND/OR FIELD ISOMETRIC DRAWINGS.

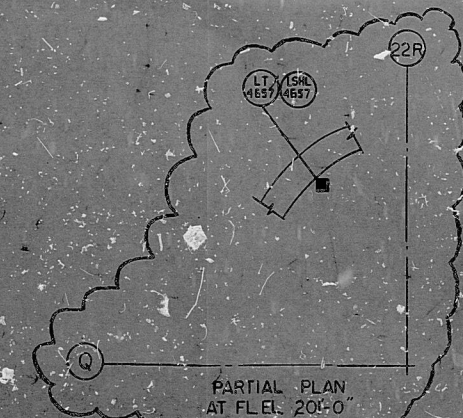

PRC APERTURE CARD

RACK/PANEL INDEX

RACK/PANEL #	DESIGN DRAWING
06-0367	10053-1361-21

REVISIONS

NO.	DATE	DESCRIPTION	BY	CHKD
1	10/1/55	REVISED AS NOTED	...	...
2	10/1/55	REVISED AS NOTED	...	...
INSTRUMENT LOCATION DWG.
 REACTOR BLDG AREA-15
 EL. 132'-0" & EL. 145'-0" 201-0"

10055 J-11504-1 4

8402090667

PDR RIDS

