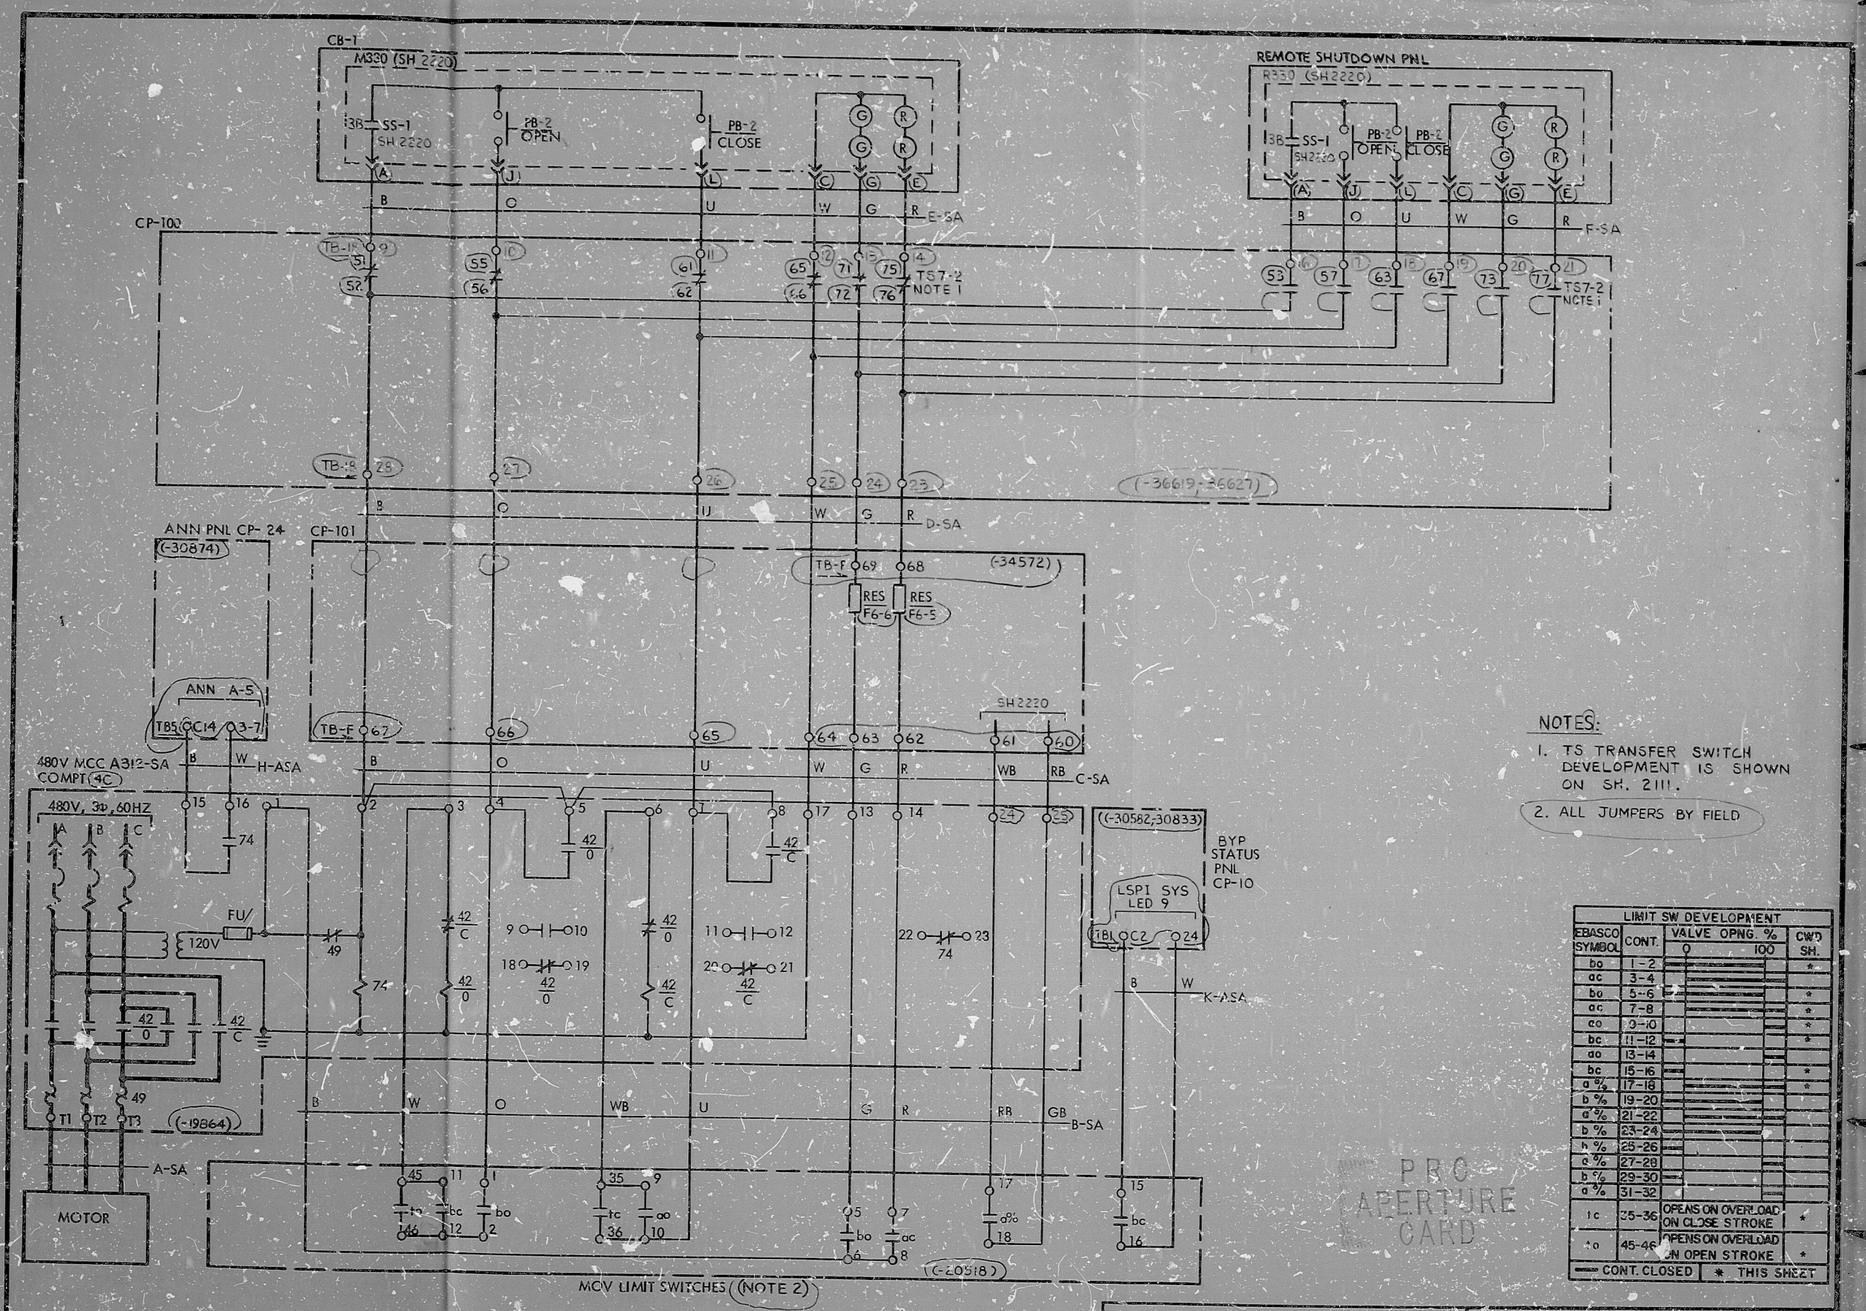

NOTES:

1. TS TRANSFER SWITCH DEVELOPMENT IS SHOWN ON SH. 2111.
2. ALL JUMPERS BY FIELD

LIMIT SW DEVELOPMENT			
EBASCO SYMBOL	CONT.	VALVE OPNG. % 0 — 100	CWD SH.
bo	1-2		*
ac	3-4		
bo	5-6		*
ac	7-8		*
co	9-10		*
bc	11-12		*
ao	13-14		
bc	15-16		*
a %	17-18		*
b %	19-20		
a %	21-22		
b %	23-24		
h %	25-26		
a %	27-28		
b %	29-30		
a %	31-32		
tc	35-36	OPENS ON OVERLOAD ON CLOSE STROKE	*
to	45-46	OPENS ON OVERLOAD ON OPEN STROKE	*
— CONT. CLOSED		* THIS SHEET	

PRC APERTURE CARD

NUCLEAR SAFETY RELATED | WPPSS QUALITY CLASS I

REV.	DATE	BY	APPROVED
5			
4			
3			
2	7-2-82	LB LVT	
1	10-23-78	A.R.	

EBASCO SERVICES INCORPORATED
DIV. CONTROL DR. LVT
CH. E. CVALLE
DATE MAY 5, 1977
APPROVED
APPROVED

WASHINGTON PUBLIC POWER SUPPLY SYSTEM
NUCLEAR PROJECTS NO. 3 & 5
CONTROL WIRING DIAGRAM
SCHX I DISCH TO LPSI HDR 1 X-CONN
150 VA 2CS-VS021SAR(51-686)

WPPS-3240
D-6001
SHEET 2219

RIDS

8303090581

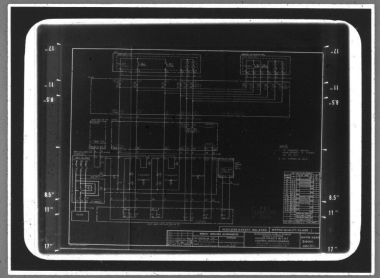

MMM 5824 — FILMSORT® Brand Aperture & Camera Cards and DUPLICARD® Brand Copy Cards — Product of 3M Company, St. Paul, Minn.