


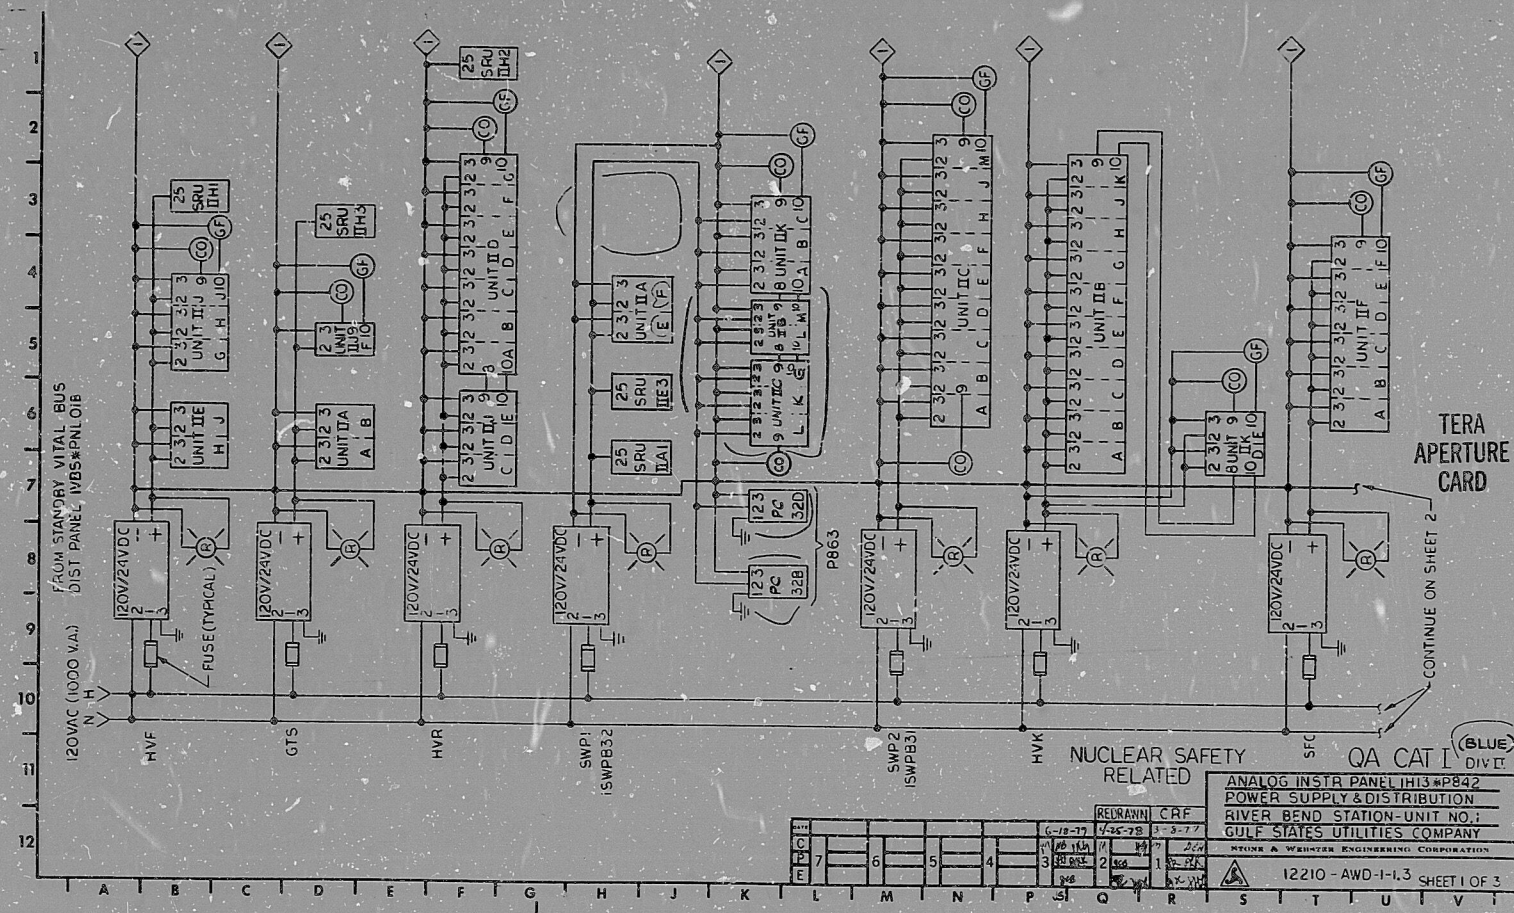

RIDS

8109280682

