



RECIRC LOOP SCHEDULE

HANGER	LOAD (LBS)	TRAVEL	SPRING TRAVEL	SPRING TRAVEL
N/A	COLD	HOT	COLD	HOT

SS	LOAD RESISTING FORCE	MIN CYL	PIS FOR	TRAVEL	SPRING TRAVEL	SPRING TRAVEL
SS-1	COLD	HOT	COLD	HOT	COLD	HOT
SS-1	0	30,000	5"	1 1/2"	2 1/2"	3 1/2"
SS-2	0	30,000	5"	1 1/2"	2 1/2"	3 1/2"
SS-3	0	30,000	5"	1 1/2"	2 1/2"	3 1/2"
SS-4	0	30,000	5"	1 1/2"	2 1/2"	3 1/2"
SS-5	0	20,000	5"	1 1/2"	2 1/2"	3 1/2"
SS-6	0	20,000	5"	1 1/2"	2 1/2"	3 1/2"

POOR ORIGINAL

SB	LOAD (LBS)	SPRING TRAVEL	SPRING TRAVEL	
SB-1	COLD	HOT	COLD	HOT
SB-1	0	30,000	5"	1 1/2"
SB-2	0	30,000	5"	1 1/2"
SB-3	0	30,000	5"	1 1/2"
SB-4	0	30,000	5"	1 1/2"
SB-5	0	20,000	5"	1 1/2"
SB-6	0	20,000	5"	1 1/2"

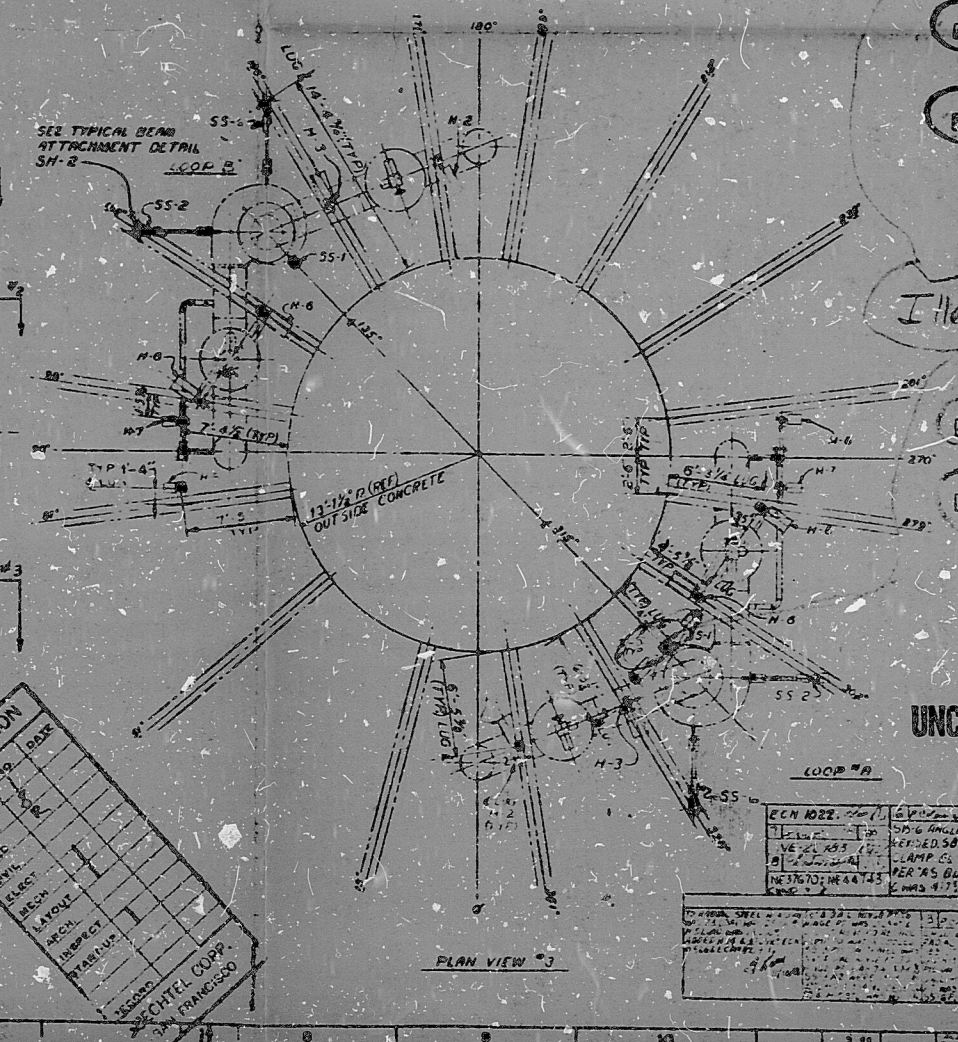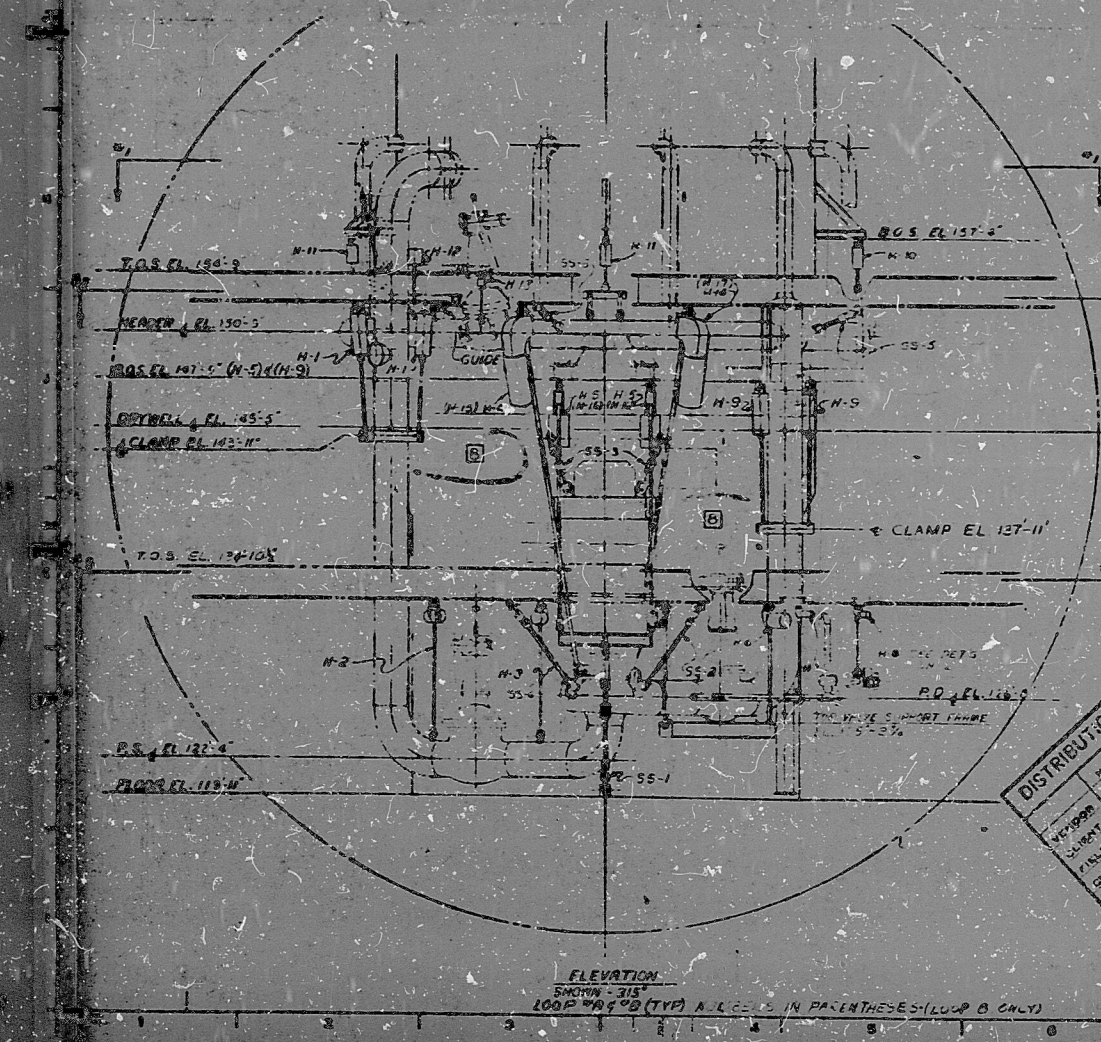

REFERENCE DRAWINGS

- RECIRC LOOP PIPING APPURT
- RECIRC PUMP SUSPENSION LUGS
- RECIRC LOOP PIPE RESTRAINTS

UNCONTROLLED PRINT

NO.	DATE	BY	CHKD	APP'D

DISTRIBUTION	NO.	DATE

BECHTEL JOB # SAN FRANCISCO 628



M-1-E-510

PDR

840215DD50

