


BECHTEL
 VENDORS DRAWING REVIEW
 PHILADELPHIA, PA. JOB NO. 6280
 REACH BOTTOM UNITS 2 & 3

POOR ORIGINAL M-1-E-1-1

TI
 APERTURE
 CARD
 AUG 27 1969

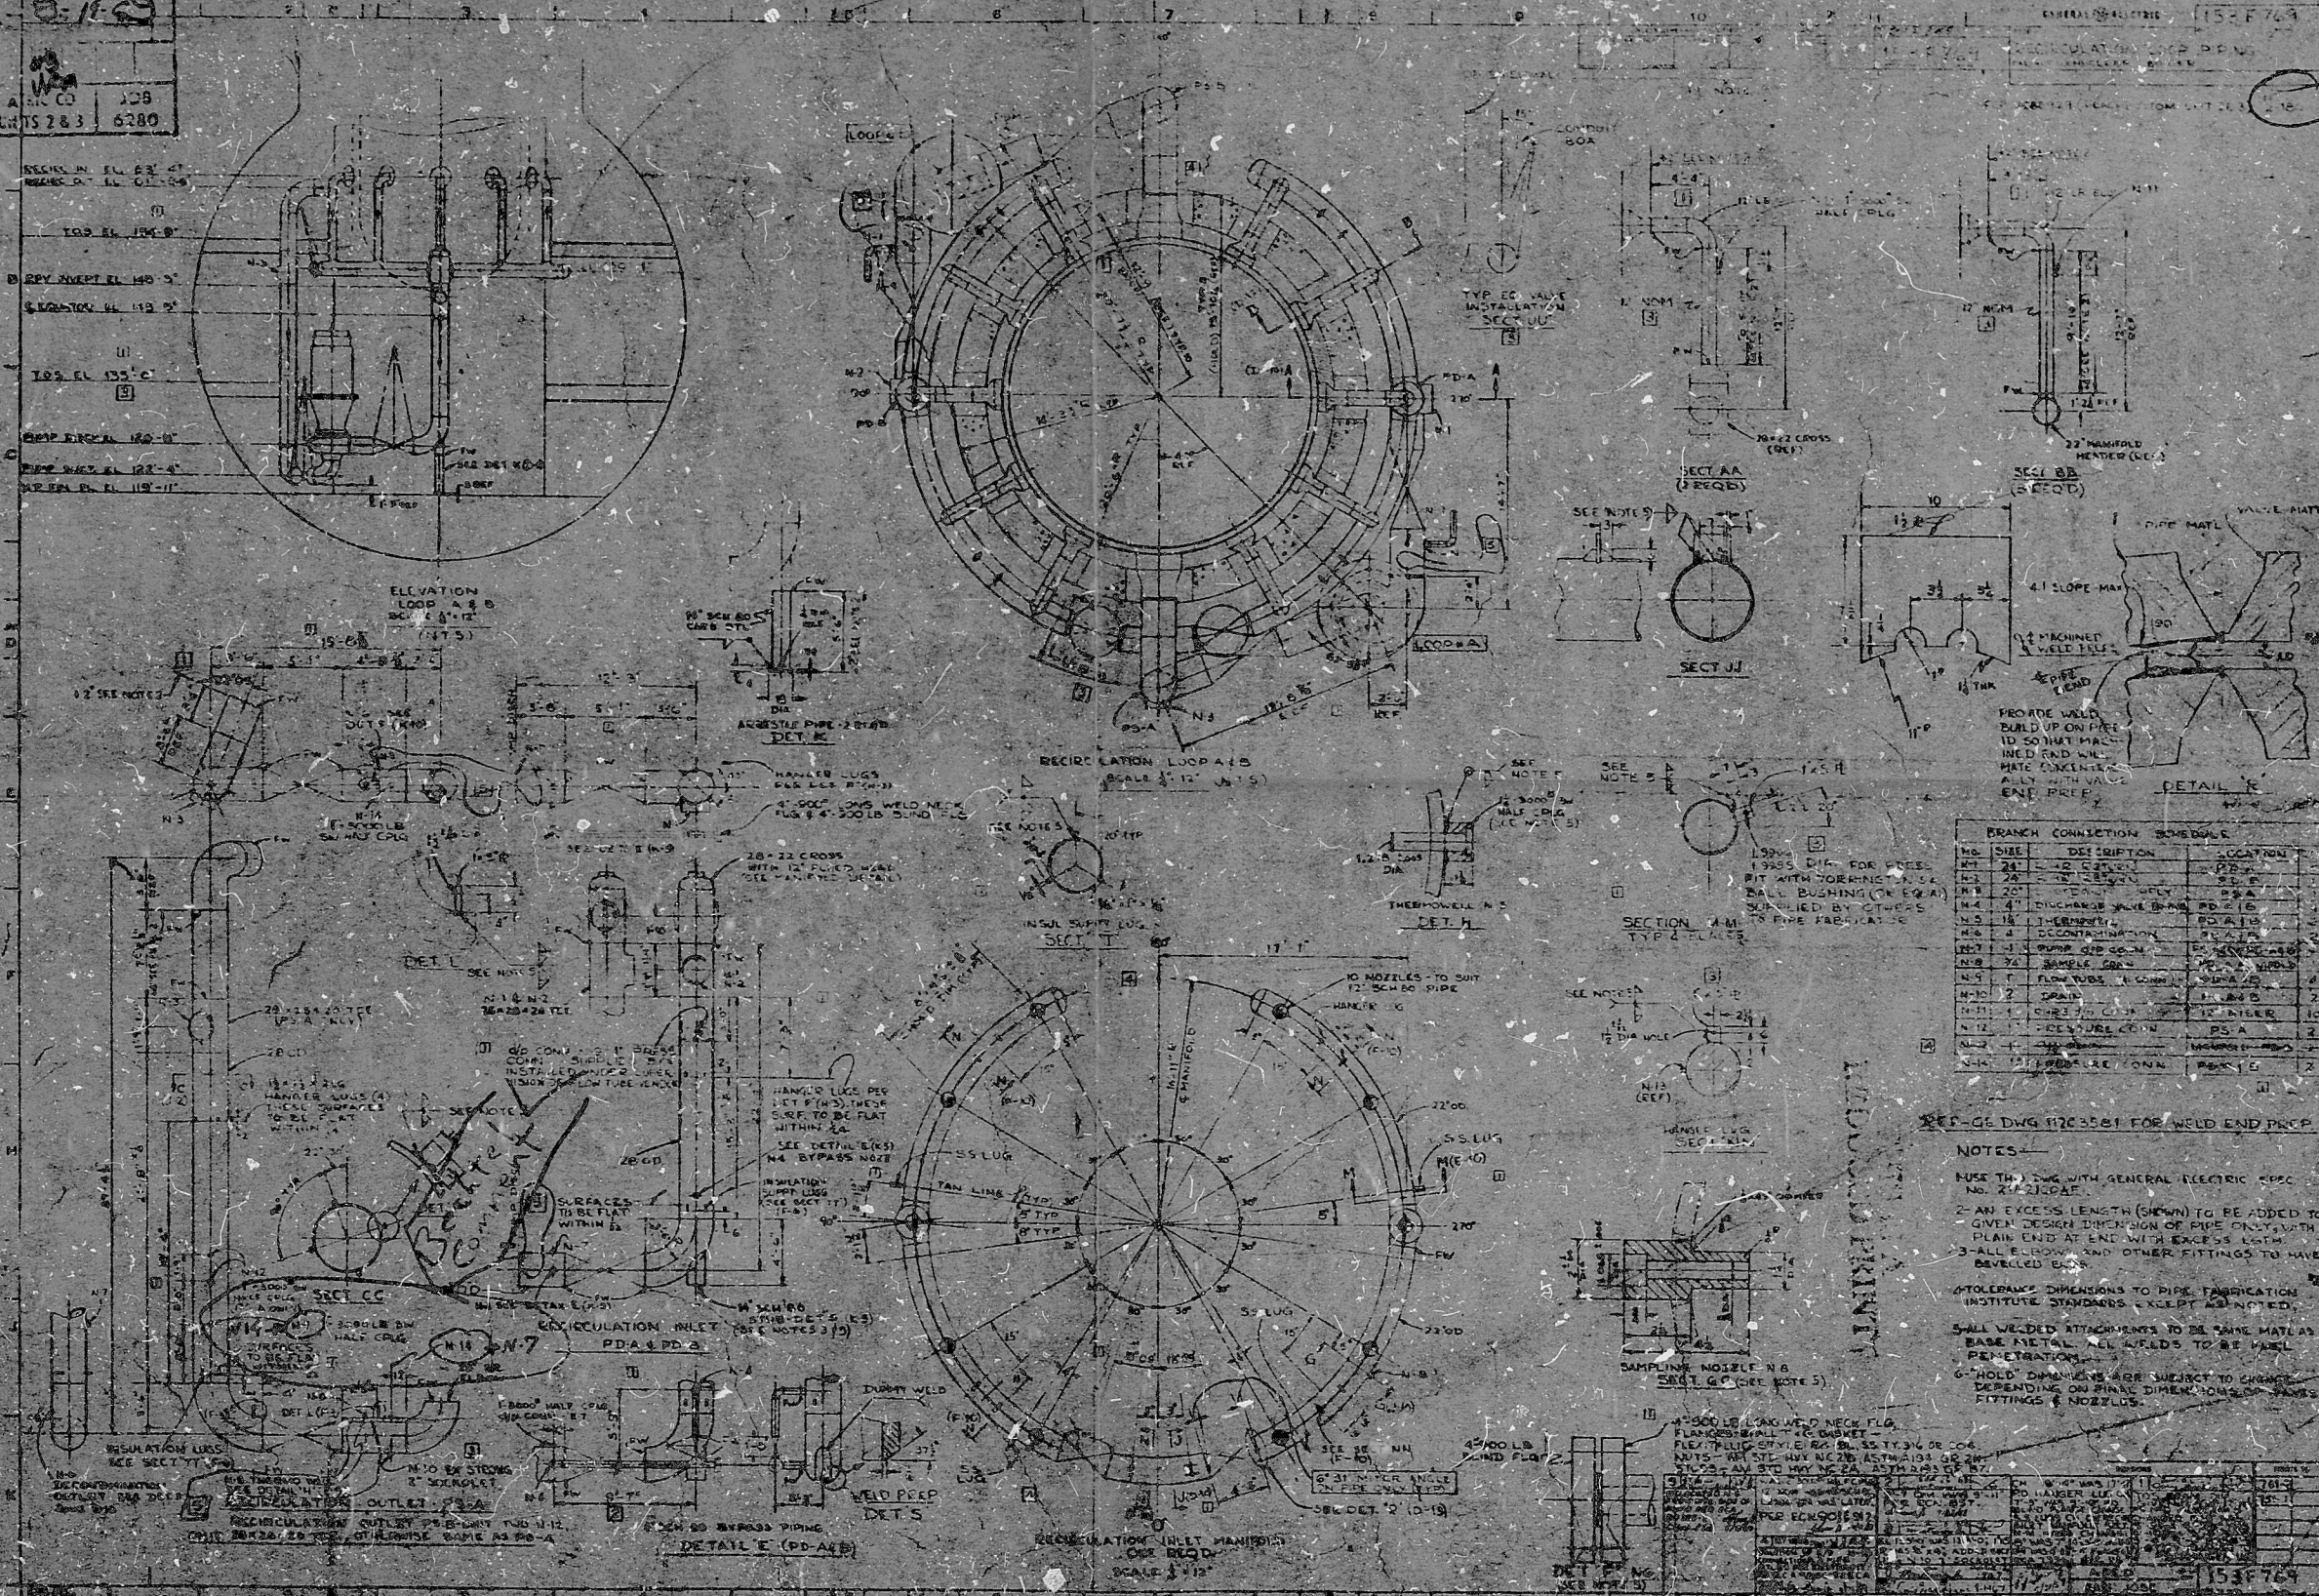

NO.	SHEET	DESCRIPTION	SCHEDULE
1	1	28" DIA. PIPE	304

NOTES
 1. USE THE 1/2" DIA. WITH GENERAL ELECTRIC SPEC. NO. 24-21-04E.
 2. AN EXCESS LENGTH (SHOWN) TO BE ADDED TO GIVEN DESIGN DIMENSION OF PIPE ONLY WITH FLARE END AT END WITH EXCESS LENGTH.
 3. ALL FITTINGS AND OTHER FITTINGS TO HAVE DEVELOPED END.
 4. TOLERANCE DIMENSIONS TO PIPE FABRICATOR INSTITUTE STANDARDS & KEPT AS NOTED.
 5. ALL WELDED ATTACHMENTS TO BE TANK METAL AS BASE METAL. ALL WELDS TO BE FULL PENETRATION.
 6. HOLD DIMENSIONS ARE SUBJECT TO CHANGE DEPENDING ON FINAL DIMENSIONS OF TANKS, FITTINGS & NOZZLES.

UNCONTROLLED PRINT
 8402150053

PDR

8402150053

