
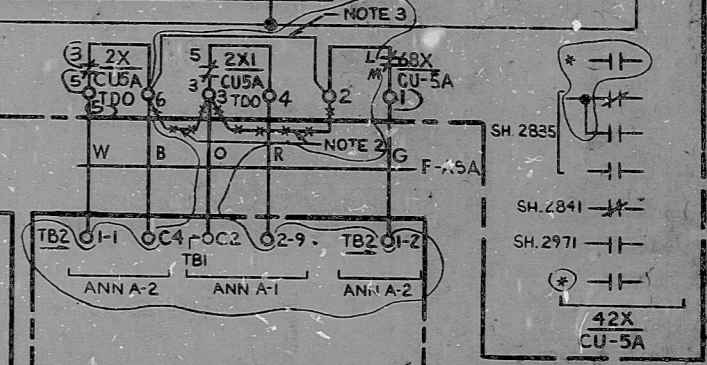
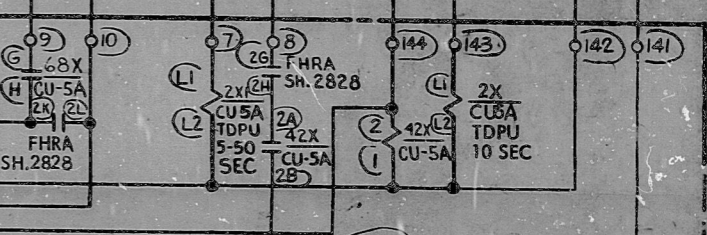
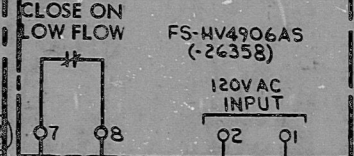



CONTACT	POSITION FRONT VIEW			CWD
	STOP	AUTO	START/DRIVE	
1			X	*
2		X		*
3			X	*
4	X	X		*

CS: SPRING RETURN TO AUTO  
\* THIS SHEET

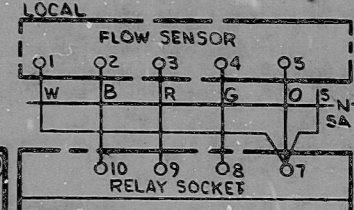

- NOTES
1. FOR TRANSFER SW TS11-1 DEVELOPMENT SEE SH. 2111
  2. FIELD TO DISCONNECT.
  3. FIELD TO WIRE.
  4. CONTACT CLOSURES ON HIGH-DIFF. PRESSURE.

PROC APERTURE CARD

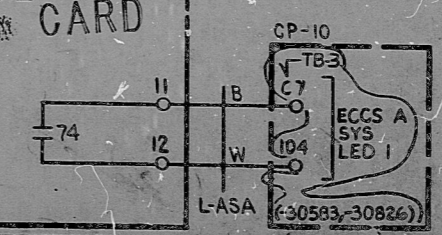

EBASCO SERVICES INCORPORATED DIV. CONTROL DR. A.M. CH. V. ALKSNIN'S DATE JUNE 8, 1978			WASHINGTON PUBLIC POWER SUPPLY SYSTEM NUCLEAR PROJECTS NO. 3 & B CONTROL WIRING DIAGRAM ECCS AREA EXHAUST CLEAN-UP UNIT CU-5A FAN			WPPSS QUALITY CLASS I WPPS-3240 D-6001 SHEET 2834		
3 4 5 APPROVED <i>D.J. Price</i> DATE JUNE 8, 1978			WPPSS QUALITY CLASS I				

MADE IN U.S.A. 11-24 600228

RIDS

8303100521

