


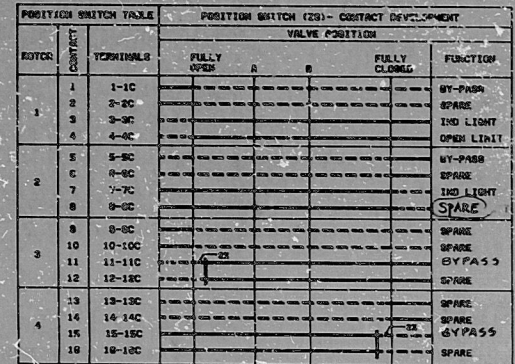

MG-17 CLOSING TORQUE SWITCH, OPERATE WITH HIGH TORQUE IN CLOSED DIRECTION.
MG-18 OPENING TORQUE SWITCH, OPERATE WITH HIGH TORQUE IN OPEN DIRECTION.
POSITION SWITCH DEVELOPMENT NOTES:

1. CONTACT CLOSED
2. CONTACT OPENED
3. EACH MOTOR MAY BE SET TO OPERATE CONTACTS FULLY OPEN, FULLY CLOSED OR ANY POSITION IN BETWEEN.
4. MOTORS CAN BE ASSEMBLED SO THAT TWO/THREE OR ALL FOUR CONTACTS CLOSE SIMULTANEOUSLY.


NOTES:

1. THESE CONDUCTORS ARE INCLUDED IN A CABLE PROVIDED AS PART OF THE J200(G) CONTROL RUM CABLE. THIS CABLE IS DESIGNATED BY A CABLE SCHEME NUMBER ENCLOSED IN THIS DRAWING. THE CABLES ARE LISTED IN THE CABLE SCHEDULE FORM REFERENCE 5.
2. EQUIPMENT SHOWN ON THIS DWG IS (2) LISTED EXCEPT AS NOTED OR IDENTIFIED BY THE FOLLOWING SYMBOLARY
- REFERENCE DRAWINGS:
- 1. LOGIC DIAGRAM DWG. J-51-(G) SH-5.
 - 2. BATTERY METER NO. DWG. 10955-J200(G) 1330, 1268, 2124.
 - 3. 400V MCC TAB. DWG. E-0021-1 (G) SH-1.
 - 4. E.E. NEUTRALITY DIAGRAM 10855-J1-1040-363 (3)(A)(2)(C).
 - 5. BATTERY METER C.O. DWG. 10855-J200(G)-1861 SH-1, 7, 8, 9,7

REFERENCE DRAWINGS



1. LOGIC DIAGRAM DNO. J-51-0(Q), SH.9.
2. BAILEY METER NO. DWG. 10855-J200(Q) 1330, 1268, 2124.
3. 480V MCC TAB. DMO. E-0021-1 (Q), SH.1.
4. Q.E. ELEMENTARY DIAGRAM 10853-VII-EII-1040-363 (91F12AC) (SH.20).
5. BAILEY METER CO. DWG. 10855-J200(Q) 1891 SH.77
-2264 6HTS 3, 15, 1K. BECHTEL C.O. DWG E-4516-0
E-4516-0.

HX SHELL SIDE INLET VALVE 14V-F047A
SCHEME NO.1Q0832 S/U BC (INST. TAG NO. 1BC-...)
CLASS 17-CHANNEL A

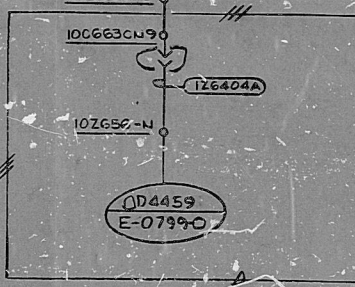

NOTE-2

HS-F047A					
CONTACTS		POSITIONS			CONTACT REF.
		OPEN (O/P)		CLOSE (C/P)	
OPEN		1	X	X	THIS DWG.
		2	X		THIS DWG.
CLOSE		5	X	X	THIS DWG.
		6		X	THIS DWG.

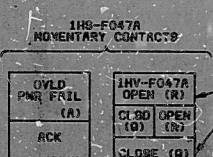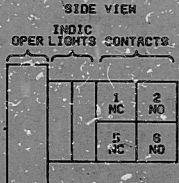

COLORS SHOWN ARE
FOR NON-ILLUMINATED
PUSHBUTTONS

100250A 2
REF: A 164

100850A 2
MODULE A 164

PRC
APERTURE
CARD

[illegible]

BRIGHT

PUBLIC SERVICE ELECTRIC AND GAS COMPANY
HOPE CREEK GENERATING STATION

ELECTRICAL SCHEMATIC DIAGRAM
RESIDUAL HEAT REMOVAL SYSTEM
HX SHELL SIDE INLET VALVE IHV-F04

	JOB No.	DRAWING No.	REV.
	10855	E-6231-0 SH. 4 OF 14	1

PDR RIDS

840 215 0091

