

17"

11"

8.5"

17"

11"

8.5"

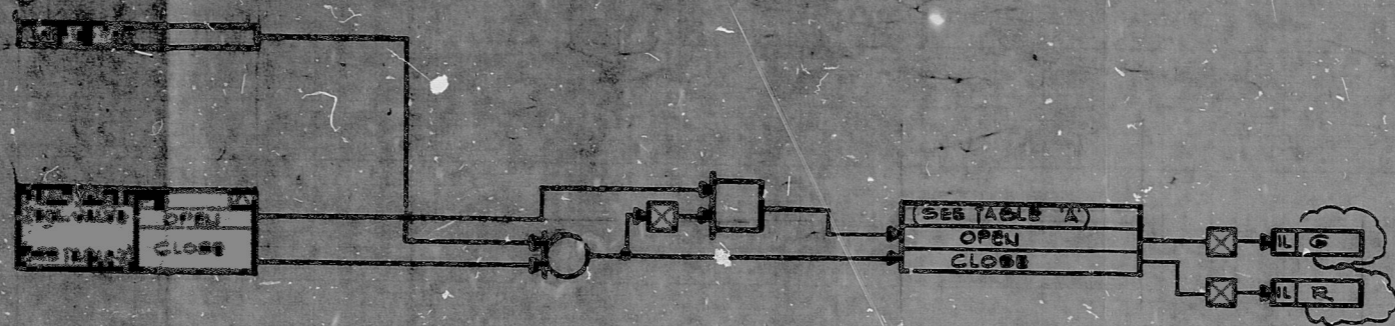


TABLE 'A'

CONTROL VALVE NO.	DESCRIPTION	INST. SCHEMATIC DIAGRAM SHEET NO.

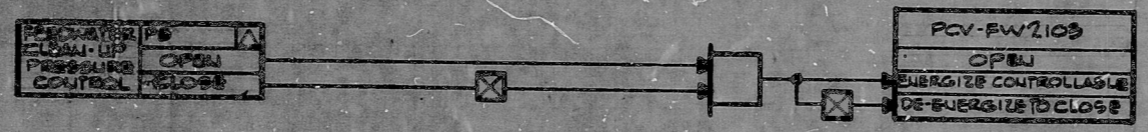


TABLE 'B'

CONTROL VALVE NO.	DESCRIPTION	INST. SCHEMATIC DIAGRAM SHEET NO.

DOOR CLOSED

PRC APERTURE CARD

8.5"

11"

8.5"

11"

17"

17"

NUCLEAR SAFETY RELATED WPPSS QUALITY CLASS I, II

EDASCO SERVICES INCORPORATED
 DIV. ENGINEERING FOR RPF
 CH. A. JUGO
 DATE JAN 18, 1979

WASHINGTON PUBLIC POWER SUPPLY SYSTEM
 NUCLEAR PROJECT NO 365
 INSTRUMENT SCHEMATIC - LOGIC DIAGRAM
 FEEDWATER TO STEAM GENERATORS A&B

WPPS-9240
 06090
 INST 38B

RIDS

8303110494

