


11
11
8.5
11
8.5
11
11

11
11
8.5
8.5
11
11

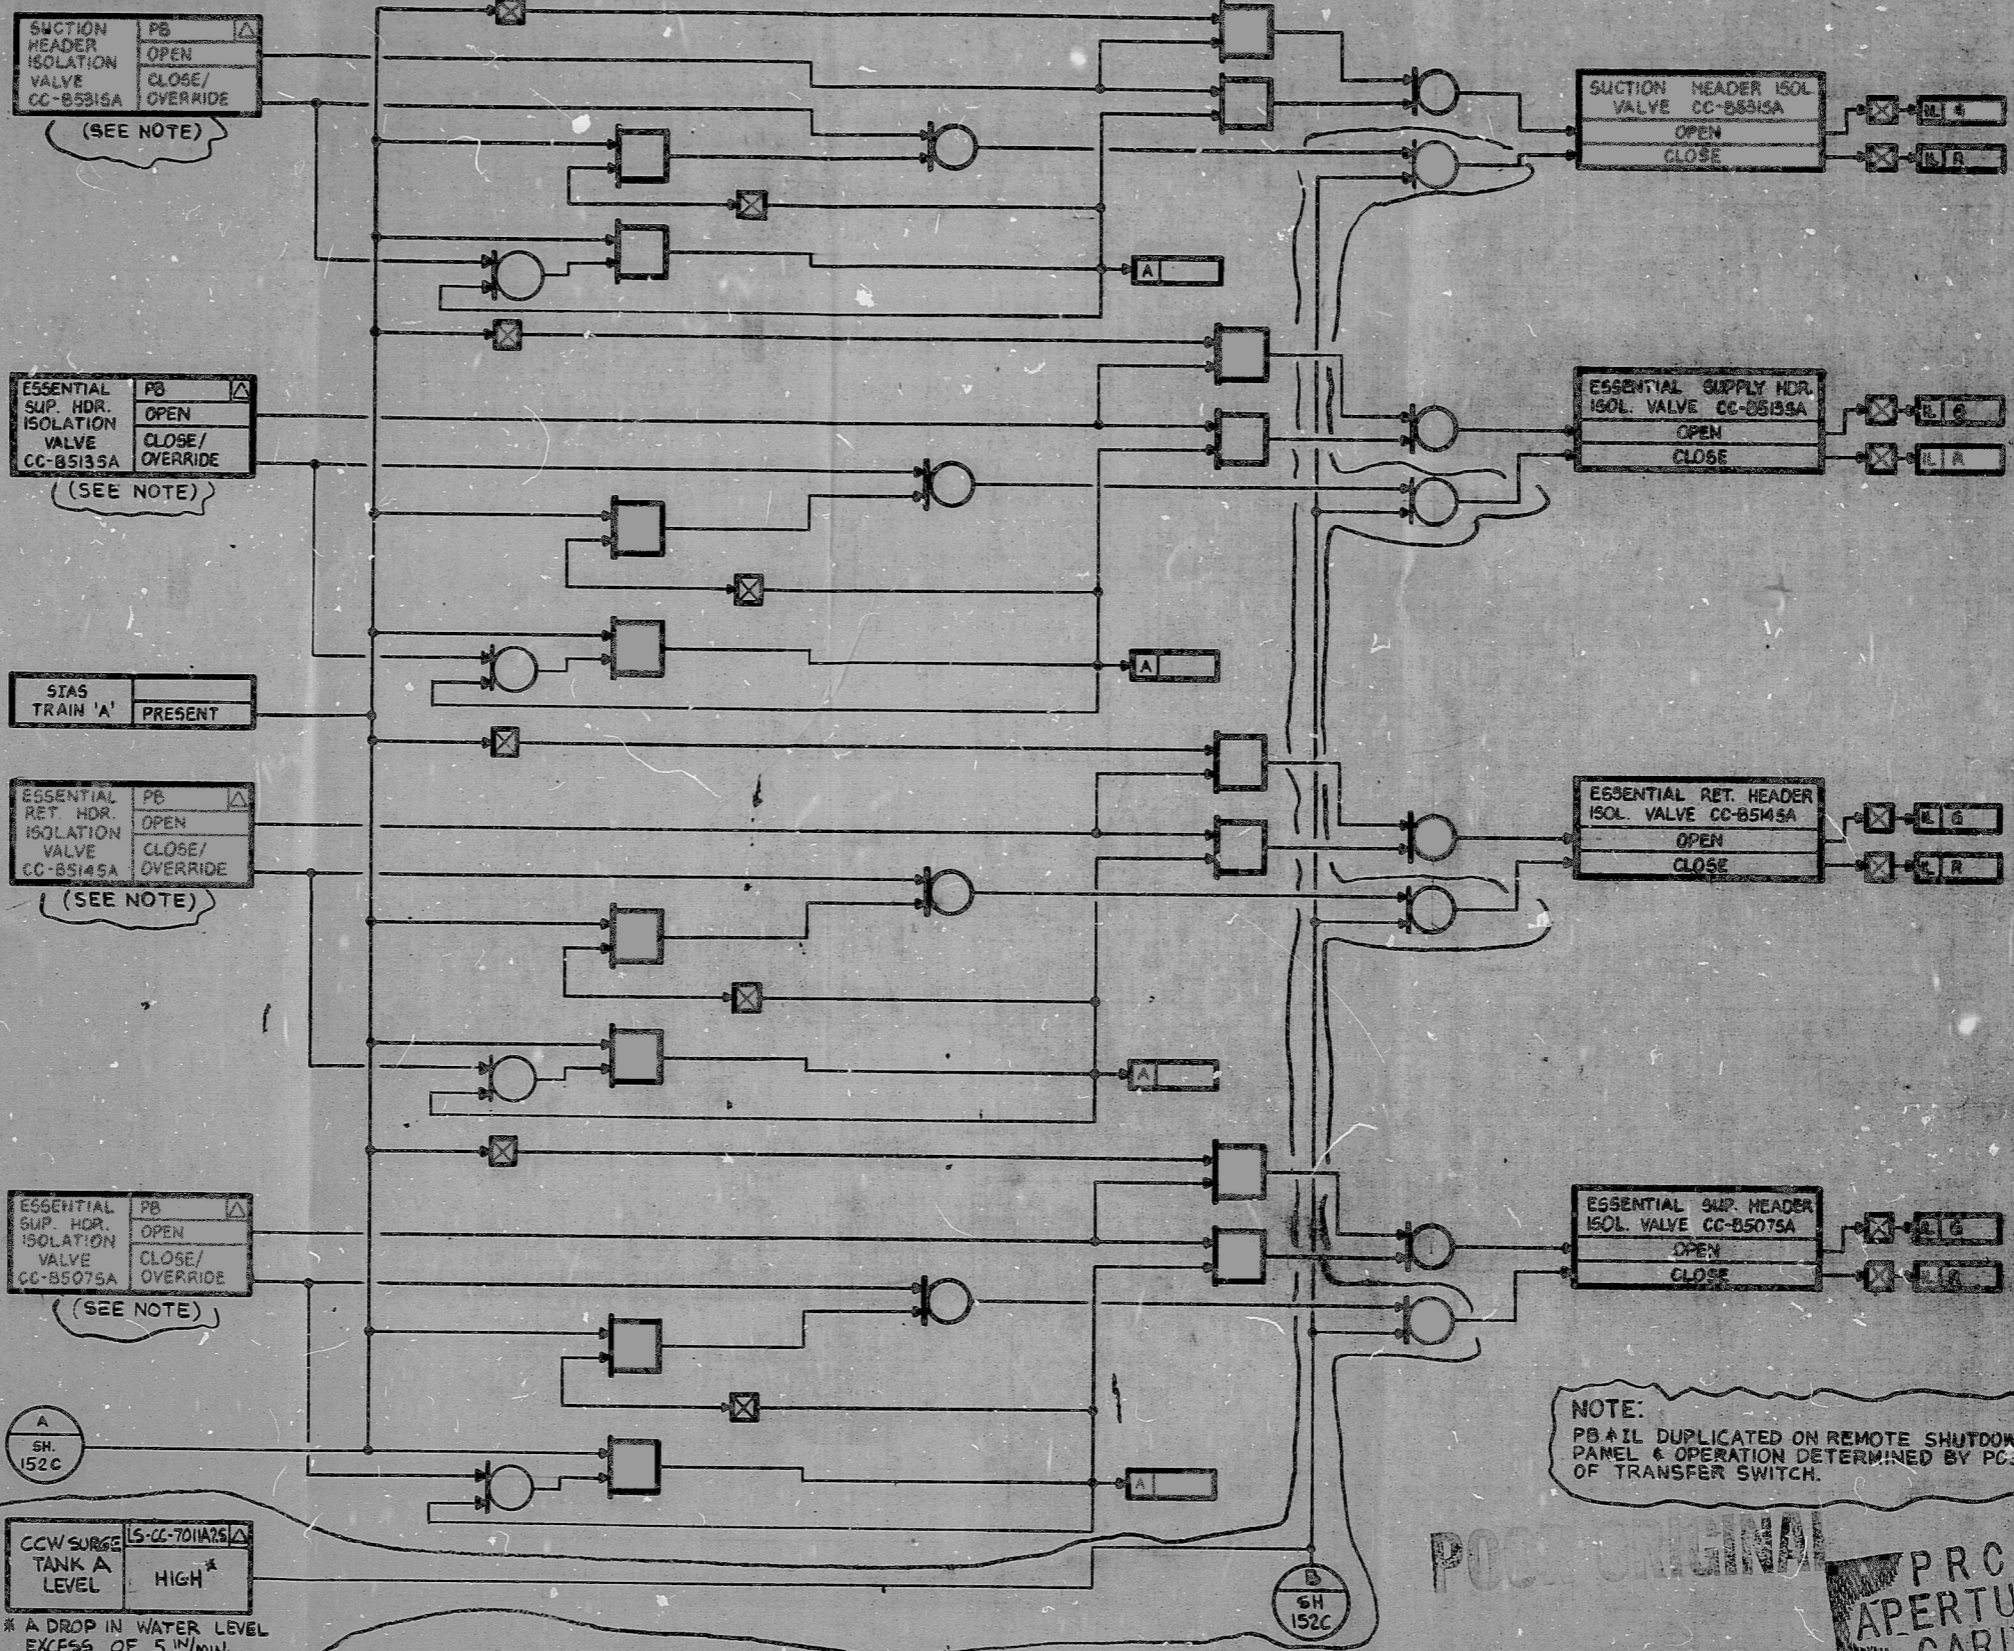

CCW SURGE TANK A LEVEL HIGH
* A DROP IN WATER LEVEL EXCESS OF 5 IN/MIN.

NOTE:
PB A IL DUPLICATED ON REMOTE SHUTDOWN PANEL & OPERATION DETERMINED BY POSITION OF TRANSFER SWITCH.

POCS ORIGINAL
PRC APERTURE CARD

NUCLEAR SAFETY RELATED WPPSS QUALITY CLASS I

| | | | | | | | |
|------|---------|----|----------|------|--------------|----------|--|
| 5 | | | | | | | |
| 4 | | | | | | | |
| 3 | | | | | | | |
| 2 | | | | | | | |
| 1 | 7-29-82 | By | APPROVED | DATE | FEB. 8, 1979 | APPROVED | |
| REV. | DATE | BY | APPROVED | DATE | FEB. 8, 1979 | APPROVED | |

EBASCO SERVICES INCORPORATED
DIV. INSTRUMENTATION DR. BM
CN. A. J. G. D.
DATE FEB. 8, 1979
APPROVED
WASHINGTON PUBLIC POWER SUPPLY SYSTEM
NUCLEAR PROJECT NO 3 of 5
INSTRUMENT SCHEMATIC - LOGIC DIAGRAM
CCW SUCTION & ESSENTIAL HEADER 'A' ISOLATION VALVES
WPPSS-3240
DC060

RIDS

8303110532

