

17"

11"

8.5"

11"

17"

17"


11"

8.5"

8.5"

11"

17"

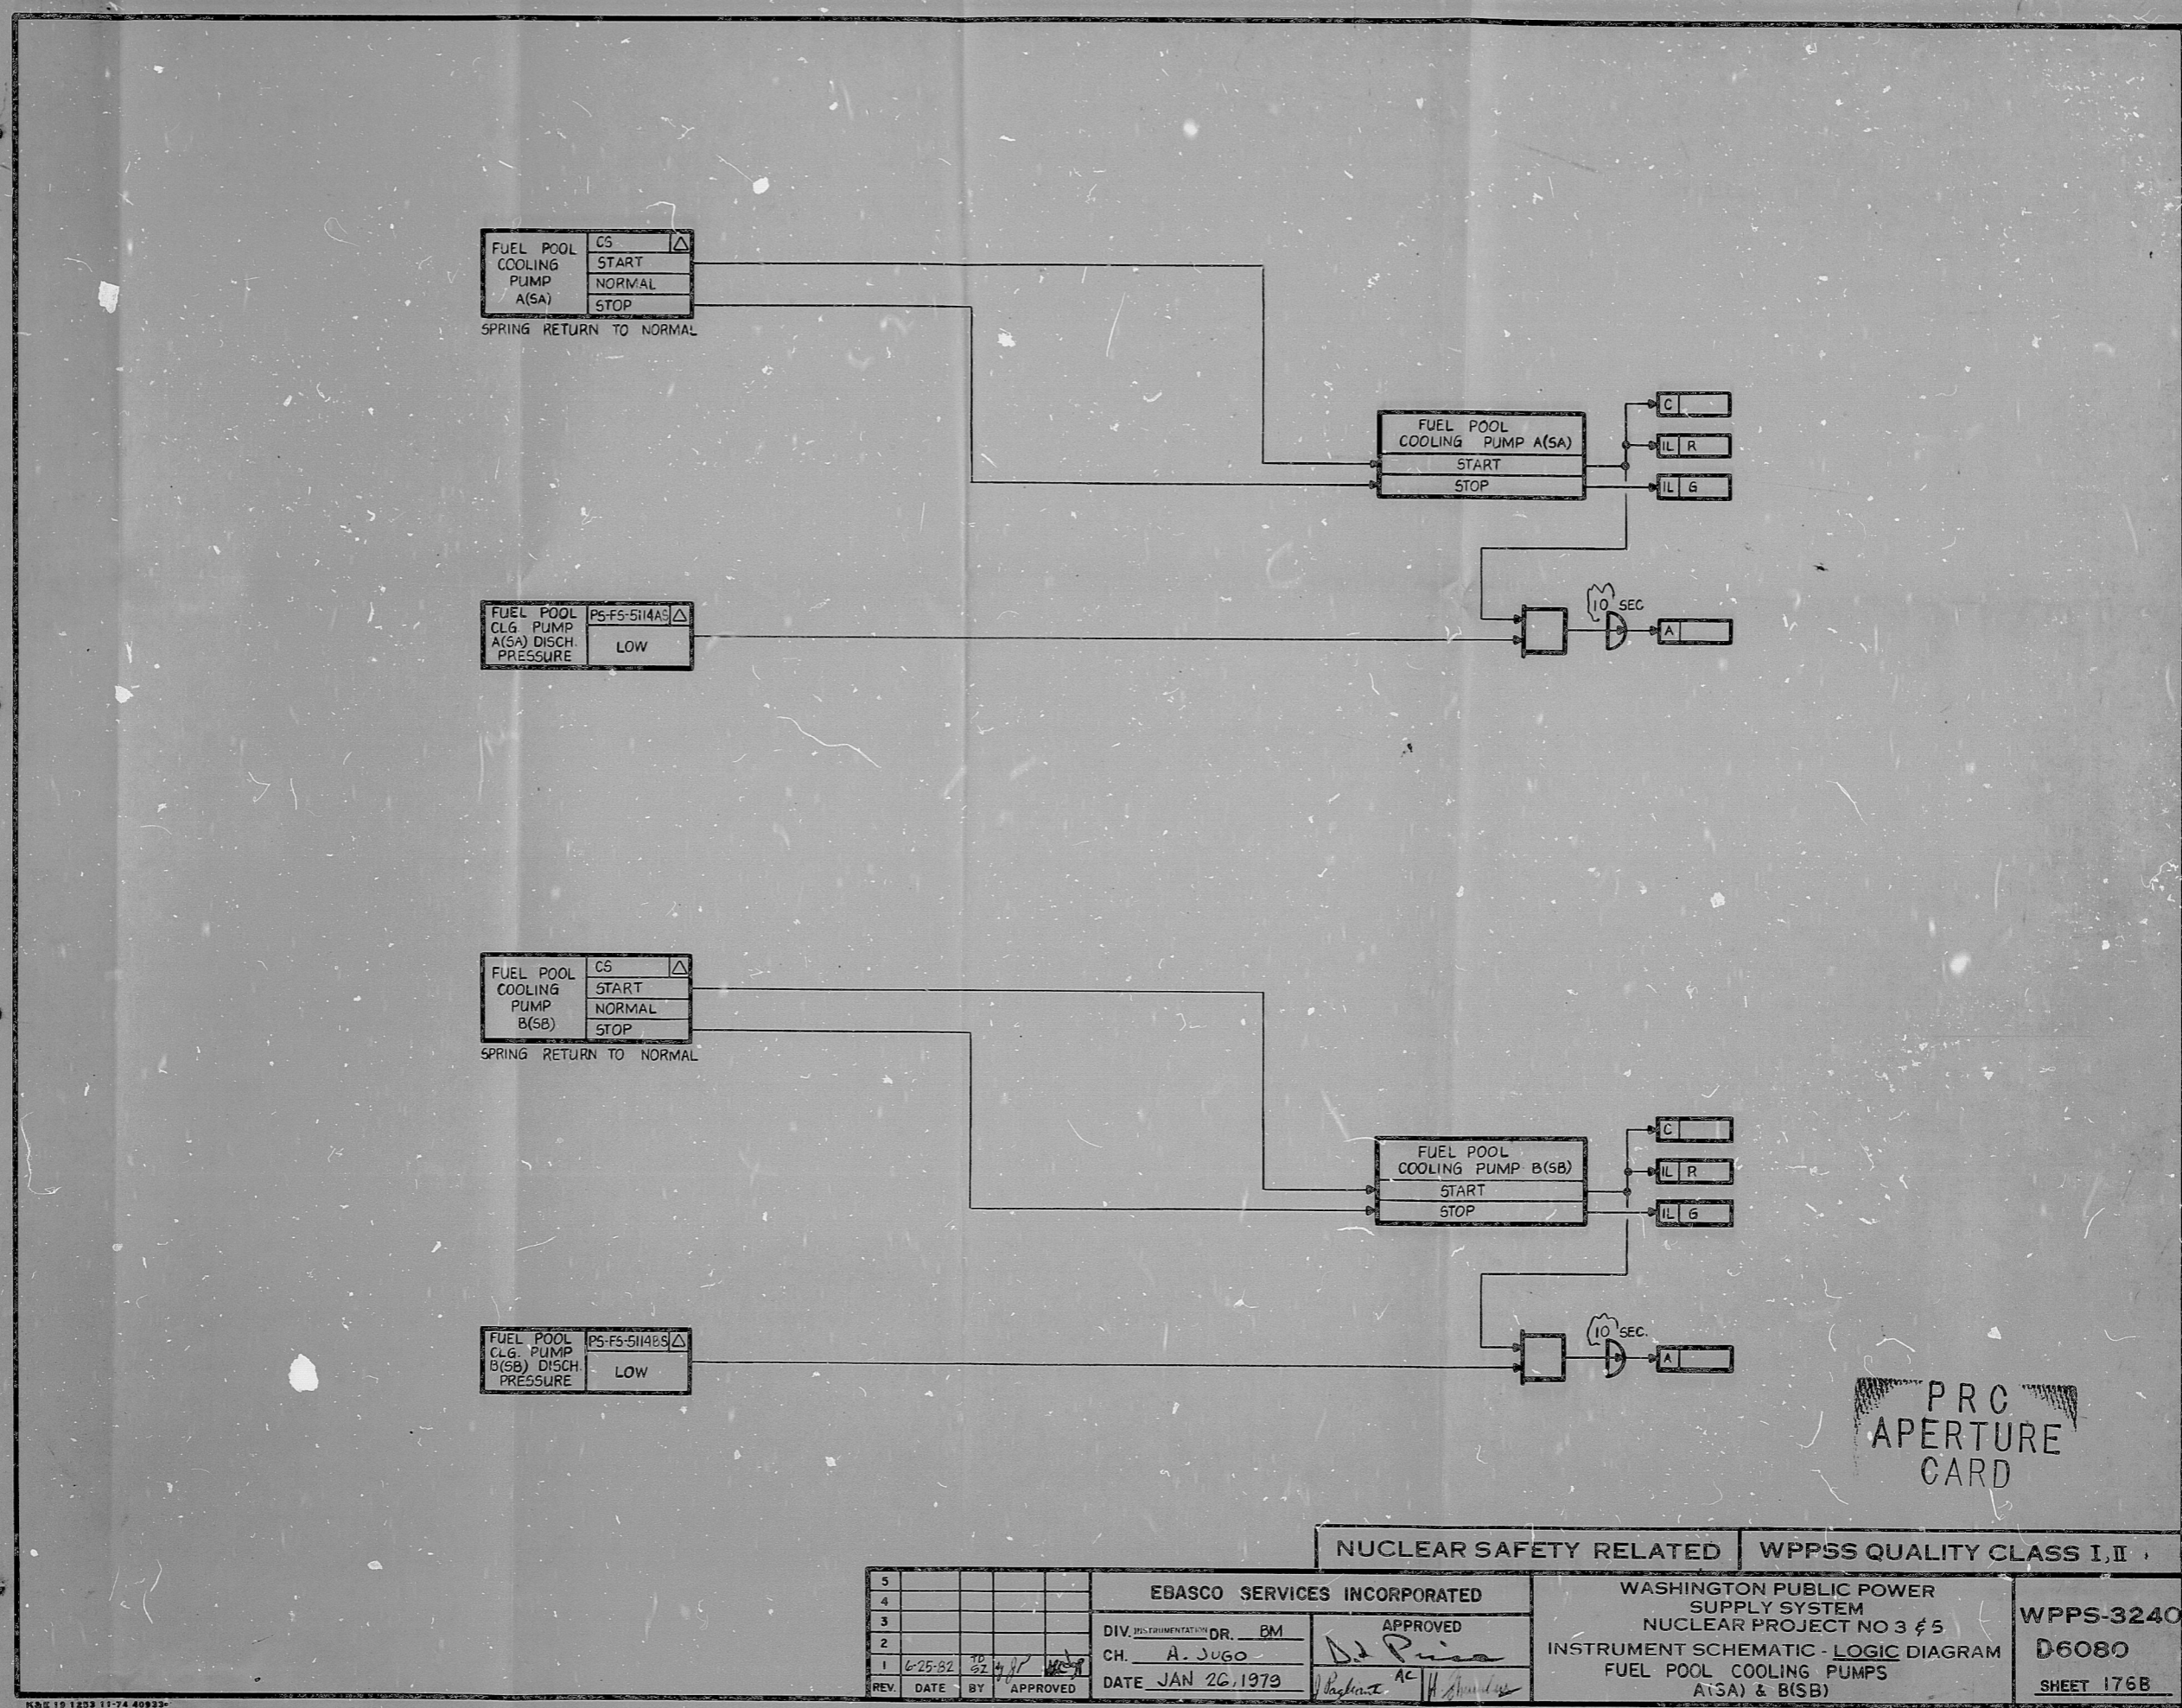

PRC APERTURE CARD

NUCLEAR SAFETY RELATED WPPSS QUALITY CLASS I, II

5									
4									
3									
2									
1	6-25-82	TS	BY	APPROVED	DATE	JAN 26, 1979	APPROVED	AC	

EBASCO SERVICES INCORPORATED

DIV. INSTRUMENTATION DR. BM

CH. A. Jugo

APPROVED

DATE JAN 26, 1979

WASHINGTON PUBLIC POWER SUPPLY SYSTEM NUCLEAR PROJECT NO 3 & 5 INSTRUMENT SCHEMATIC - LOGIC DIAGRAM FUEL POOL COOLING PUMPS (A(SA) & B(SB))

WPPS-3240 D6080 SHEET 176B

HW 19 1253 17-74 40923

RIDS

8303110604

