






RIDS

8109290162

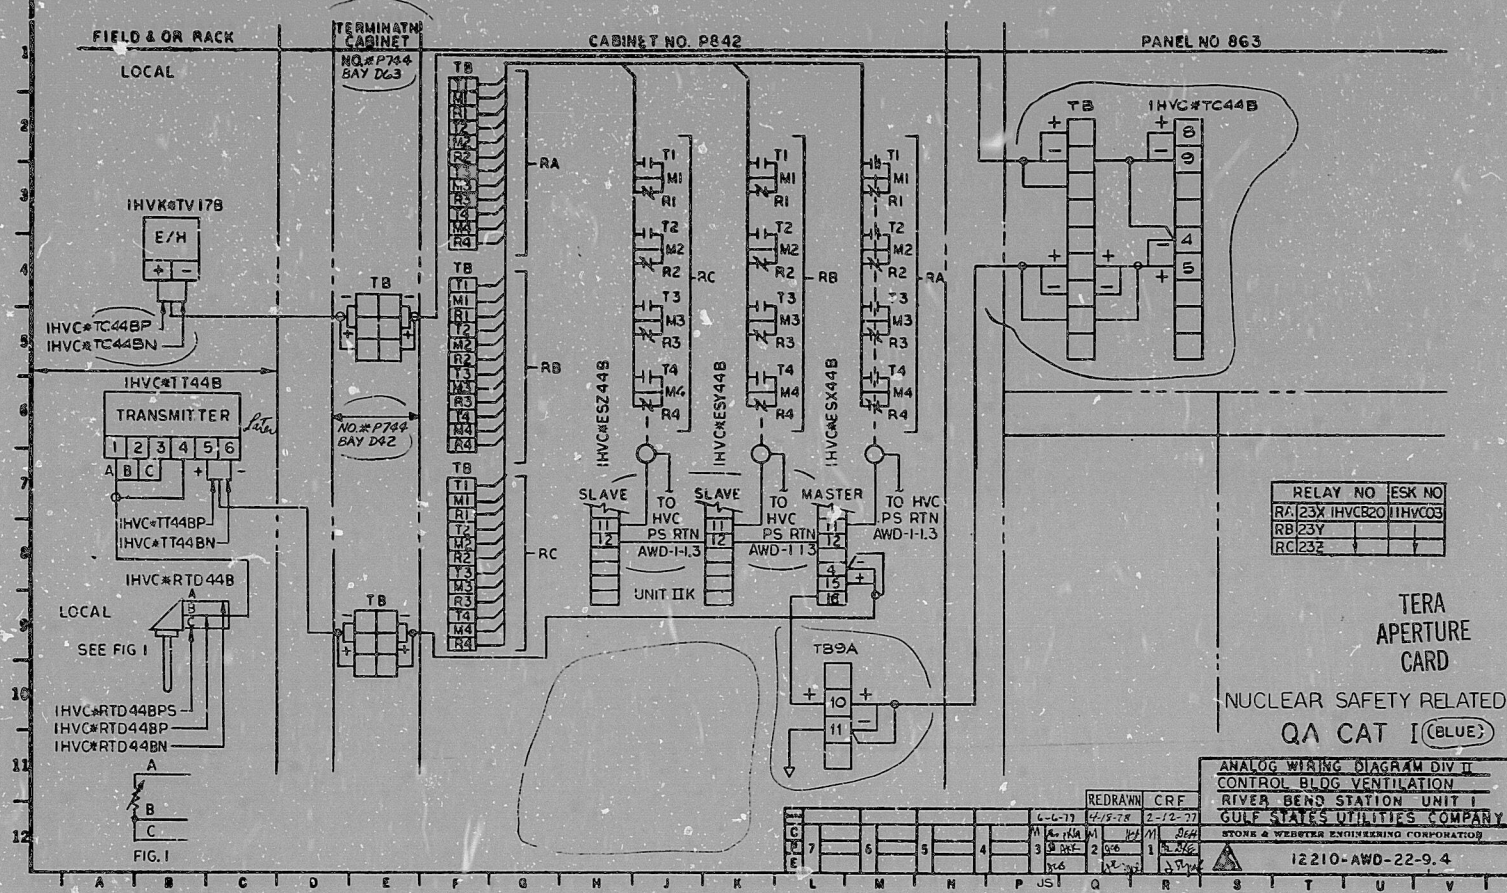