


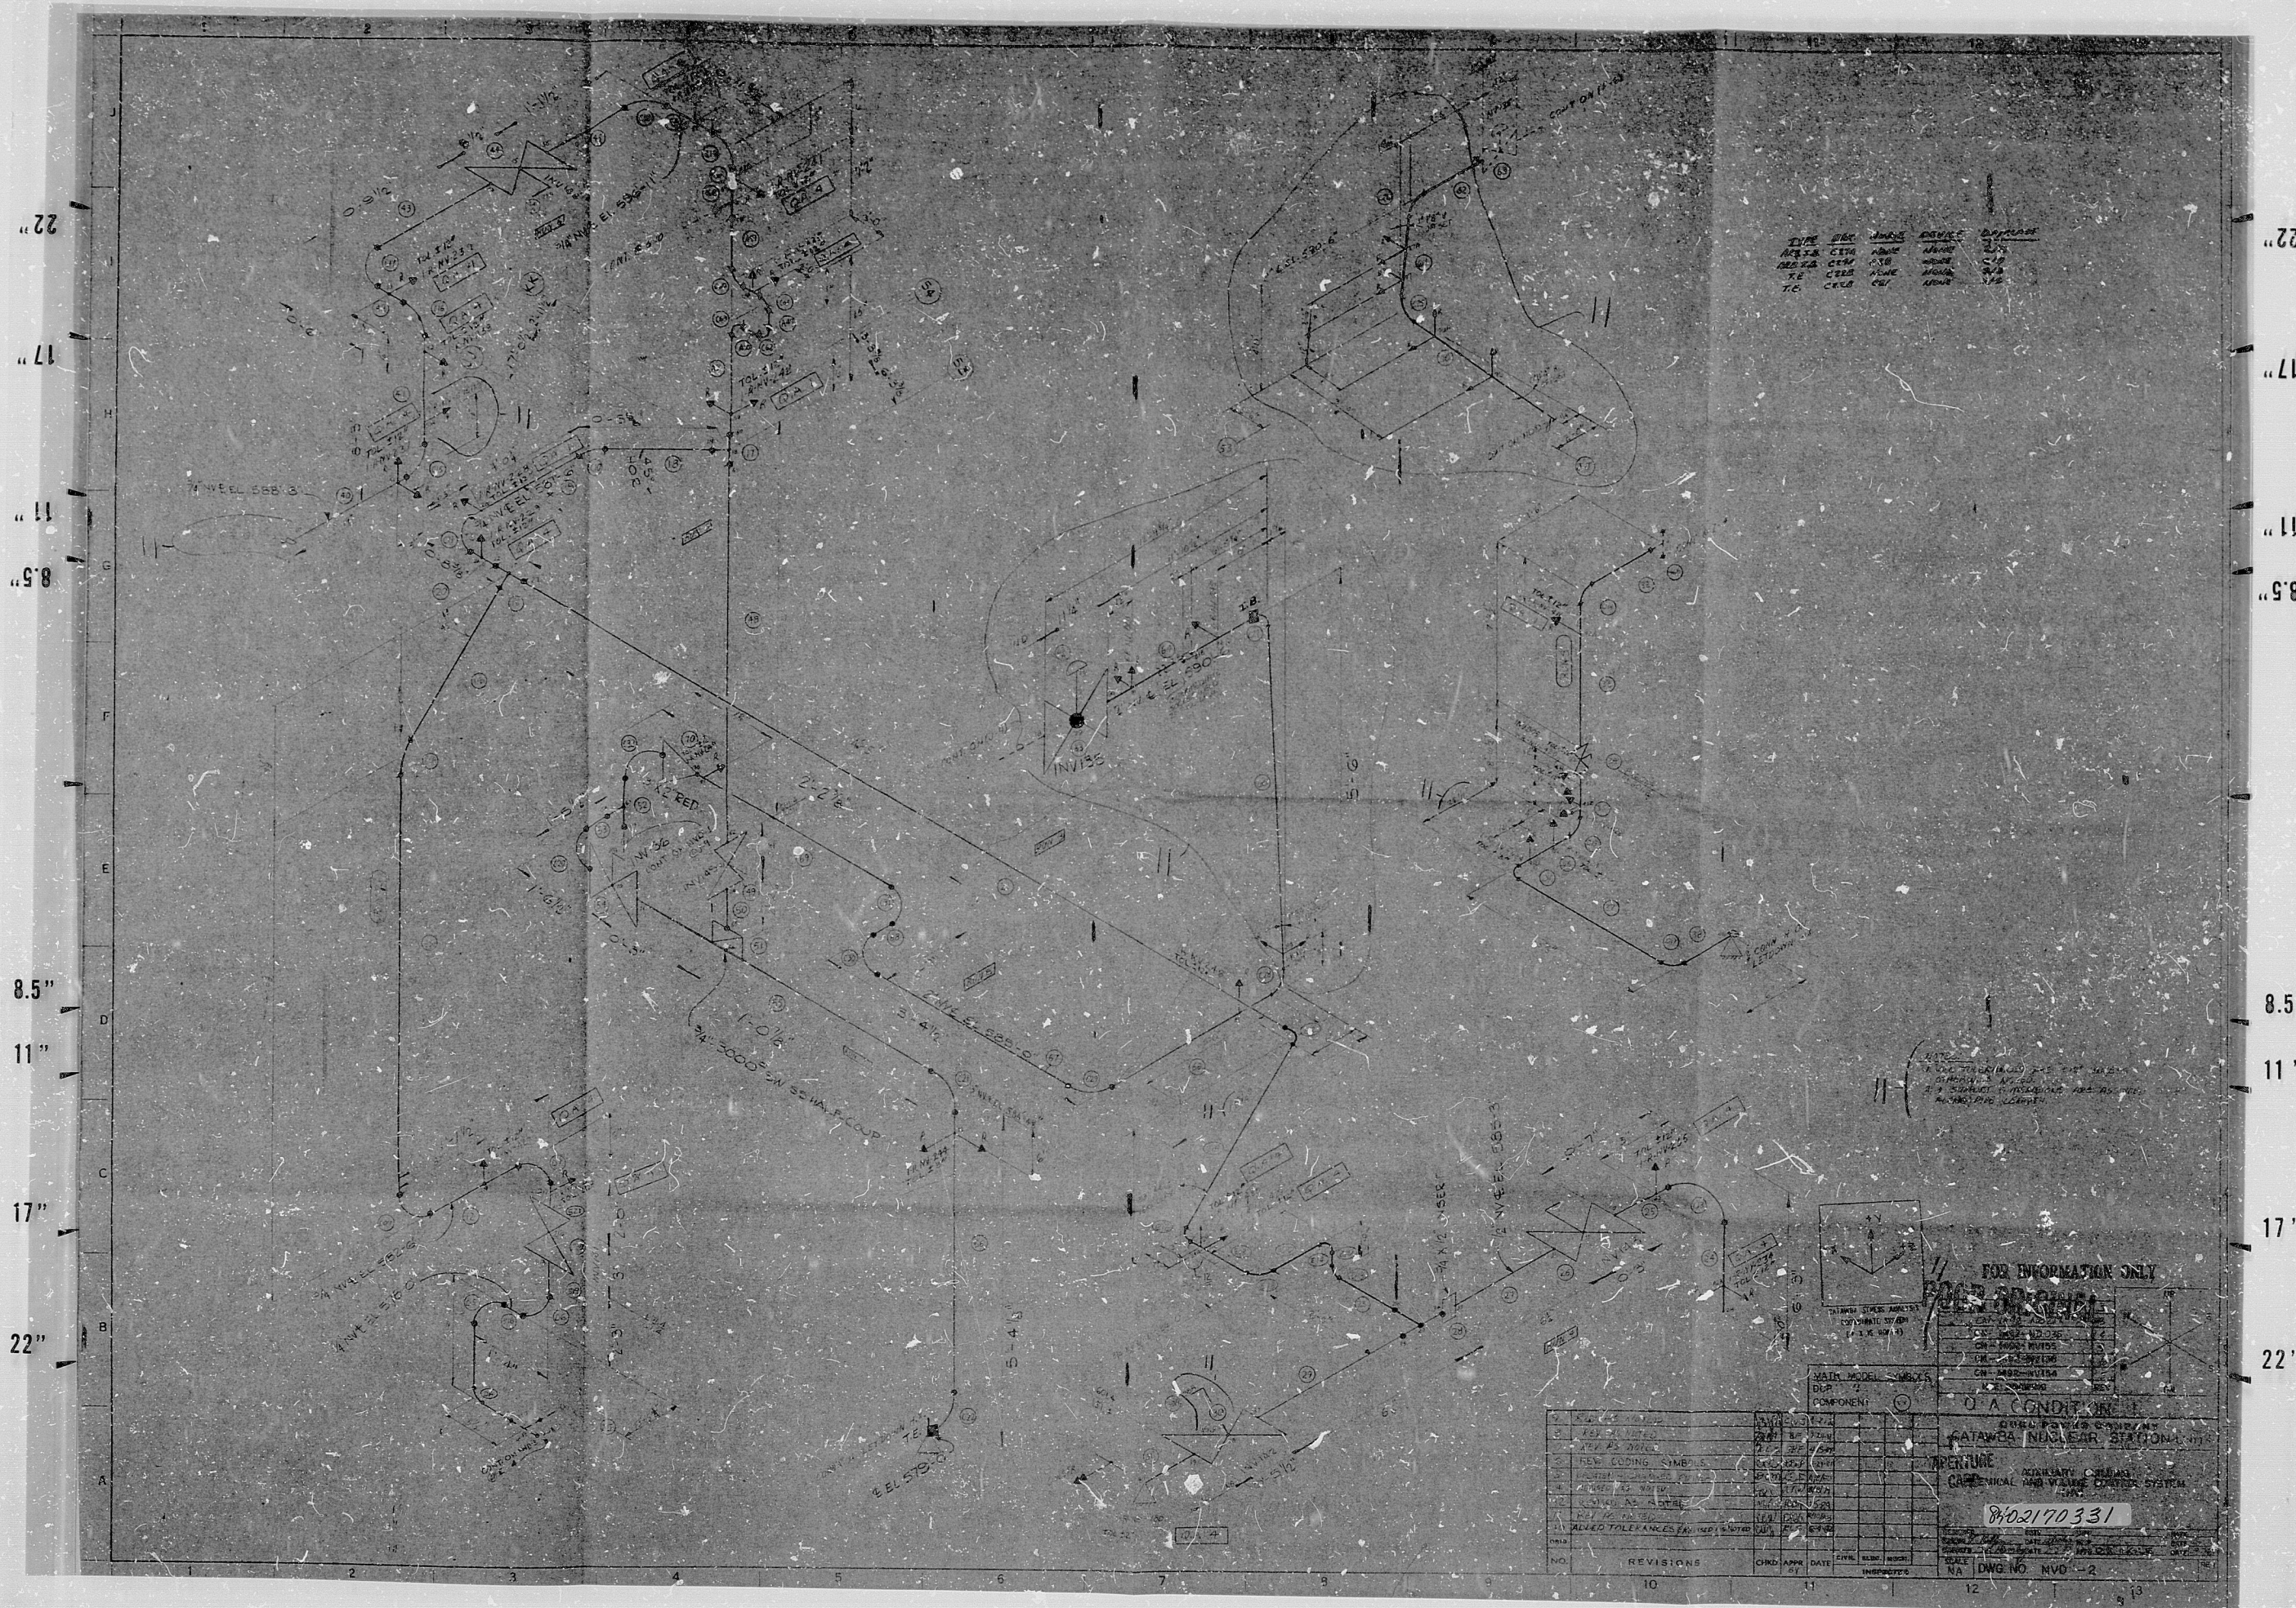

PDR RIDS

8402170331

