



E-0307-0(Q)

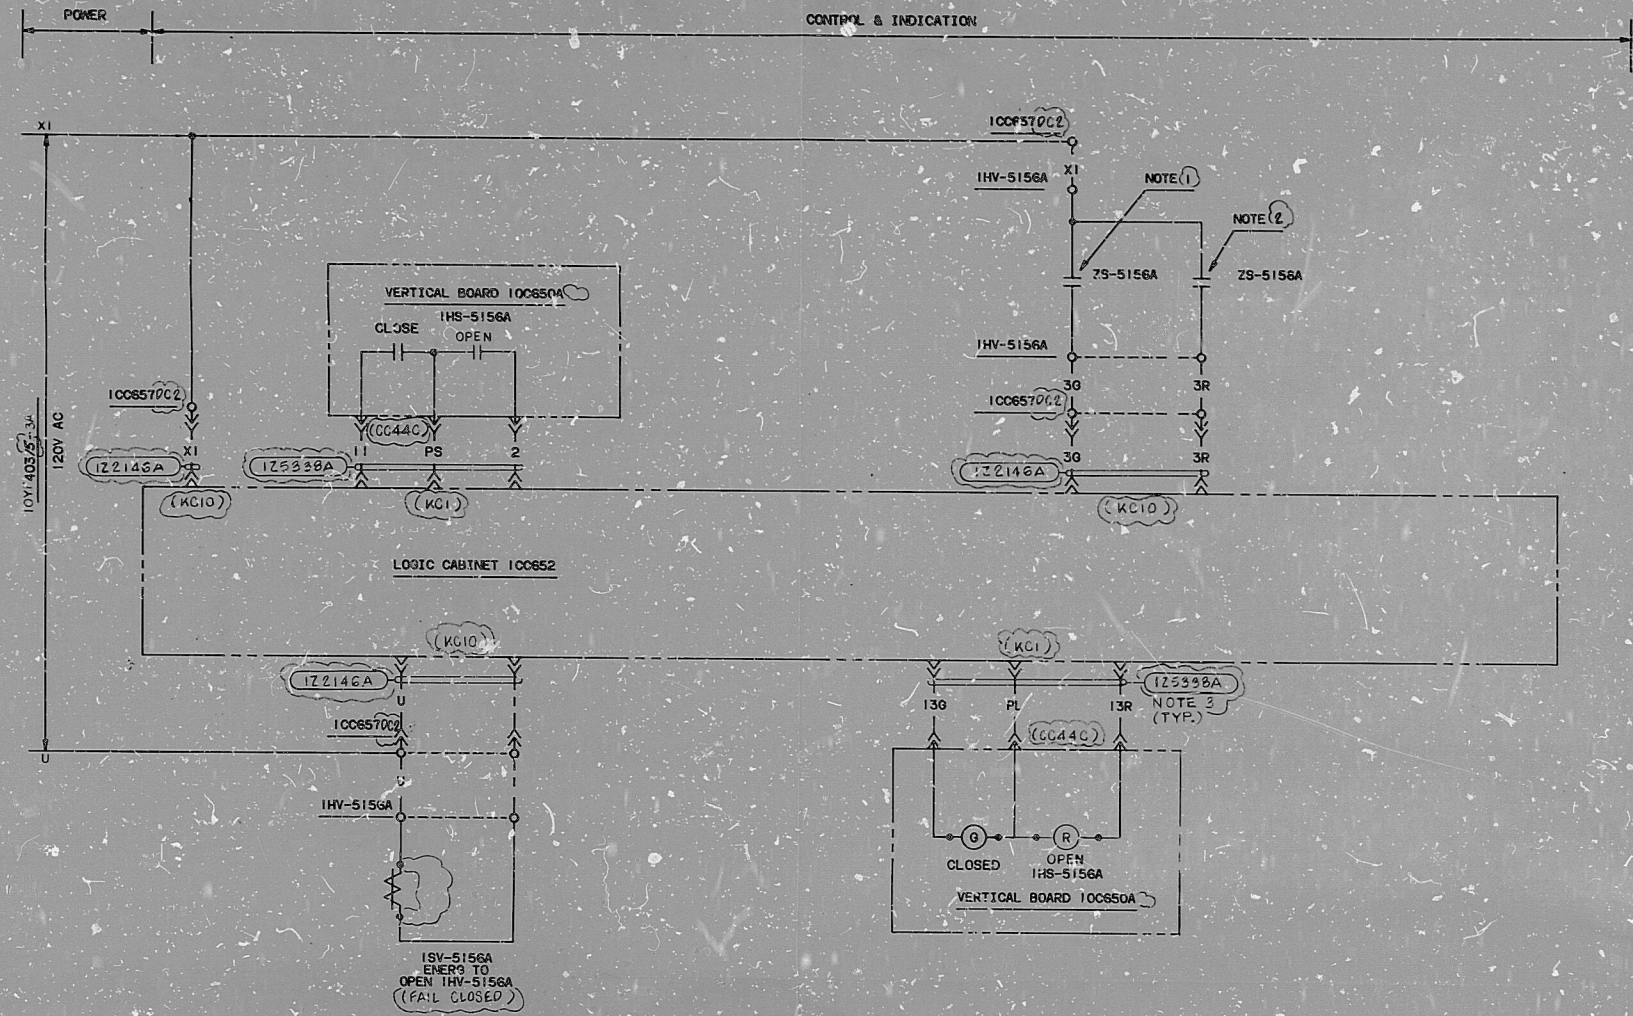

SUPPLY HDR. INTERCONNECTING ISOLATION VALVE IHV-5156A
SCHEME NO. IS0905, CLASS IE CHANNEL, C. S/U-KL
(JUST TAG NO. ICL - - -)

SERVICE	SCHEME NO.	ISLN. VALVE	TERMINAL CABLE	VERT. BOARD	CLASS IE CHANNEL	CONTROL SW. MOD. NO.	SOLENOID VALVE	FUSE PNL	FUSE NO.	FUSE SIZE	SCHEME CABLE NO. (REF. 5)
SUPPLY HDR. INTERCON. VALVE	IS0905	IHV-5156A	10065702	100650A	C	IHS-5156A	SV-5156A	10YF403	5	3A	12538A 12214A
SUPPLY HDR. INTERCON. VALVE	IS0906	IHV-5156B	10065702	100650A	D	IHS-5156B	SV-5156B	10YF404	4	3A	12538A 12213A
TORUS ISLN. OUTBD. VALVE	IS0907	IHV-5154	10065702	100650A	D	IHS-5154	SV-5154	10YF404	10	3A	12538A 12213A
TORUS ISLN. INBD. VALVE	IS0908	IHV-5155	10065702	100650A	A	IHS-5155	SV-5155	10YF404	7	3A	12538A 12213A
TIP PURGE CONTNMT. ISLN. VALVE	IS0909	IHV-5161	10065702	100650A	D	IHS-5161	SV-5161	10YF404	9	3A	12538A 12213A

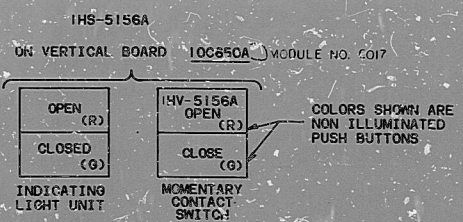

LOGIC CABINET	VERT. BOARD	TERMINAL CABLE
100652 KPI0 KPI CC440	100650 KPI CC440	100652 KPI0 KPI CC440
100652 KPI0 KPI CC440	100650 KPI0 KPI CC440	100652 KPI0 KPI CC440
100652 KPI0 KPI CC440	100650 KPI0 KPI CC440	100652 KPI0 KPI CC440

REFERENCE DRAWINGS:

- LOGIC DIAR J-59-010, SH. 1
- BAILEY CO. DWG. 10065-1200(0) 103, 308, 370, 400, 405
- PAID M-59-110, SH. 1
- CABLE BLOCK DIAG. E-4307-0
- BAILEY CO. CABLE TABLE 10065-1200(0) 21-24 SHTS. 5, 12; 2276 SHTS. 5, 14; 2277 SHTS. 5, 17; DECHTEL C.O.D. E-4516-0, E-4518-0, E-4519-0

NOTES:

- NOT 100% OPEN.
- NOT 100% CLOSED.
- THESE CONDUCTORS ARE INCLUDED IN A CABLE PROVIDED AS PART OF THE J200(0) CONTROL ROOM COMPLEX. A PARTICULAR CABLE IS DESIGNATED BY A CABLE SCHEME NUMBER ENCLOSED IN THIS MANNER. THESE CABLES ARE LISTED IN THE CABLE SCHEDULE FROM REFERENCE 5.

DATE	DESIGNED	BY	CHD	DESIGN	ENGR	PROJ	APPR
7/25/61	S. MULLICK	A. G.					
DECHTEL SAN FRANCISCO							
PUBLIC SERVICE ELECTRIC AND GAS COMPANY HOPE CREEK GENERATING STATION							
ELECTRICAL SCHEMATIC DIAGRAM PRIMARY CONTAINMENT INSTRUMENT GAS ISOLATION VALVES							
JOB No.	DRAWING No.	REV.					
10055	E-0307-0	1 Q					

PRO
APERTURE
CARD

PDR RIDS

8402170336

