


17"
11"
8.5"
8.5"
10"
17"

17"
11"
8.5"
8.5"
11"
17"

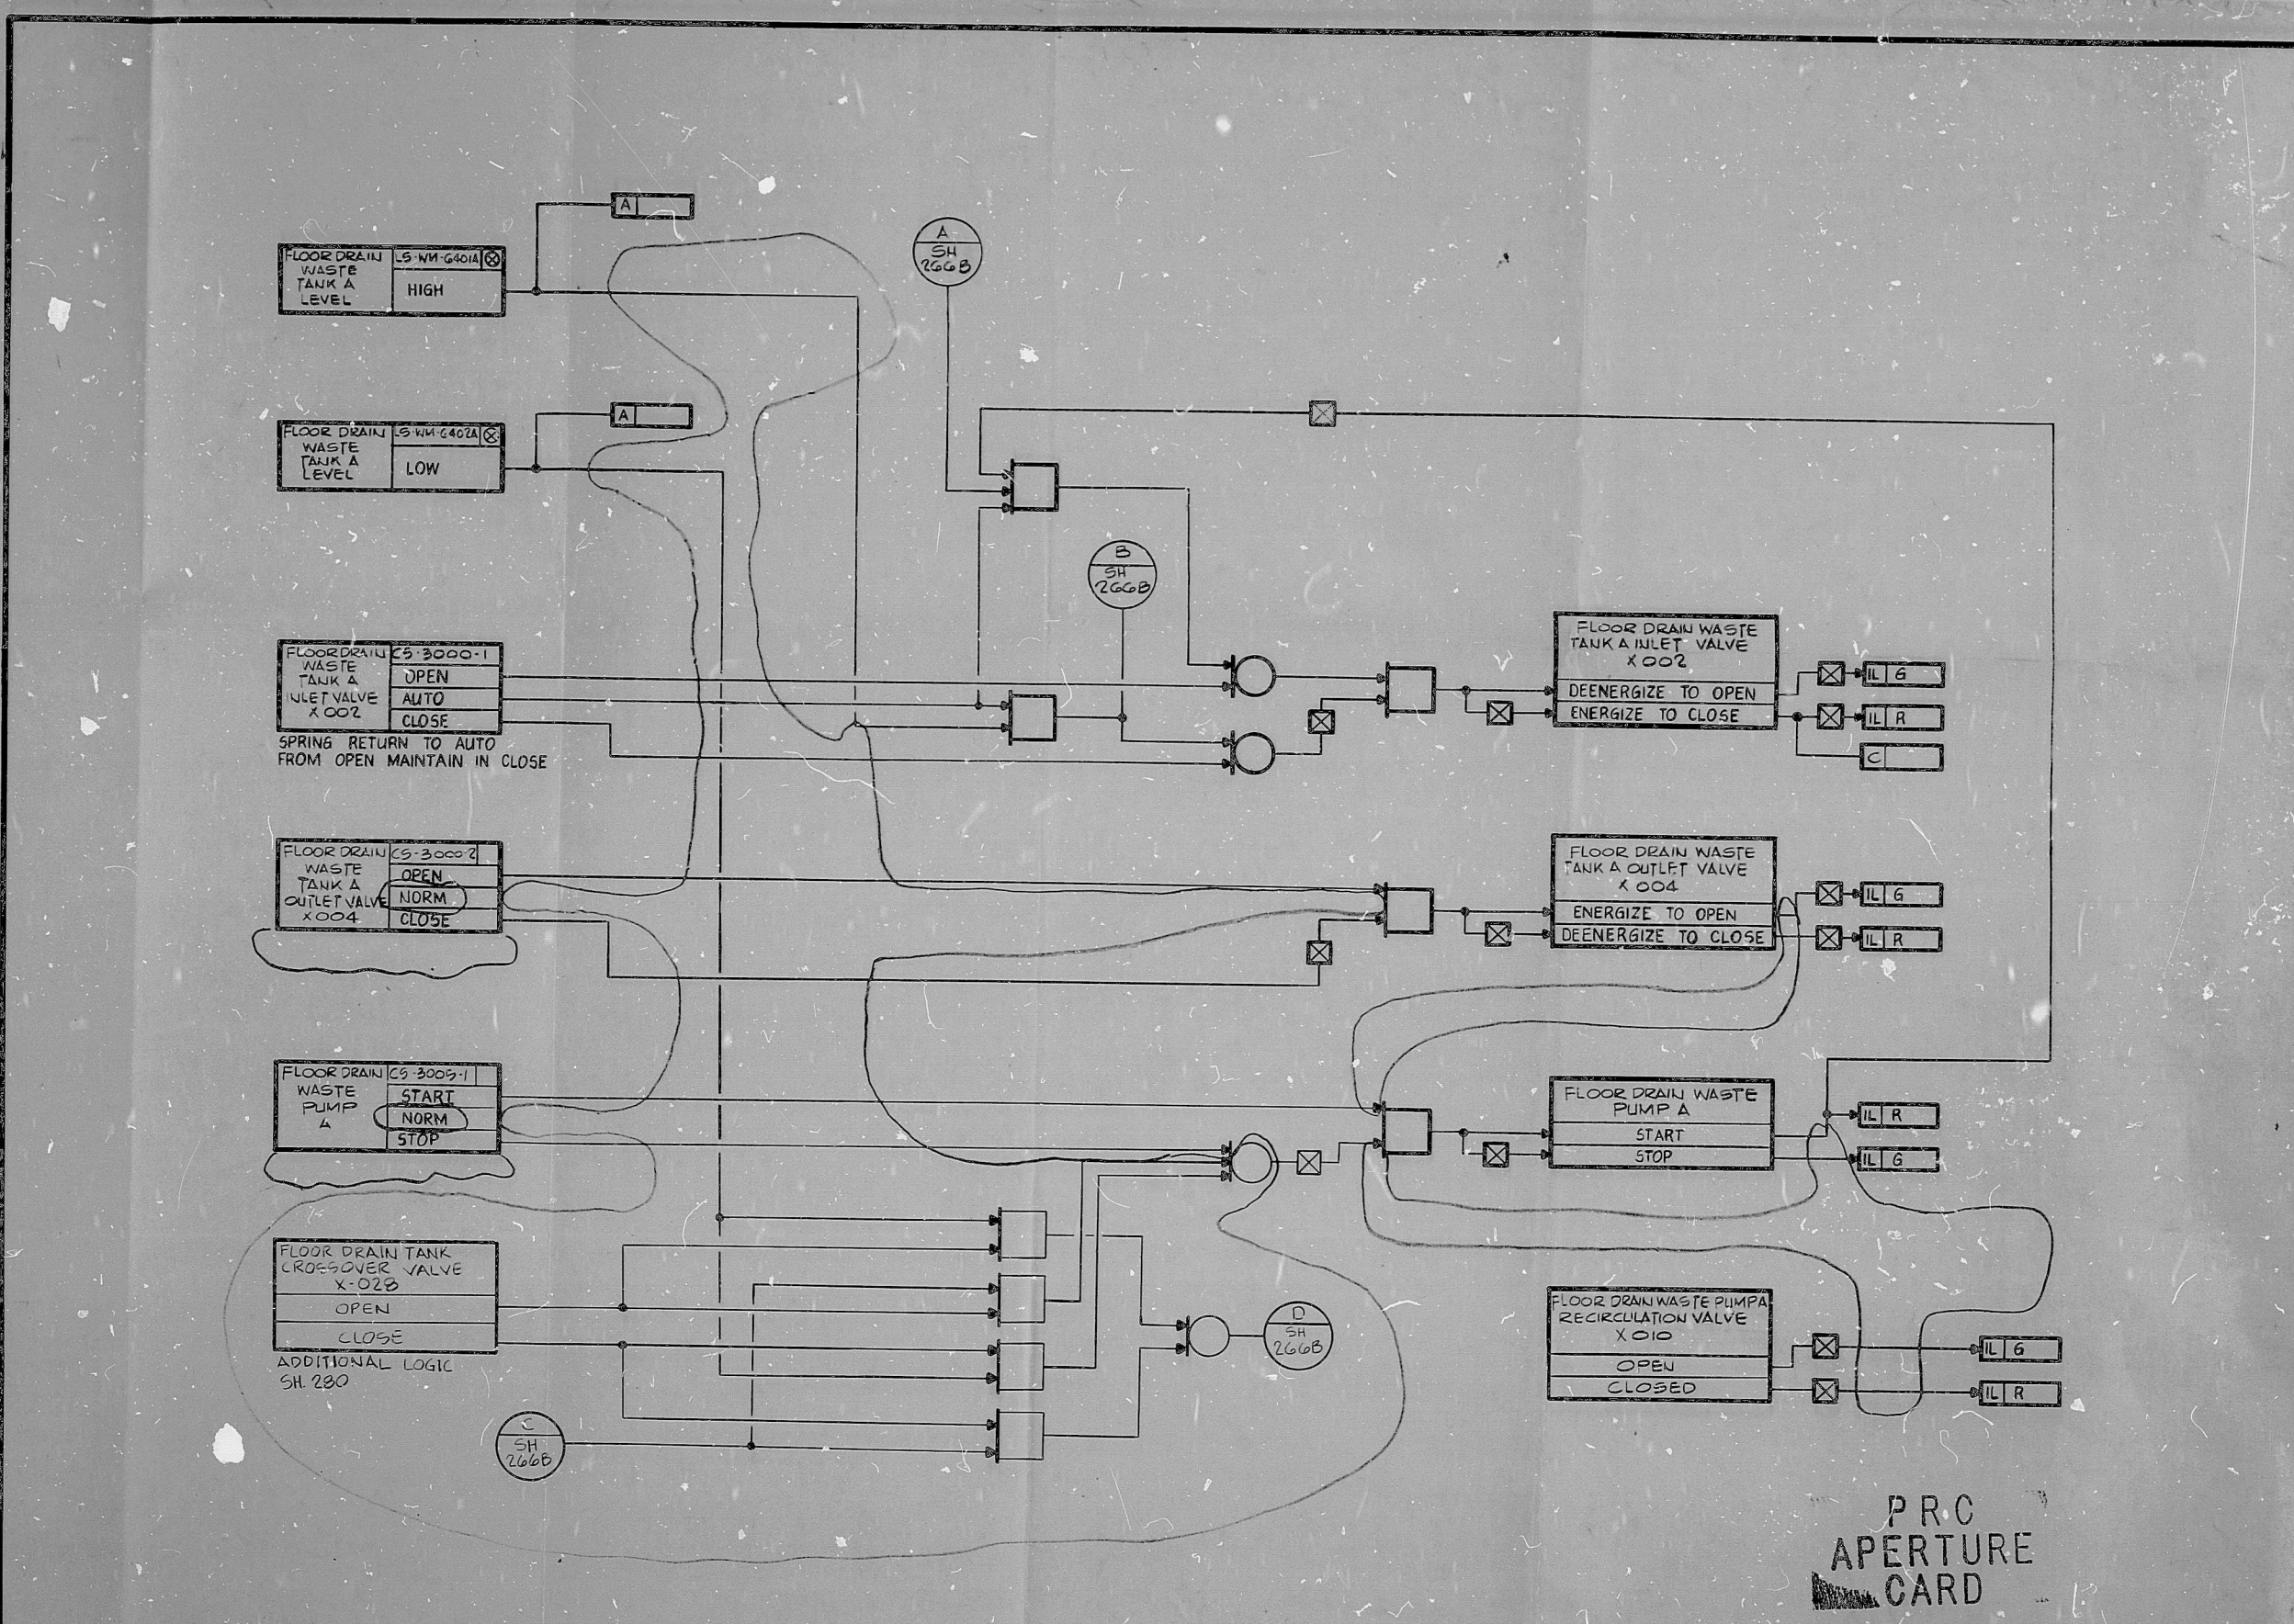

PRC
APERTURE
CARD

NOTE:
1-ALL SWITCHES ARE SPRING RETURN TO CENTER POSITION
UNLESS OTHERWISE NOTED

<table border="1"> <tr><td>5</td><td></td><td></td><td></td></tr> <tr><td>4</td><td></td><td></td><td></td></tr> <tr><td>3</td><td></td><td></td><td></td></tr> <tr><td>2</td><td>3-10-80</td><td>DFD</td><td>CH. J. PAGLIANTI</td></tr> <tr><td>1</td><td>1-22-79</td><td>RFE</td><td>CH. J. PAGLIANTI</td></tr> <tr><td>REV.</td><td>DATE</td><td>BY</td><td>APPROVED</td></tr> </table>				5				4				3				2	3-10-80	DFD	CH. J. PAGLIANTI	1	1-22-79	RFE	CH. J. PAGLIANTI	REV.	DATE	BY	APPROVED	EBASCO SERVICES INCORPORATED DIV. INSTRUMENTATION DR. BM CH. J. PAGLIANTI DATE APRIL 20, 1976		APPROVED J. J. Jones Jan 83P		WASHINGTON PUBLIC POWER SUPPLY SYSTEM NUCLEAR PROJECT NO 3 & 5 INSTRUMENT SCHEMATIC - LOGIC DIAGRAM FLOOR DRAIN TANK 'A'		WPPSS QUALITY CLASS II WPPS-3240 D6080 SHEET 265B	
5																																			
4																																			
3																																			
2	3-10-80	DFD	CH. J. PAGLIANTI																																
1	1-22-79	RFE	CH. J. PAGLIANTI																																
REV.	DATE	BY	APPROVED																																

HRB 10 1283 11-74 40932

RIDS

8303140028

