


9699-FM-8A

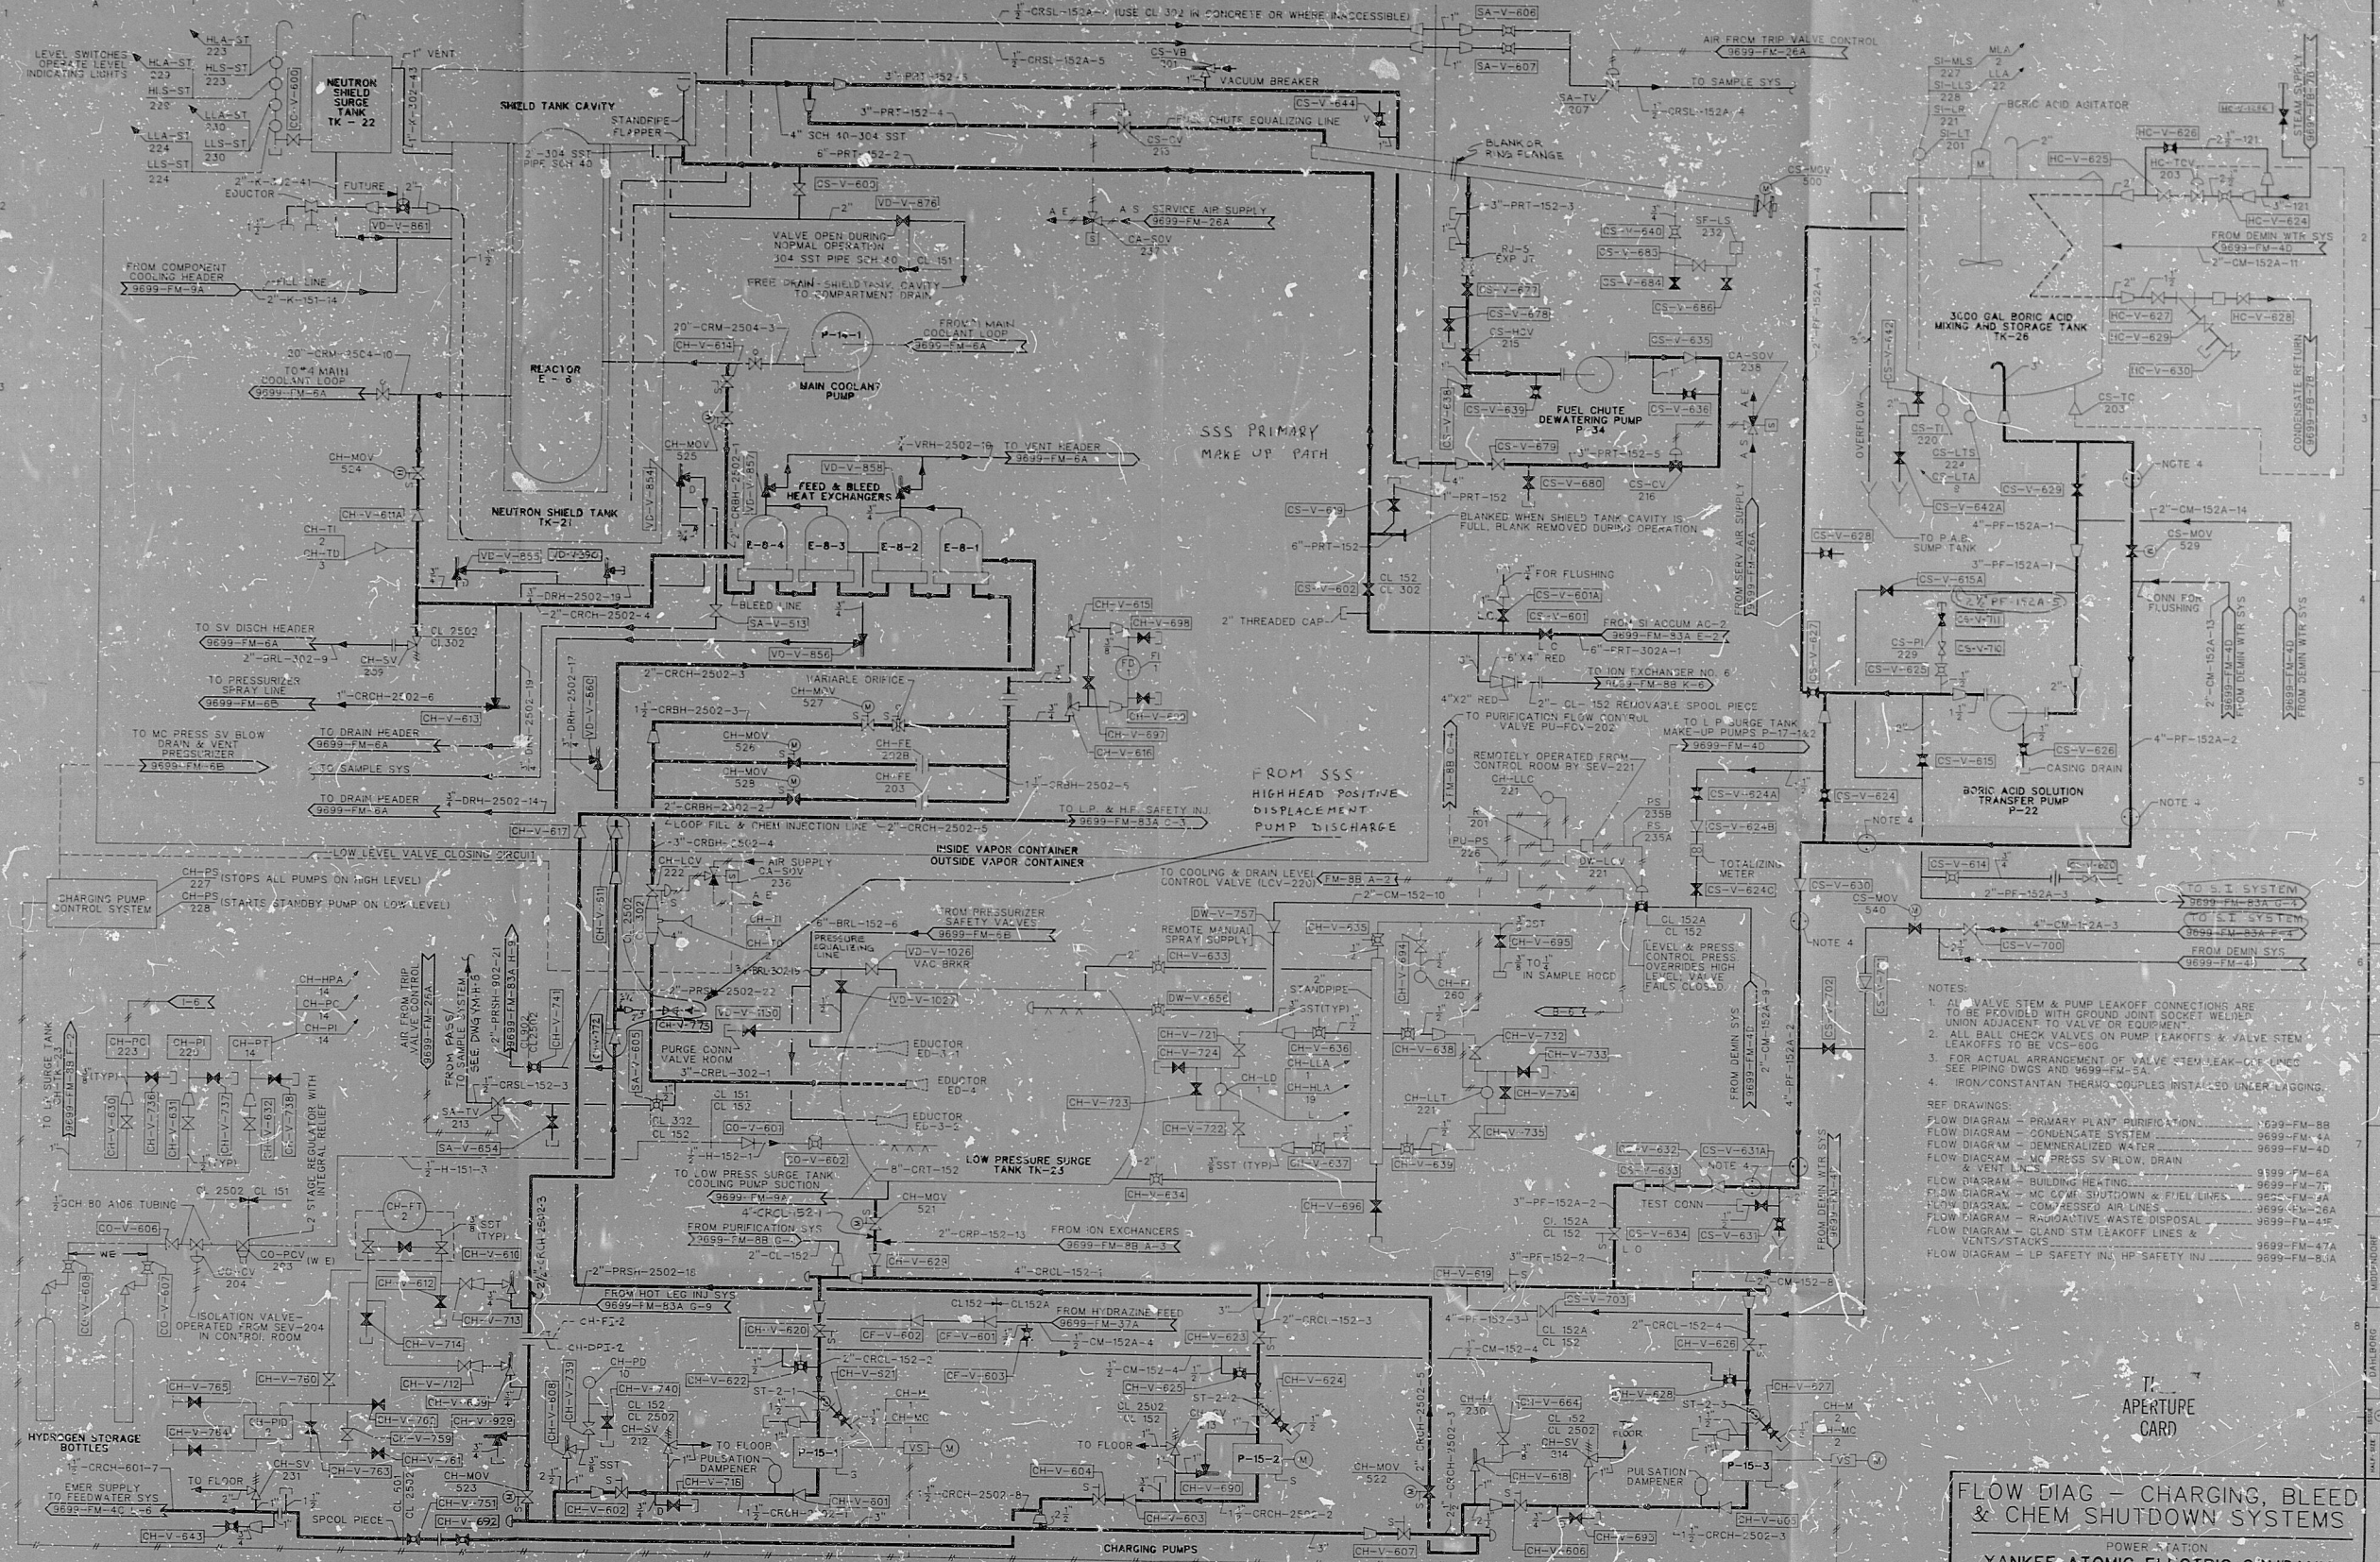

FLOW DIAG - CHARGING, BLEED & CHEM SHUTDOWN SYSTEMS
POWER STATION
YANKEE ATOMIC ELECTRIC COMPANY
ROXBURY, MASSACHUSETTS
STONE & WEBSTER ENGINEERING CORPORATION
BOSTON, MASS.
DRAWING NUMBER 9699-FM-8A

8402220207







PDR RIDS

8402220207

