


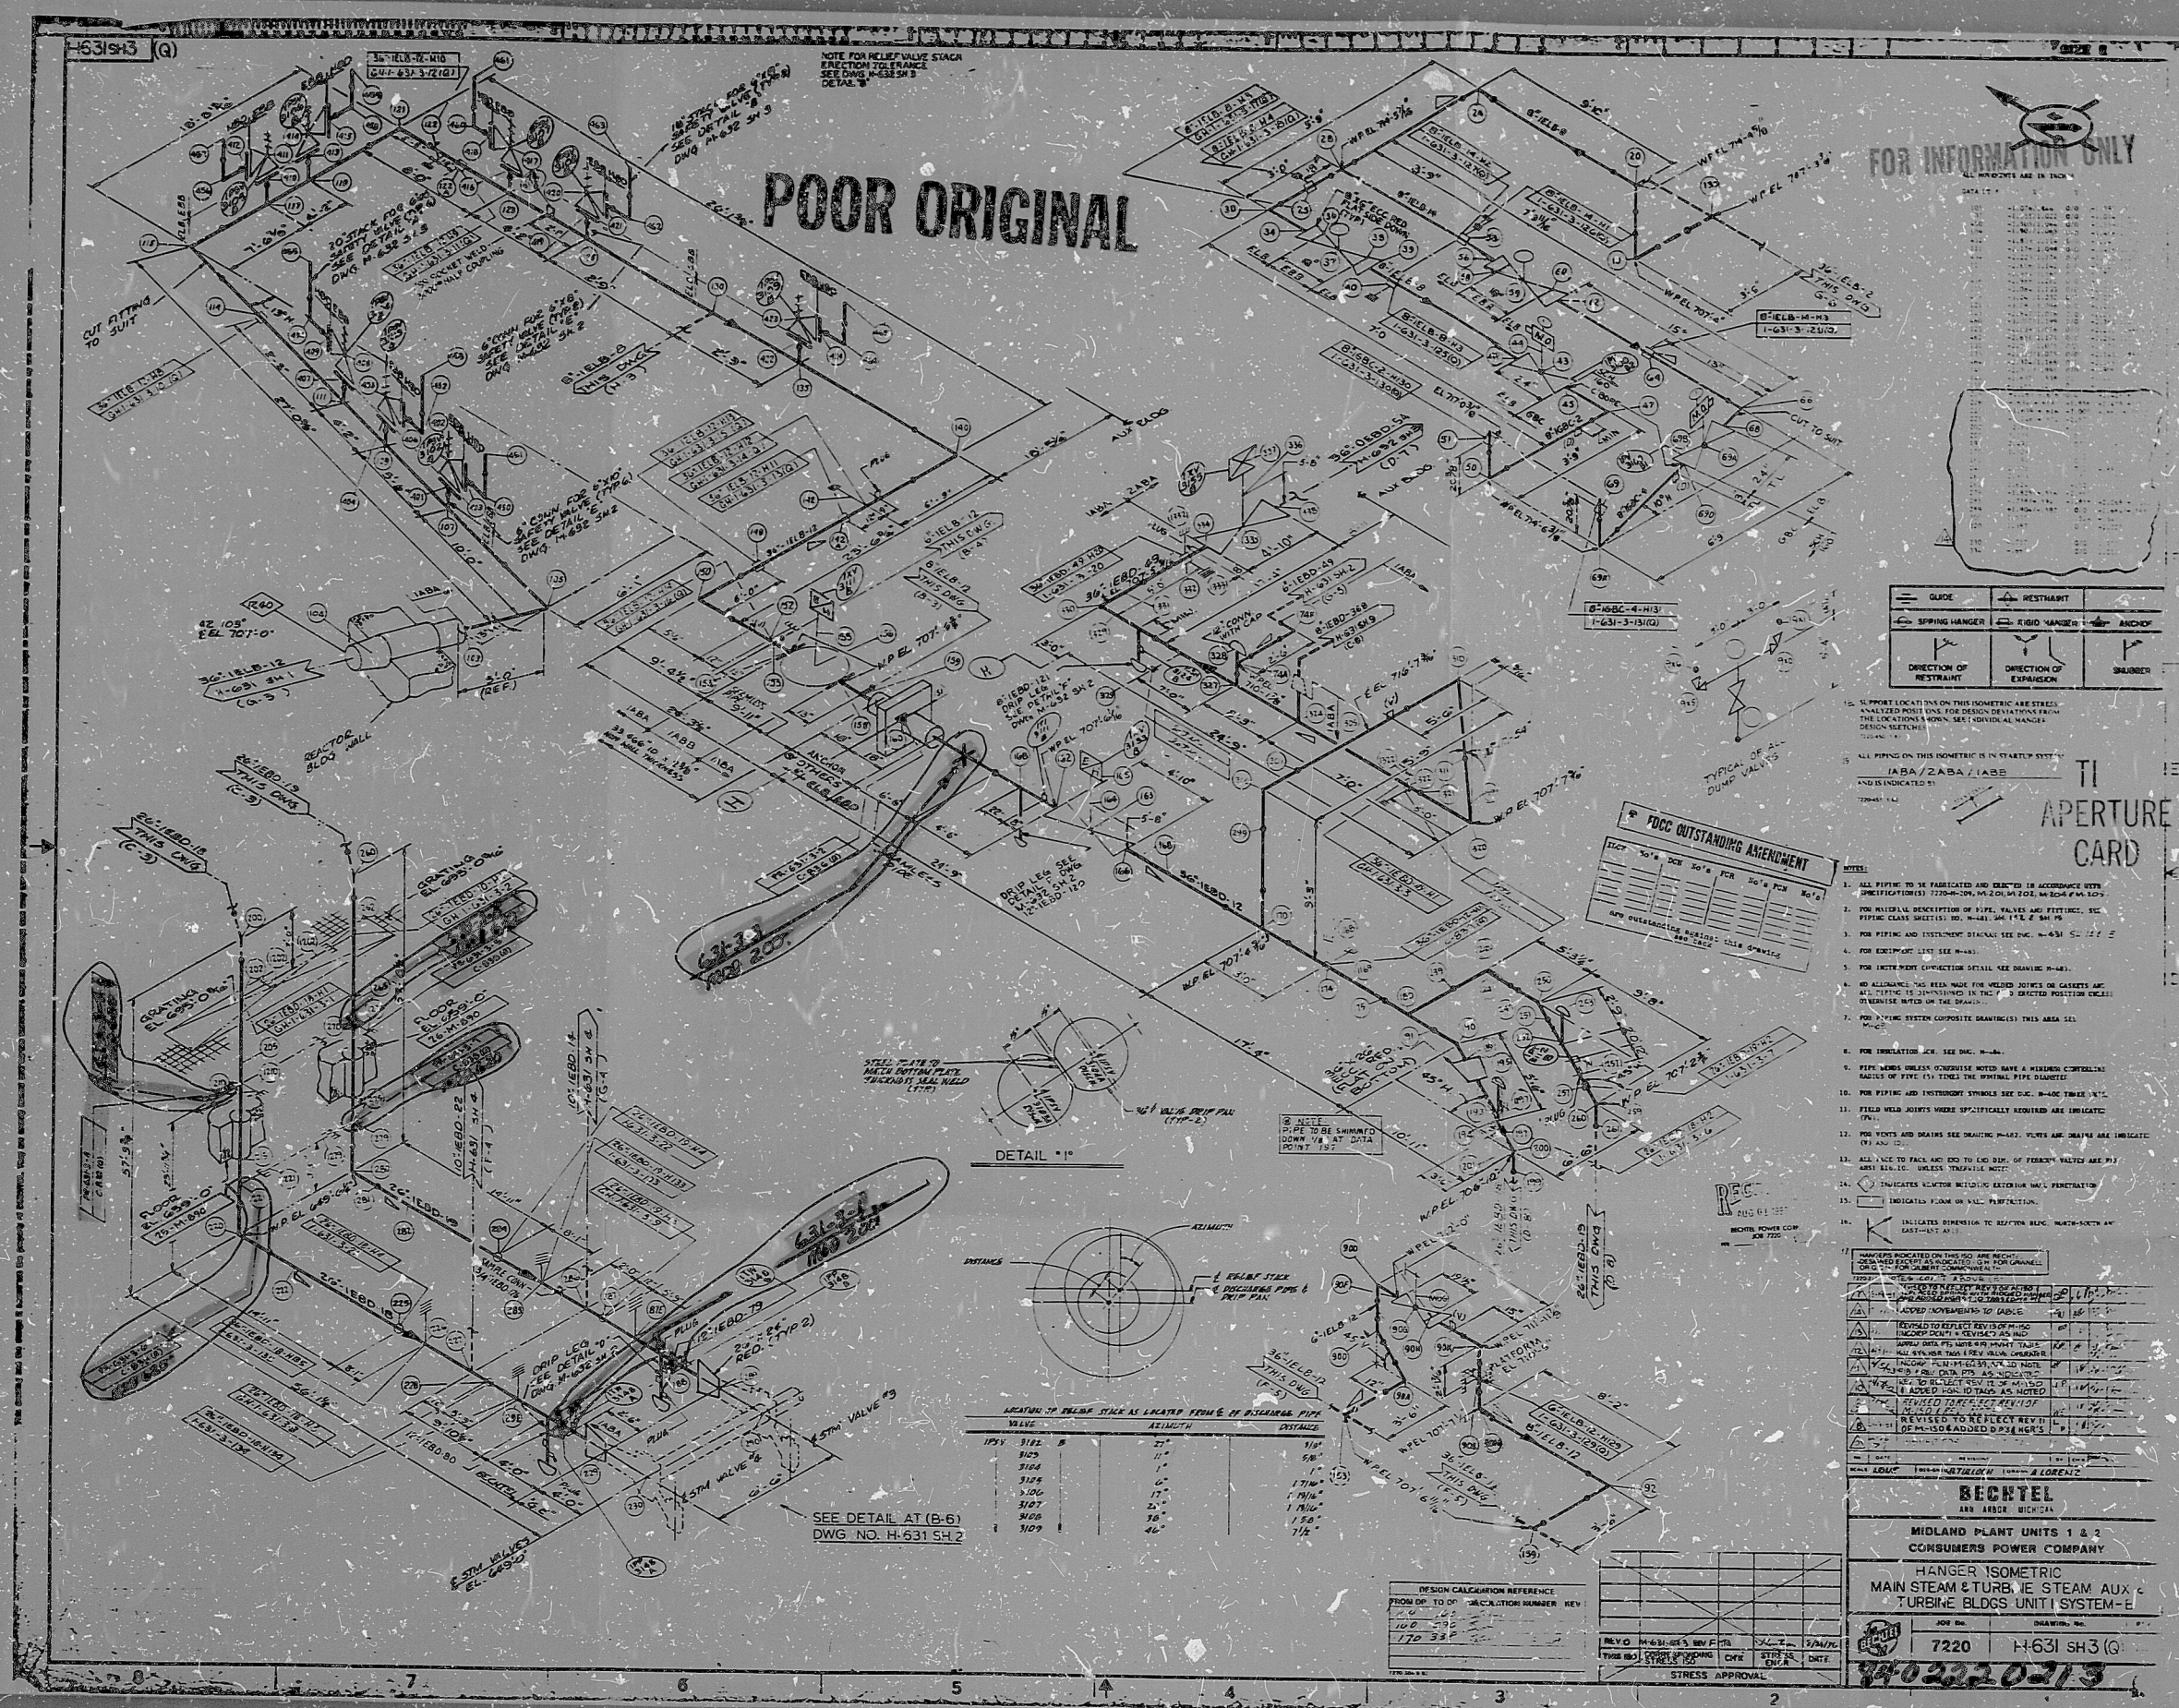

FOR INFORMATION ONLY


LEGEND

GLUE	RESTRAINT
SPRING HANGER	FIXED HANGER
DIRECTION OF RESTRAINT	DIRECTION OF EXPANSION
ANCHOR	SHOULDER

1. ALL PIPING ON THIS ISOMETRIC IS IN STARTUP SYSTEM.

2. ALL PIPING ON THIS ISOMETRIC IS IN STARTUP SYSTEM.

BECHTEL

MIDLAND PLANT UNITS 1 & 2

CONSUMERS POWER COMPANY

HANGER ISOMETRIC

MAIN STEAM & TURBINE STEAM AUXILIARY

TURBINE BLDGS UNIT SYSTEM-E

7220 H-631 SH3 (Q)

4402220-13

PDR RIDS

8402220213

