


**NOTE:**  
 1. INSTRUMENTATION TAG NUMBERS ARE SHOWN ABOVE FOR CONTAINMENT FAN COOLER UNIT FC-1A. TAG NUMBERS FOR UNITS FC-1B, FC-1C & FC-1D INCLUDE THE SUFFIXES B, C & D RESPECTIVELY.

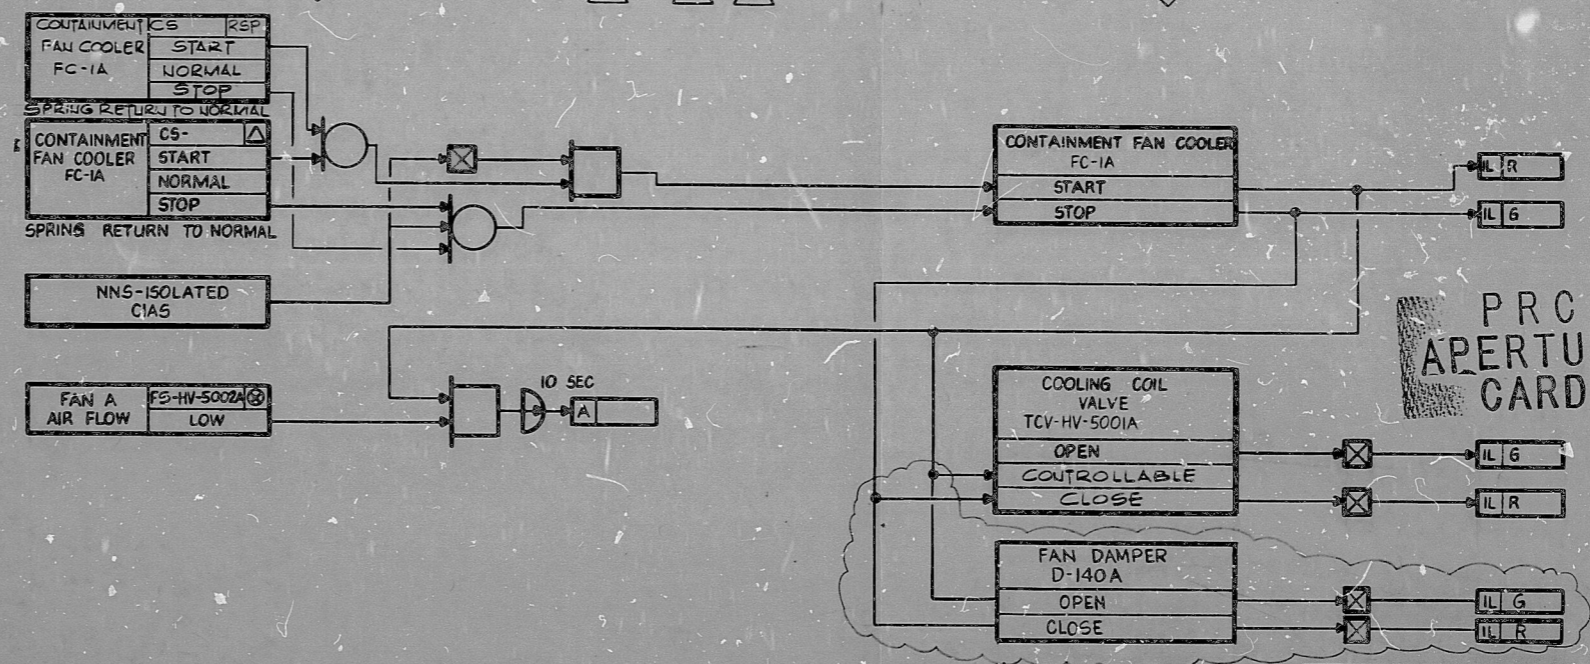

WPPSS QUALITY CLASS II

5																				
4																				
3																				
2																				
1	B-1-80	PP																		
REV	DATE	BY	APPROVED	<b>EBASCO SERVICES INCORPORATED</b> DIV. INSTRUMENTATION DR. BM CH. J. PAGLIANTI DATE JAN. 26, 1979				APPROVED <i>D. P. ...</i> <i>...</i>				WASHINGTON PUBLIC POWER SUPPLY SYSTEM NUCLEAR PROJECT NO 3 & 5 INSTRUMENT SCHEMATIC - LOGIC DIAGRAM CONTAINMENT FAN COOLERS				WPPSS-3240 D6080 SHEET 330				

RIDS

8303140153

