

17

11

8.5

8.5

11

17

17



11

8.5

8.5

11

17

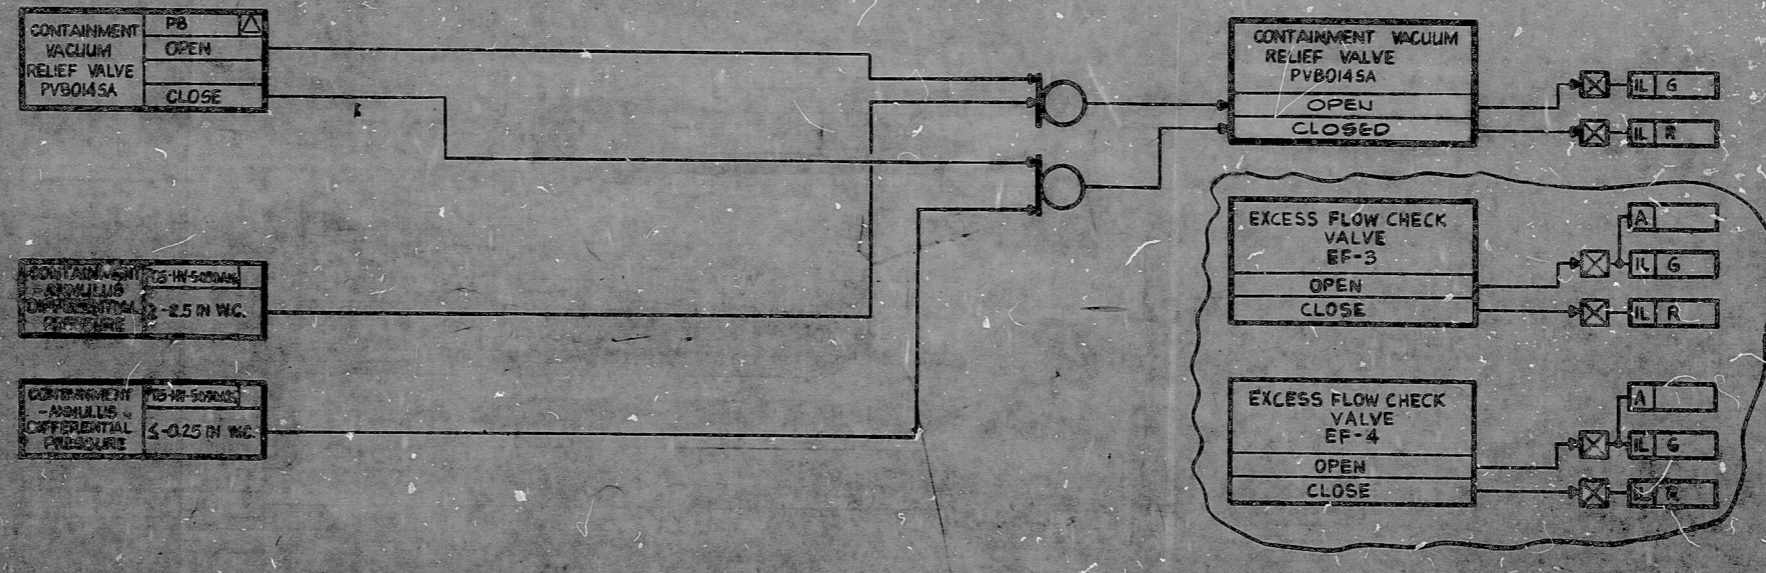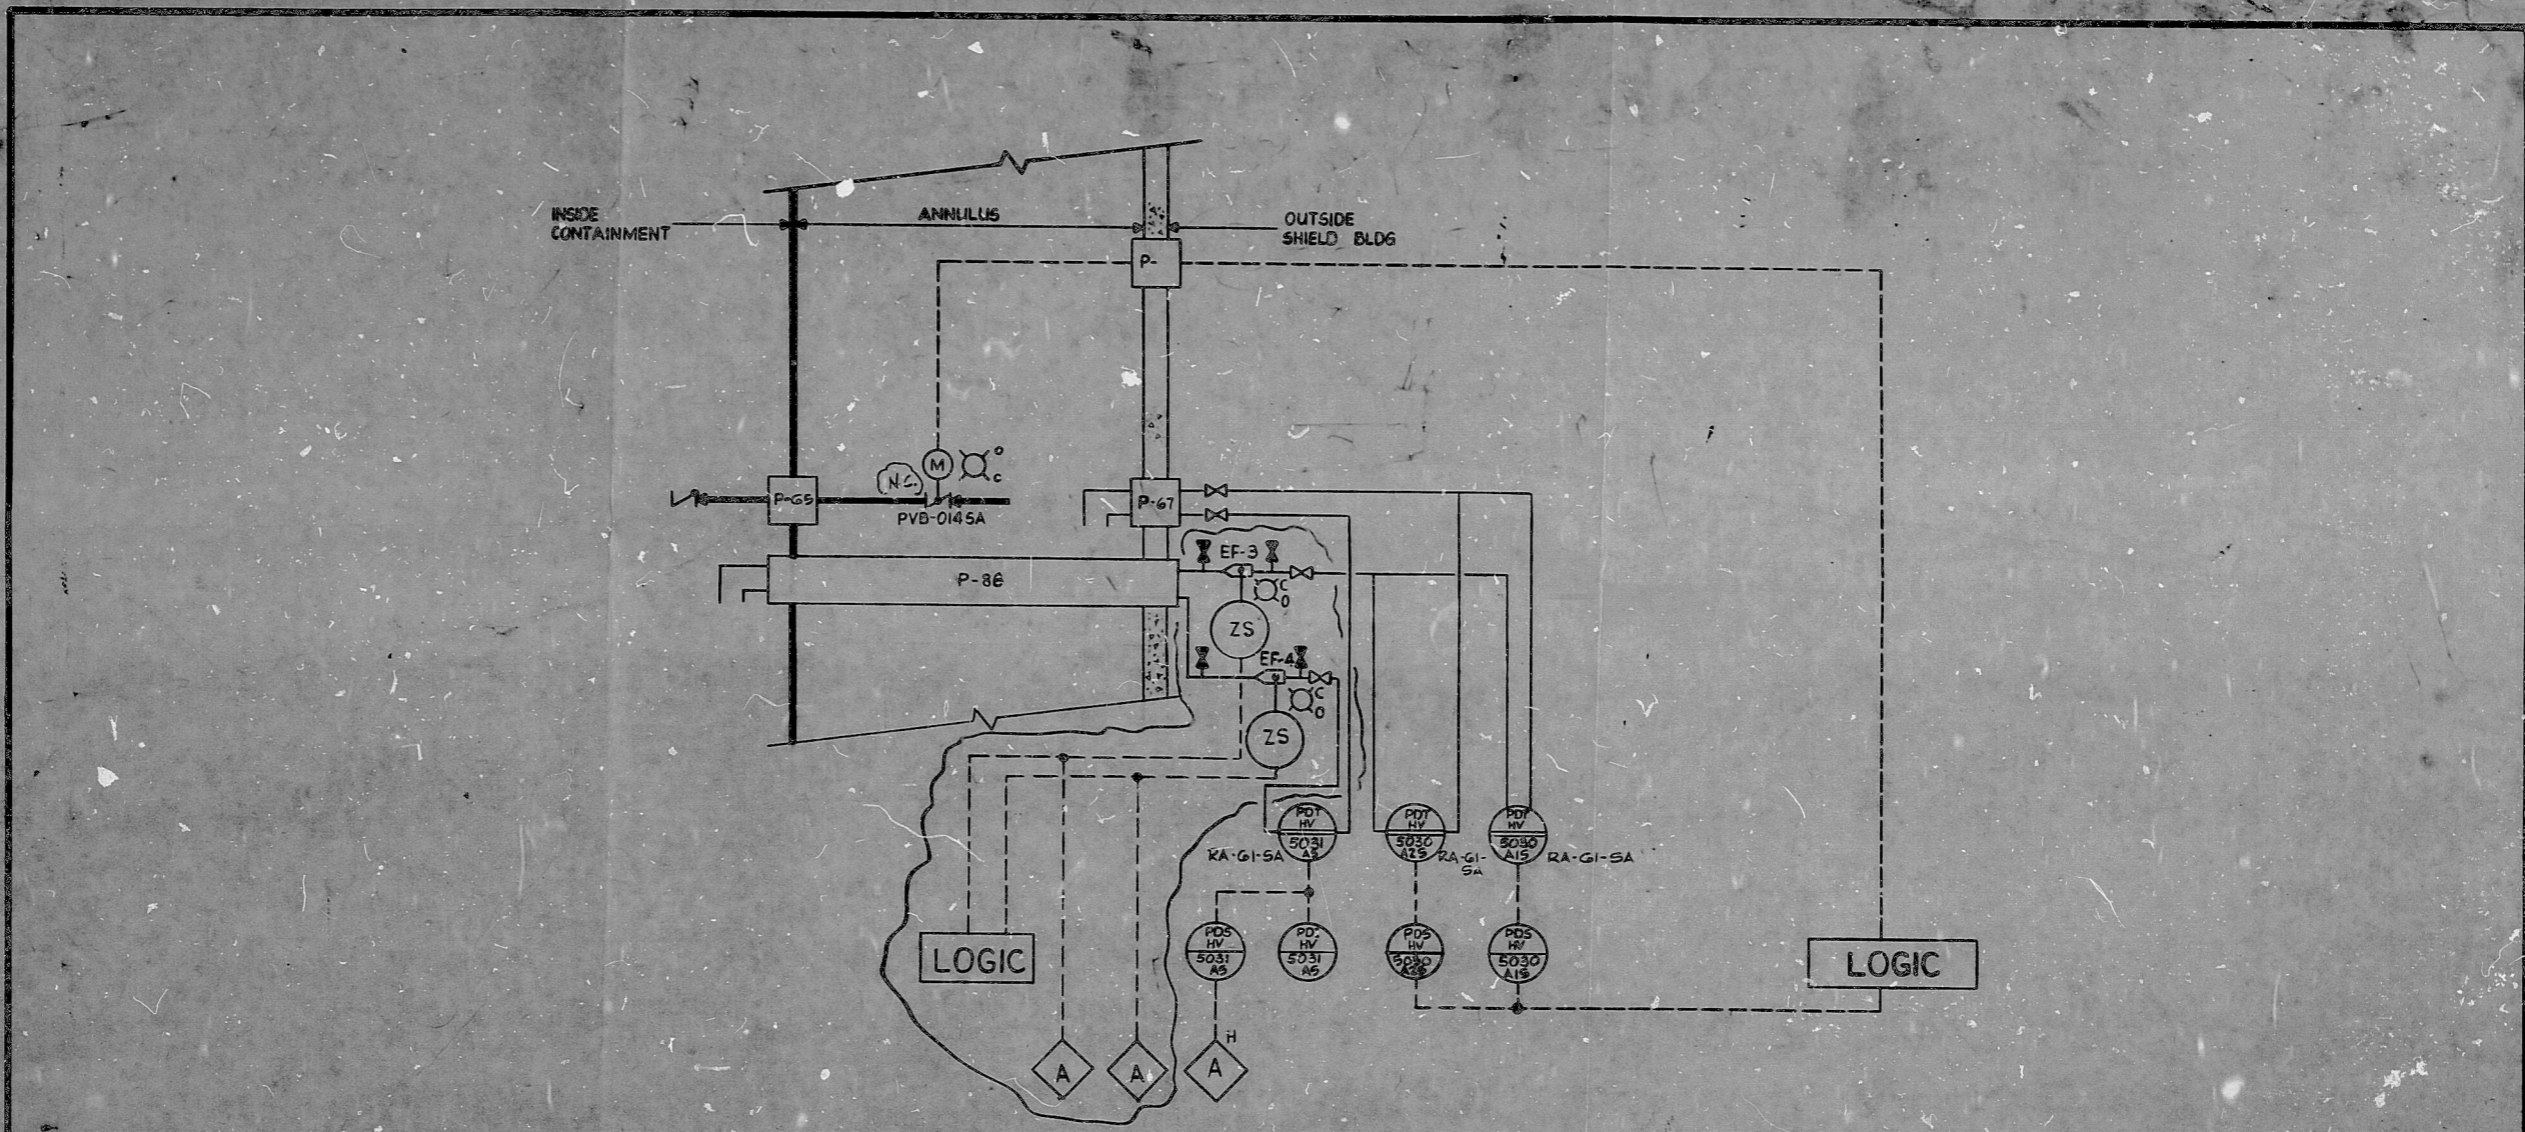

PRC APERTURE CARD

NUCLEAR SAFETY RELATED WPPSS QUALITY CLASS

ES&CO SERVICES INCORPORATED DIV. INSTRUMENTATION CH. J. PAGLIANTI		WASHINGTON PUBLIC POWER SUPPLY SYSTEM NUCLEAR PROJECT NO 3 & 5 INSTRUMENT SCHEMATIC - LOGIC DIAGRAM CONTAINMENT VACUUM RELIEF		WPPSS-3240 D-6080 SHEET 134
REV.	DATE	BY	APPROVED	DATE
1	6-11-62	J. Paglianti	[Signature]	JAN 26, 1970

RIDS

8303140164

