


FROM AC UNIT AC-1A OR 1B
SEE SH. 336B

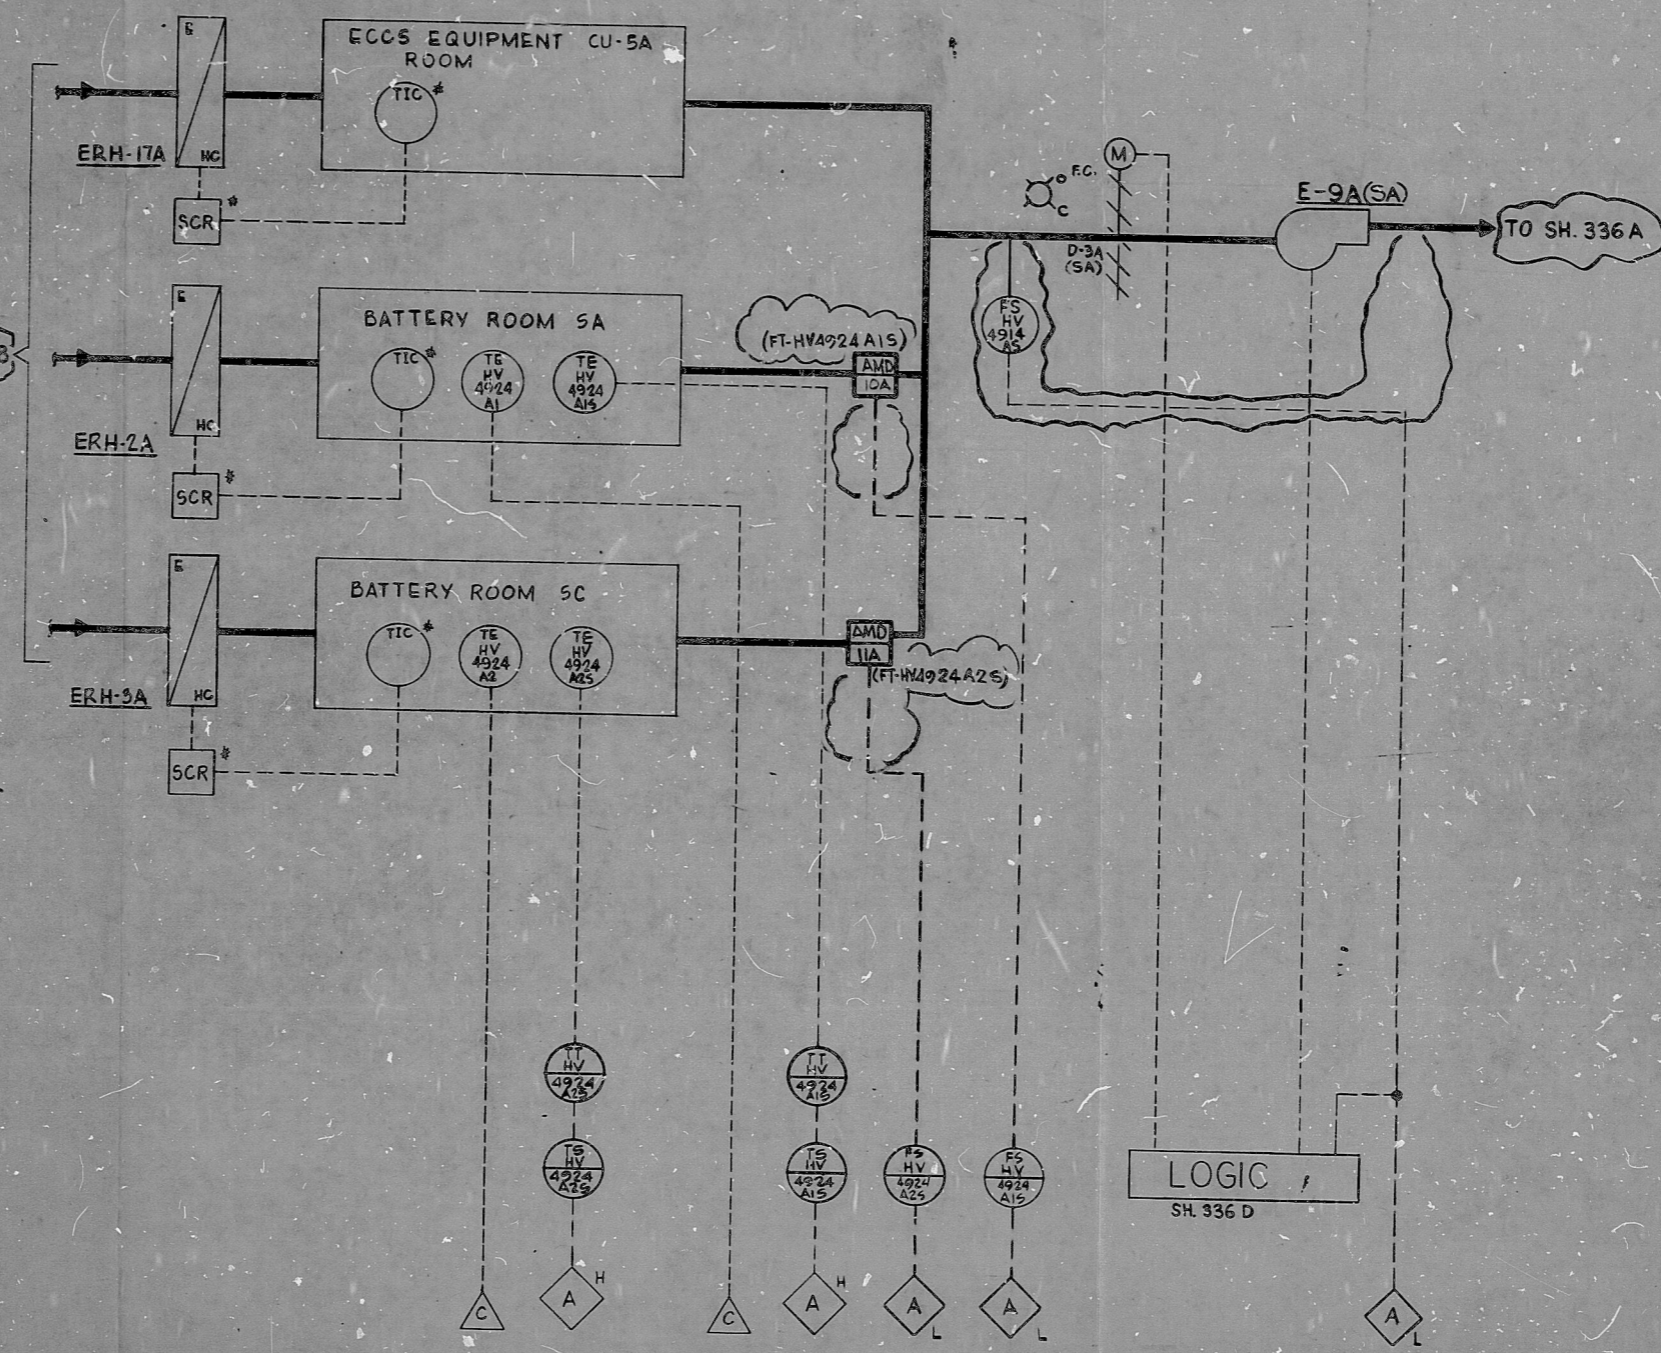

NOTE:
1. * B TYPE CONTROLS

REV.	DATE	BY	APPROVED
3			
4			
2	6-11-82	S.Z.	[Signature]
1	8-1-80	PP	[Signature]

EBASCO SERVICES INCORPORATED
 DIV. INSTRUMENTATION OR AJ
 CH. J. PAGLIANTI
 DATE JAN. 26, 1979
 APPROVED
 [Signature]

WASHINGTON PUBLIC POWER
 SUPPLY SYSTEM
 NUCLEAR PROJECT NO 335
 INSTRUMENT SCHEMATIC - LOGIC DIAGRAM
 ELECTRICAL AND BATTERY ROOMS A.C.
 TRAIN 'A'

WPPS-3240
 D6080
 SHEET 336C

PRC
 APERTURE
 CARD

RIDS

8303150021

