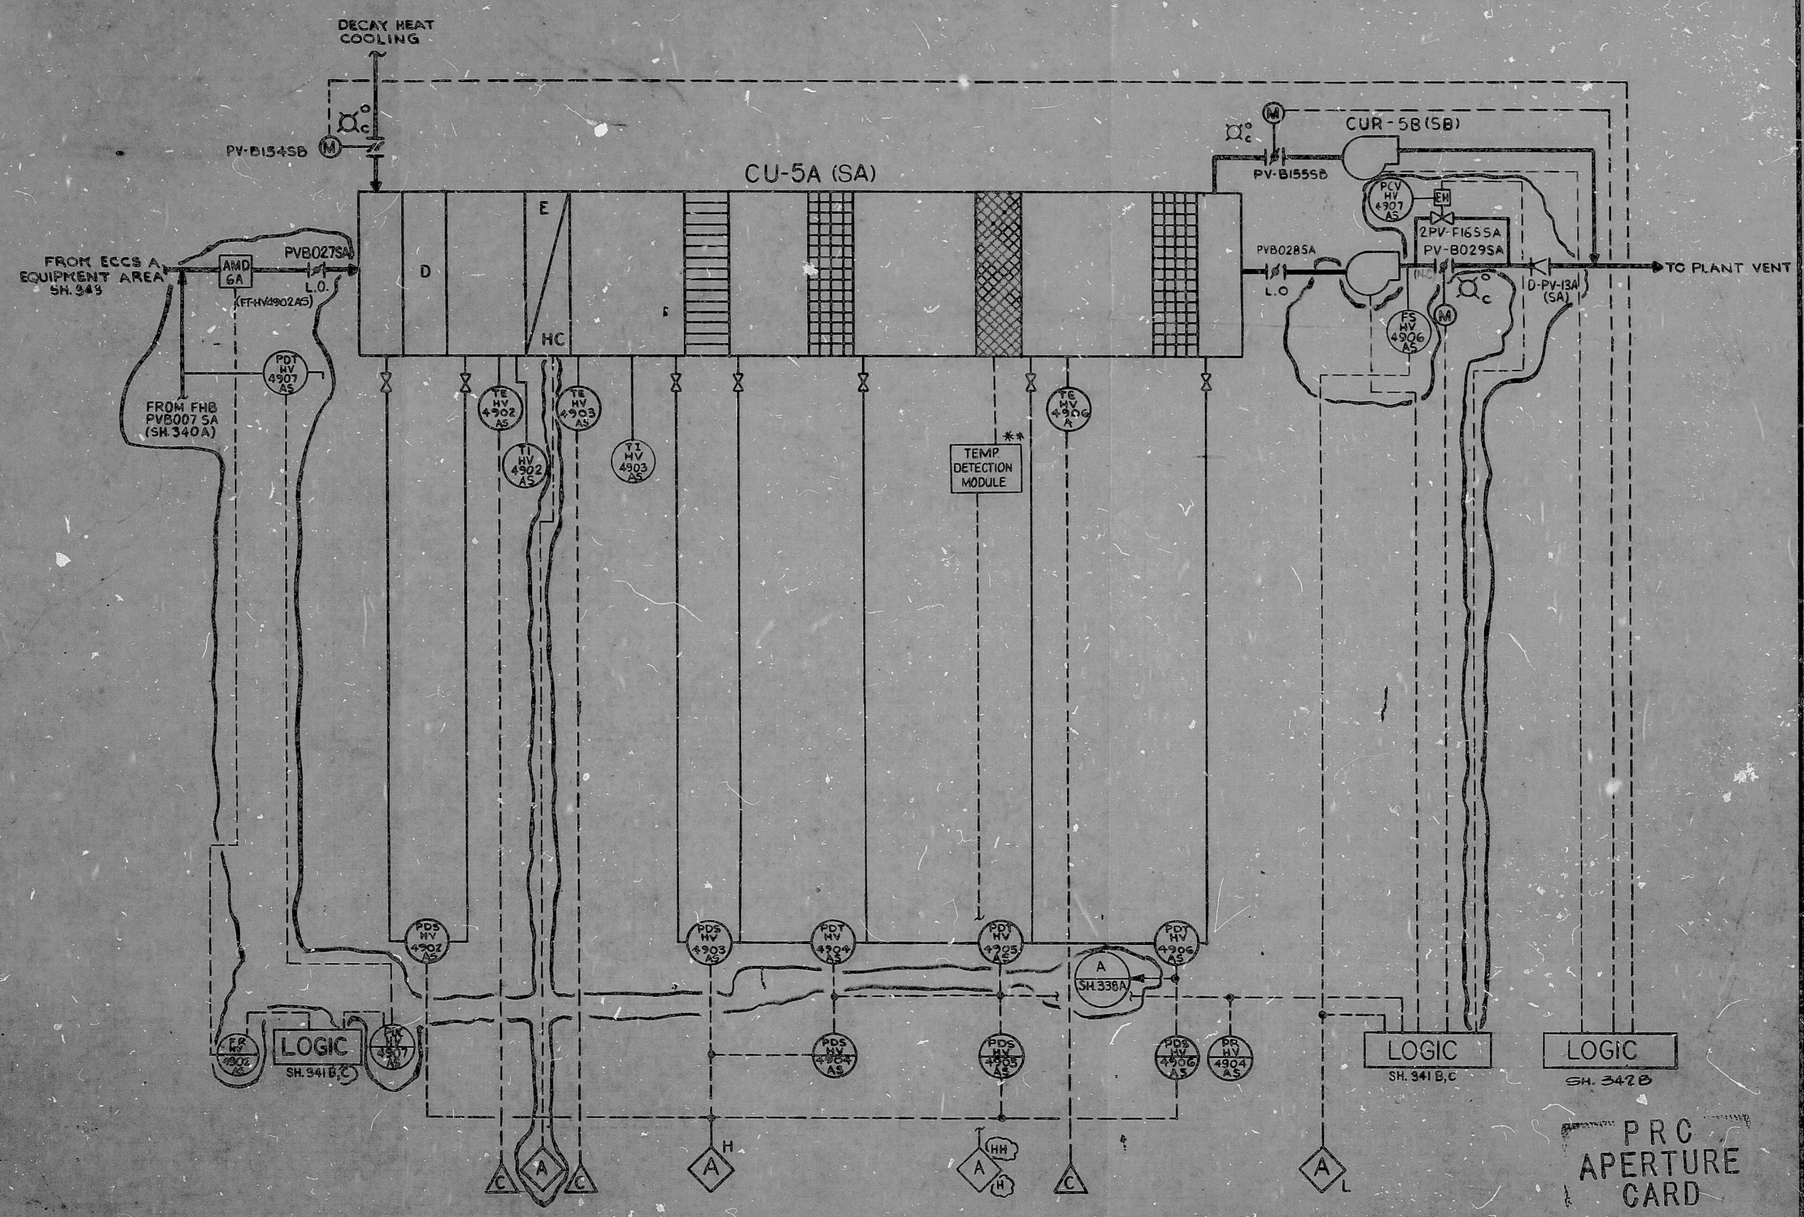

NOTE:

** DENOTES INSTRUMENTS FURNISHED BY VENDOR

PRC APERTURE CARD

NUCLEAR SAFETY RELATED | WPPSS QUALITY CLASS I

REV.	DATE	BY	APPROVED
5			
4			
3			
2	6-11-62	R.D.	
1	6-1-60	R.D.	

EBASCO SERVICES INCORPORATED

DIV. INSTRUMENTATION DR. P.M.P.

CH. J. PAGLIANTI

DATE JAN. 26, 1979

APPROVED

WASHINGTON PUBLIC POWER SUPPLY SYSTEM
NUCLEAR PROJECT NO 3 & 5
INSTRUMENT SCHEMATIC - LOGIC DIAGRAM
REACTOR AUXILIARY BUILDING
ECCS FILTERED EXHAUST UNIT "A" TRAIN "A"

WPPS-3240
D-6080
SHEET 341A

RIDS

8303150058

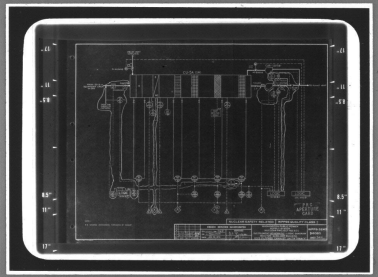

MMM 5824 — FILMSORT® Brand Aperture & Camera Cards and DUPLICARD® Brand Copy Cards — Product of 3M Company, St. Paul, Minn.