


11
11
5.8
11
11
11

11
11
5.8
11
11
8.5
11
17

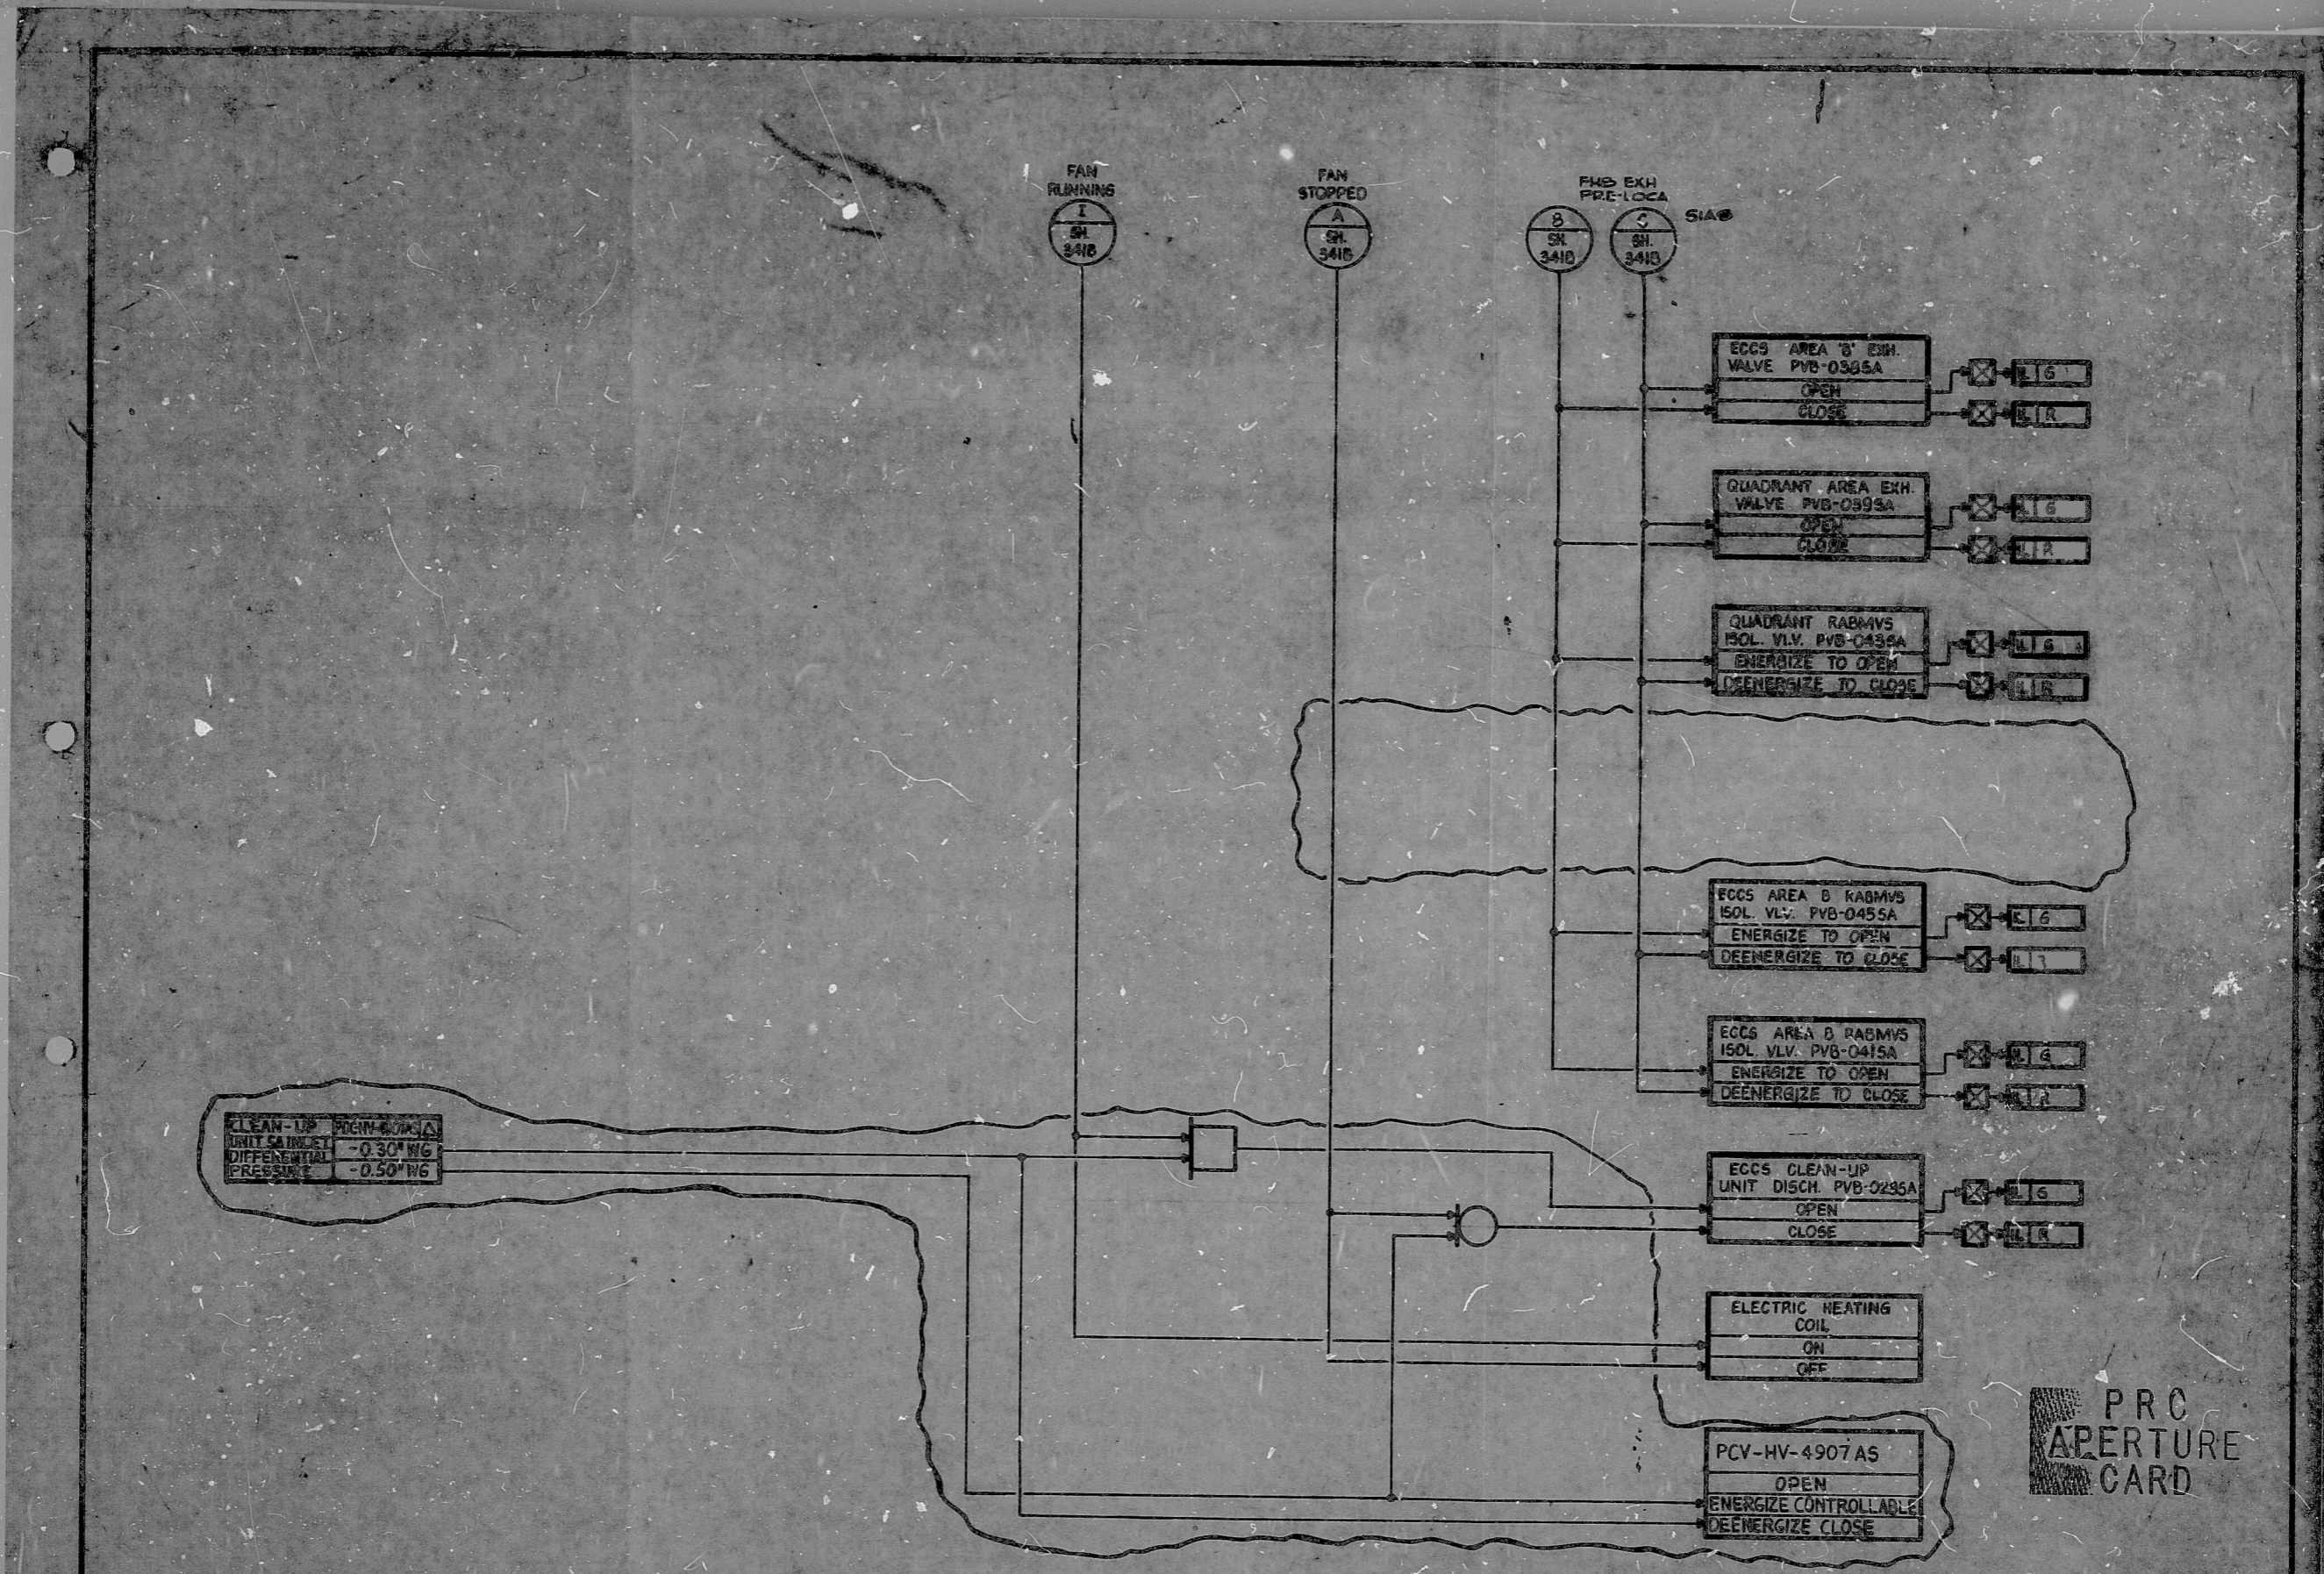

PRC
APERTURE
CARD

NUCLEAR SAFETY RELATED / WPPSS QUALITY CLASS I

3							
4							
5							
6	6-11-82	RD					
7	8-1-80	RD					
REV.	DATE	BY	APPROVED	DATE	JAN. 26, 1979		
EBASCO SERVICES INCORPORATED DIV. INSTRUMENTATION DR. SM CH. J. PAGLIANTI APPROVED <i>[Signature]</i>				WASHINGTON PUBLIC POWER SUPPLY SYSTEM NUCLEAR PROJECT NO 3 & 5 INSTRUMENT SCHEMATIC - LOGIC DIAGRAM REACTOR AUXILIARY BUILDING ECCS FILTERED EXHAUST-TRAIN 'A' WPPSS-2240 D6080 SKT POC			

RWD

8303150061

