
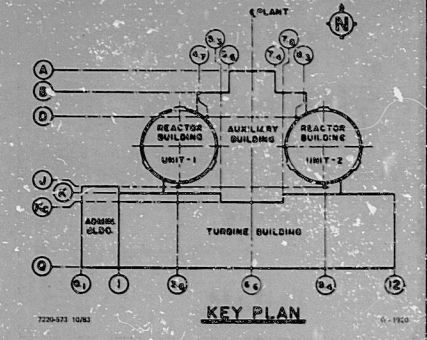


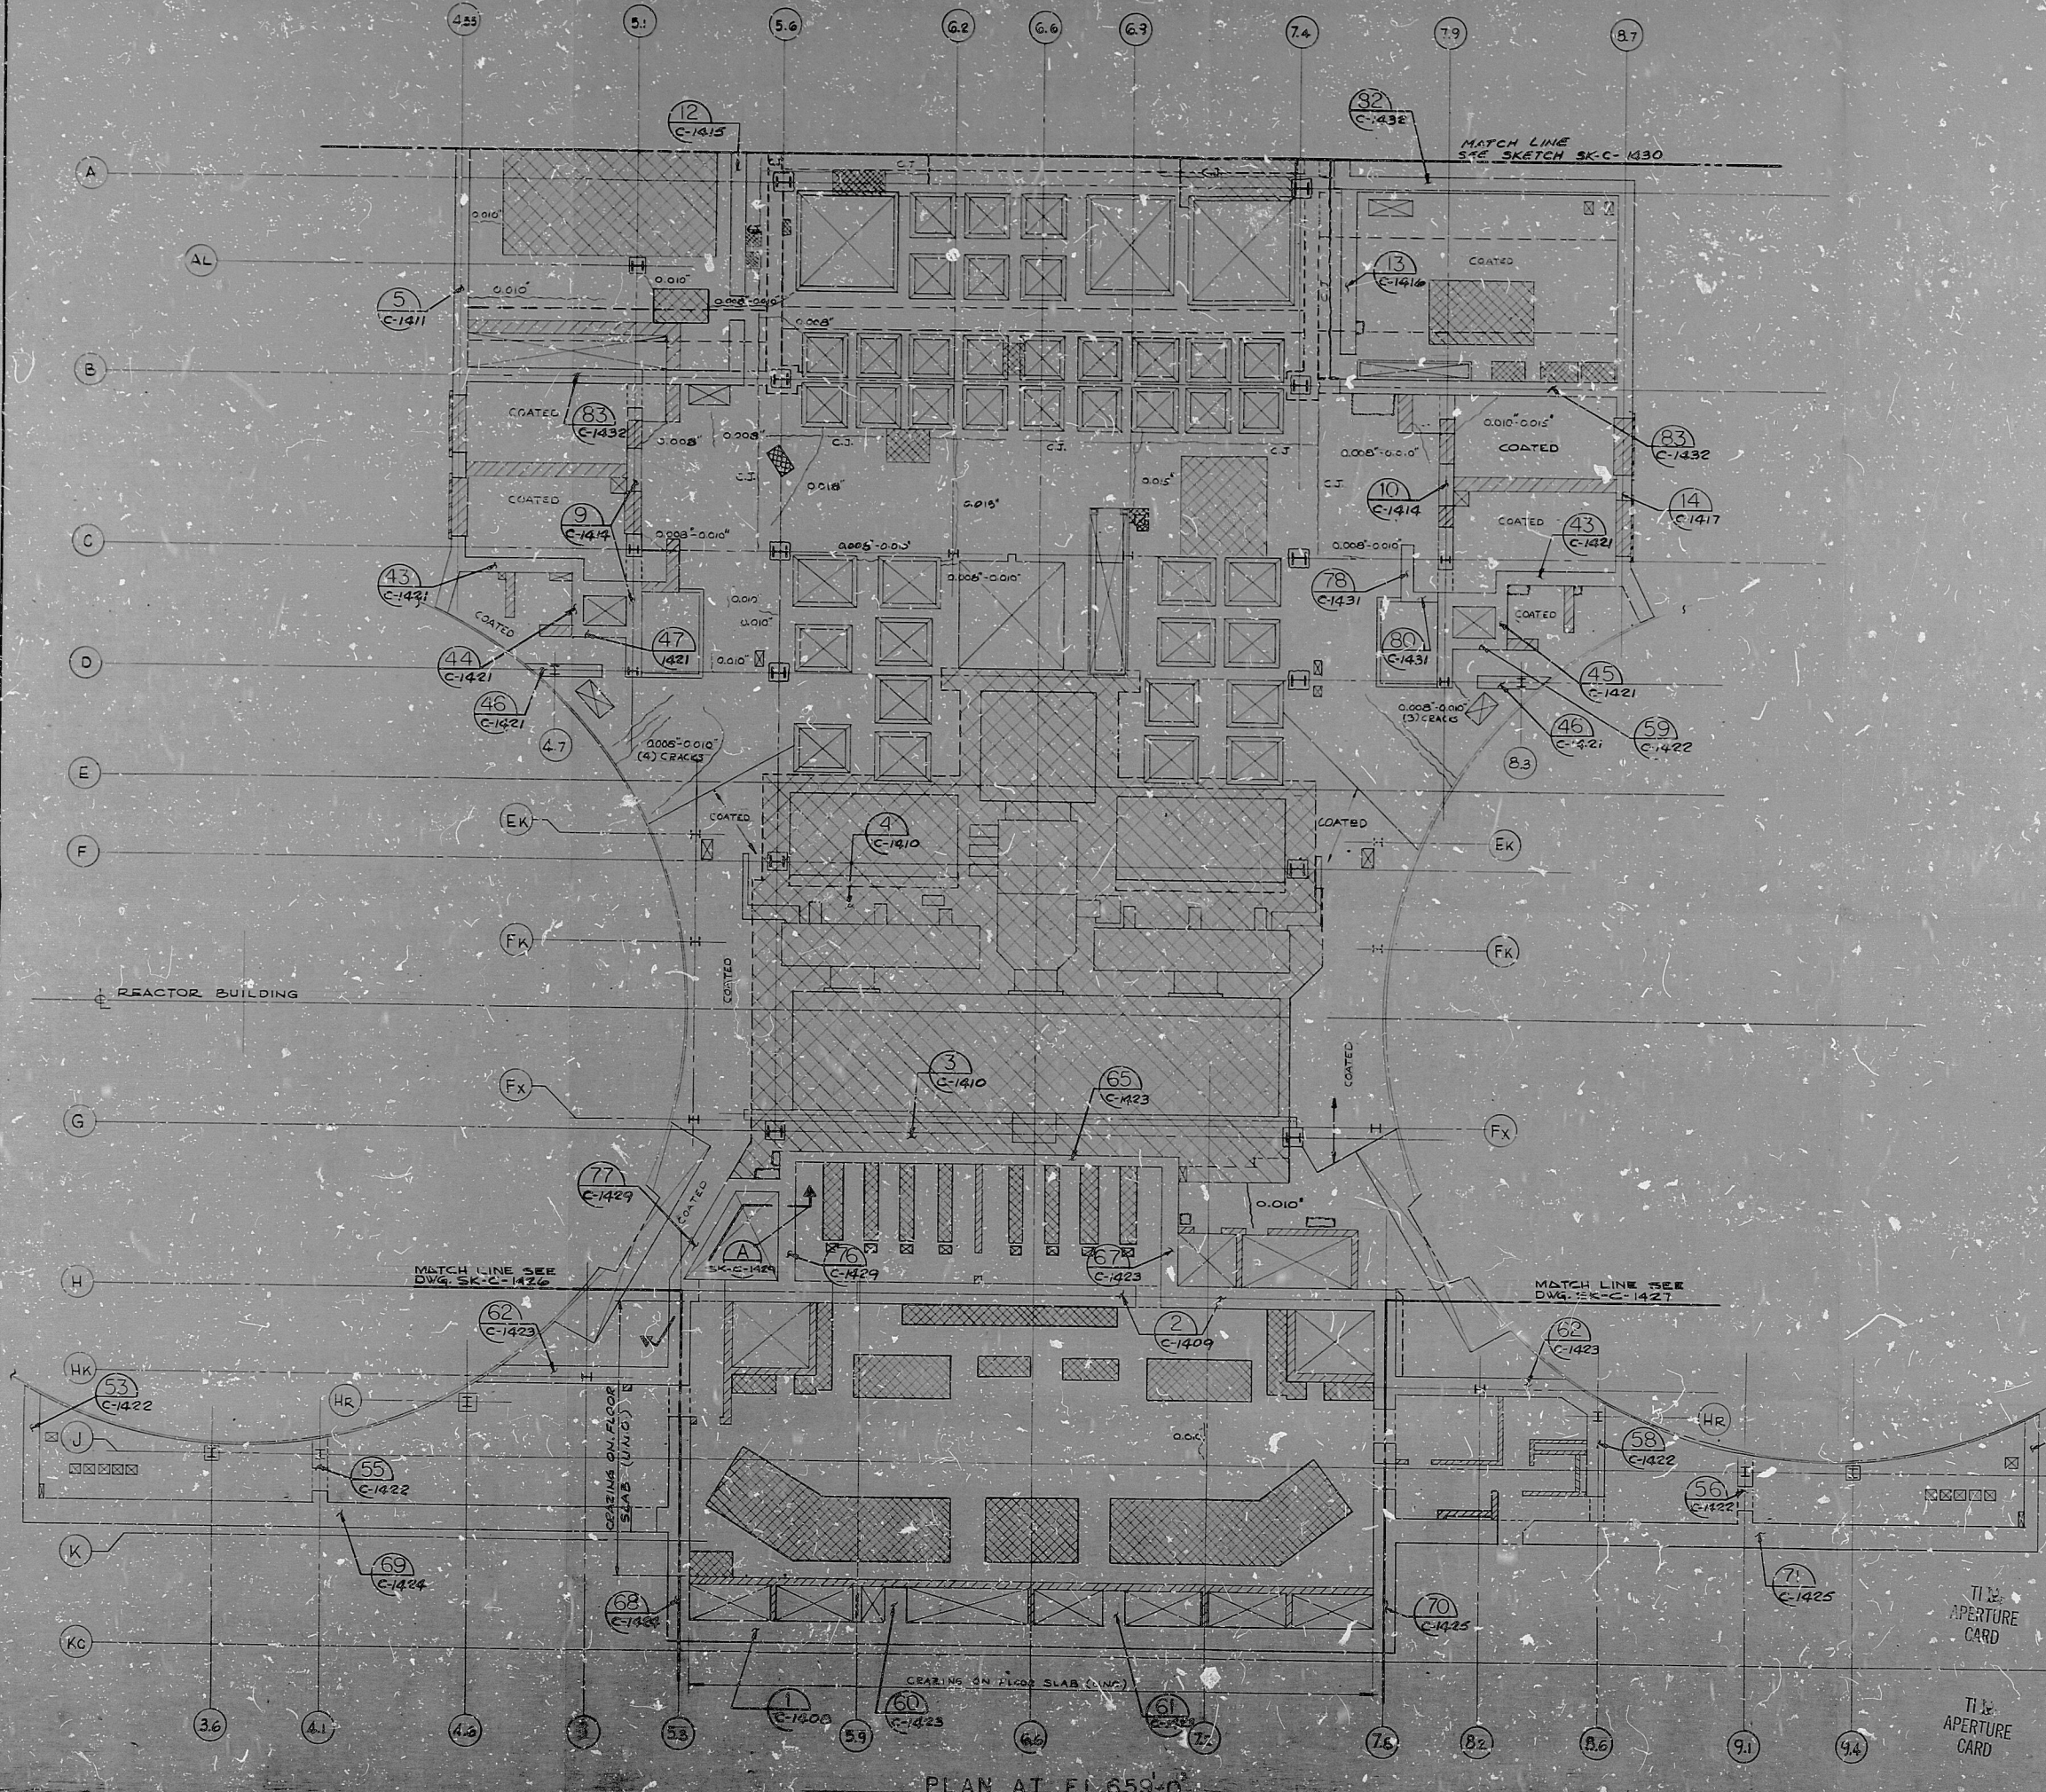

NOTES

- 1. FOR NOTES AND LEGEND SEE DWG SK-C-1400
- 2. FOR REFERENCE DRAWINGS SEE DWG SK-C-1401

FOR INFORMATION ONLY

ISSUED FOR INFORMATION ONLY	
DATE	REVISION
BY	DATE
SCALE 1/8" = 1'-0" DESIGNED BY 1406/12/77 DRAWN BY T. L. ELLER	
BECHTEL ANN ARBOR, MICHIGAN	
MIDLAND PLANT UNITS 1 & 2 CONSUMERS POWER COMPANY	
AUXILIARY BLDG CRACK SURVEY PLAN AT EL 659'-0"	
JOB NO.	DRAWING NO.
7220	SK-C-1406
REV.	
A	

8402230281

PDR RIDS

