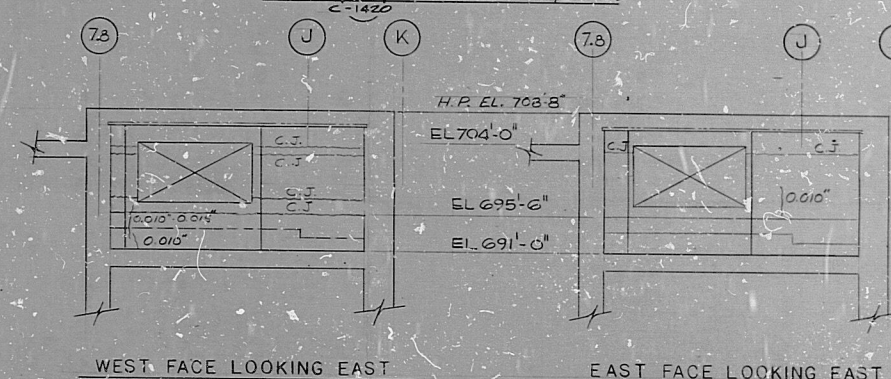
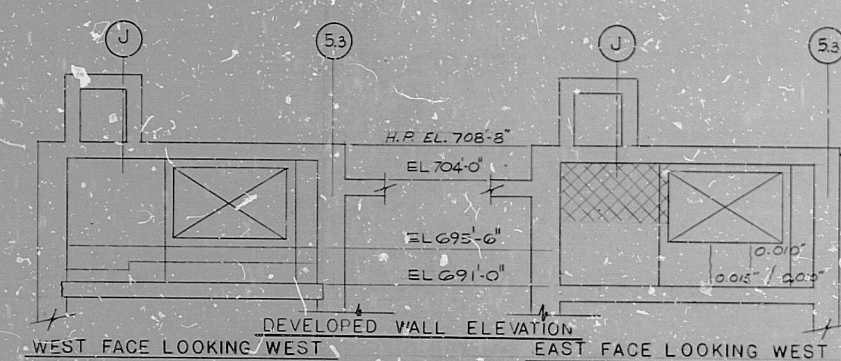
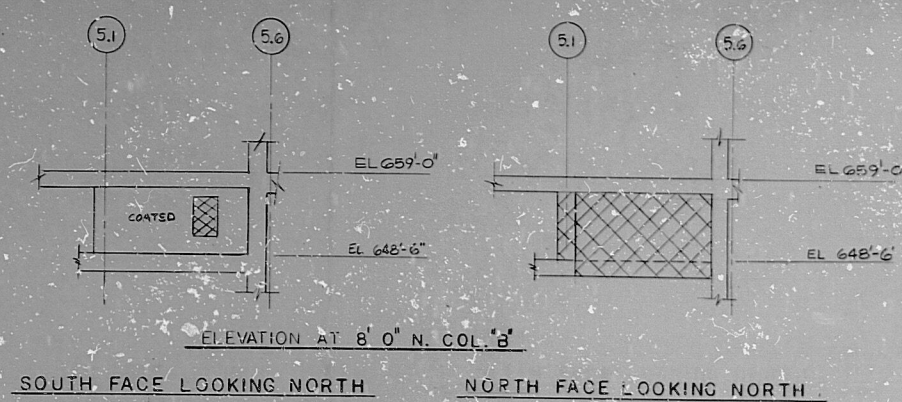


NOTES

1. FOR NOTES AND LEGEND SEE DWG  
5K-C-1400
2. FOR REFERENCE DRAWINGS SEE  
DWG 5K-C-1401

FOR  
INFORMATION ONLY

[illegible]

TIME  
APERTURE  
CARD

This drawing and the design it covers are the property of BECHTEL. They are merely loaned and on the borrower's express agreement that they will not be reproduced, copied, loaned, exhibited or used except in the limited way and extent use permitted by any written consent given by the lender to the borrower.



8402240191

PDR RIDS

