



SK-C-1424

SIZE E

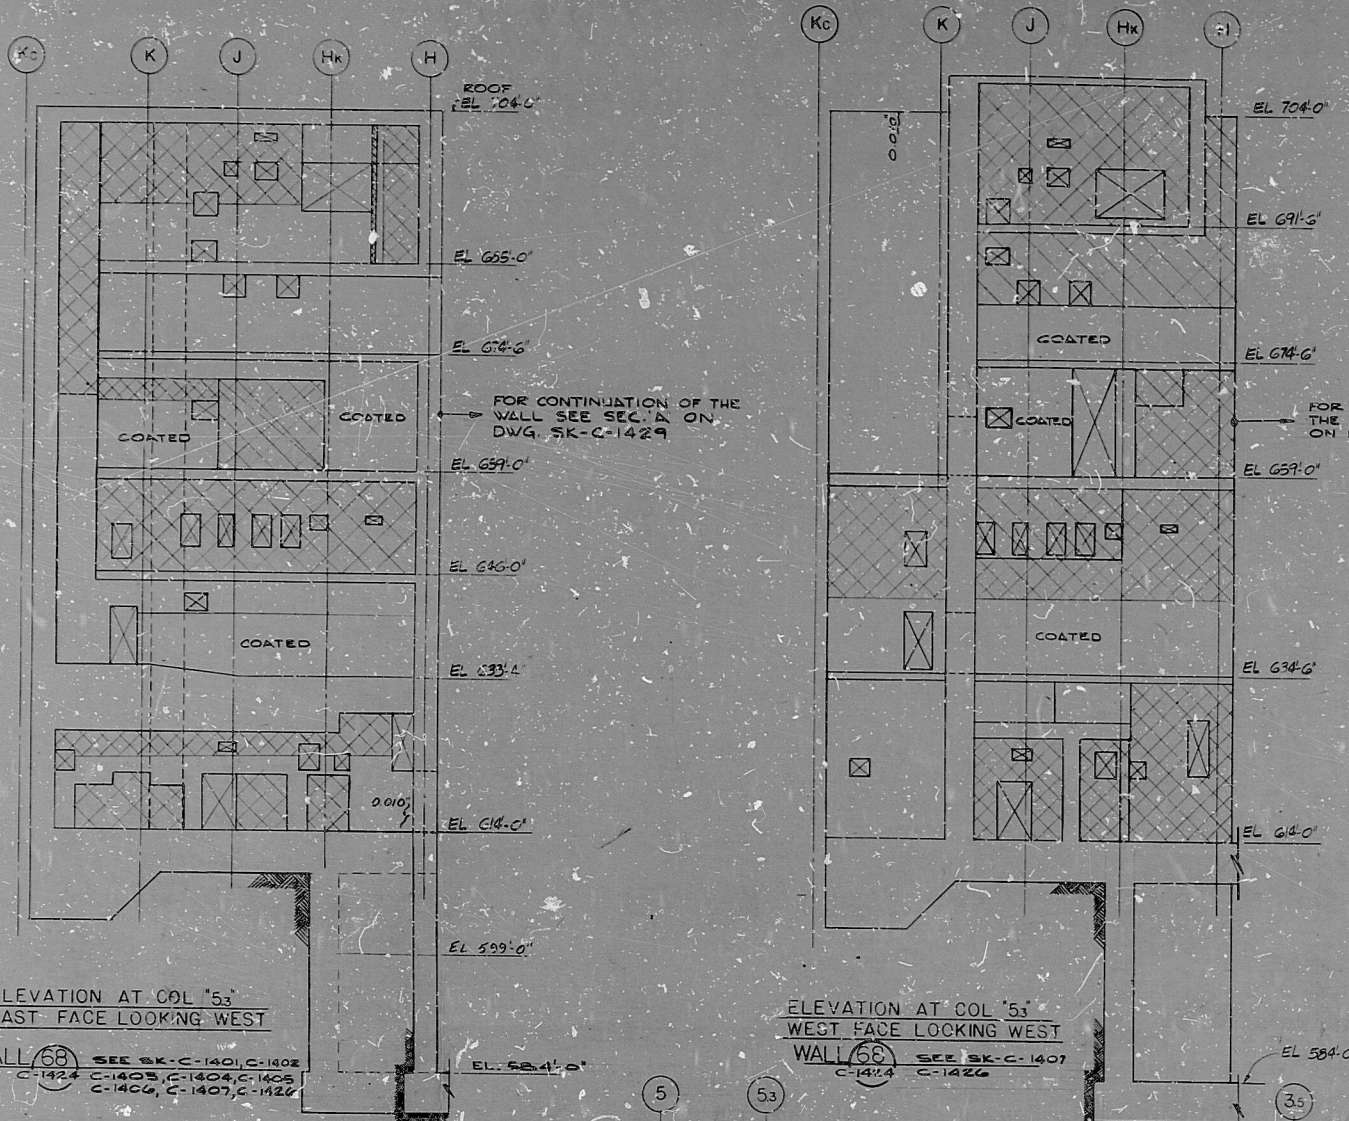


ELEVATION AT COL '53'
EAST FACE LOOKING WEST

ELEVATION AT COL '53'
WEST FACE LOOKING WEST

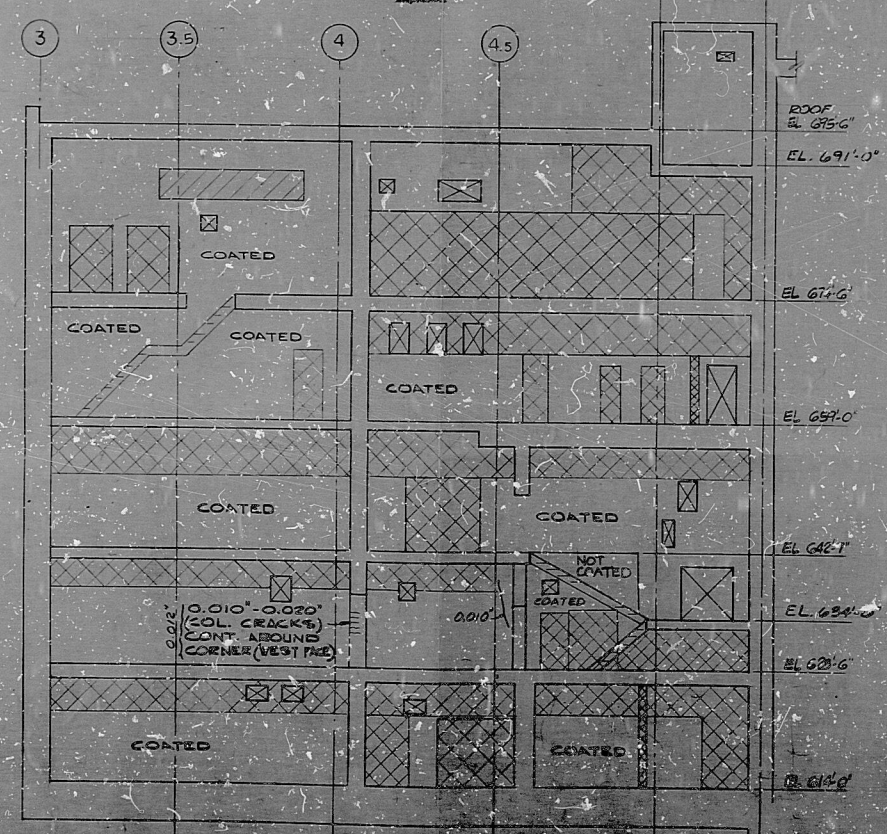

ELEVATION AT COL '53'
NORTH FACE LOOKING NORTH

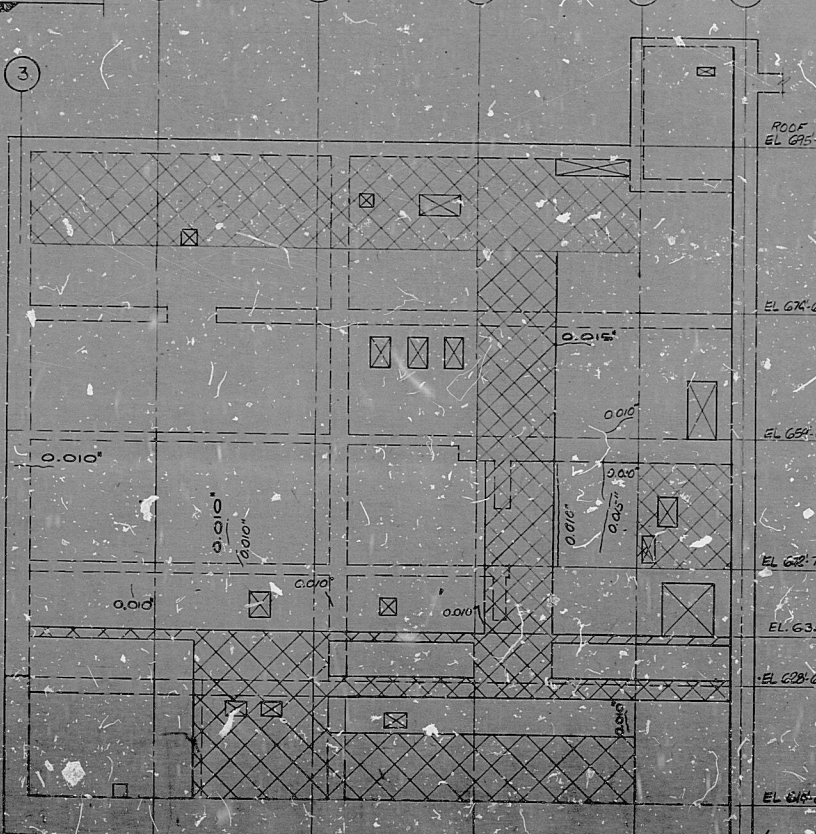

ELEVATION AT COL '53'
SOUTH FACE LOOKING SOUTH



KEY PLAN

NOTES

1. FOR NOTES AND LEGEND SEE DWG. SK-C-1400
2. FOR REFERENCE DRAWINGS SEE DWG. SK-C-1401

FOR
INFORMATION ONLY

ISSUED FOR INFORMATION		EG-10	
MIDLAND PLANT UNITS 1 & 2		CONSUMERS POWER COMPANY	
AUXILIARY BUILDING		CRACK SURVEY	
WALL ELEV @ 53 & KEY OF 7.8)			
220	SK-C-1424	REV.	

8402240195

PDR RIDS

