

SEE SH. 350A


TO ESCW
RETURN HDR.
FROM UC-7B-1
SH.357D

FROM ESCW
SUPPLY HDR.
EC-806SB
TO UC-7B-1
SH.357D

TO IK-HV4957BIS
SH.357D

LOGIC

LOGIC

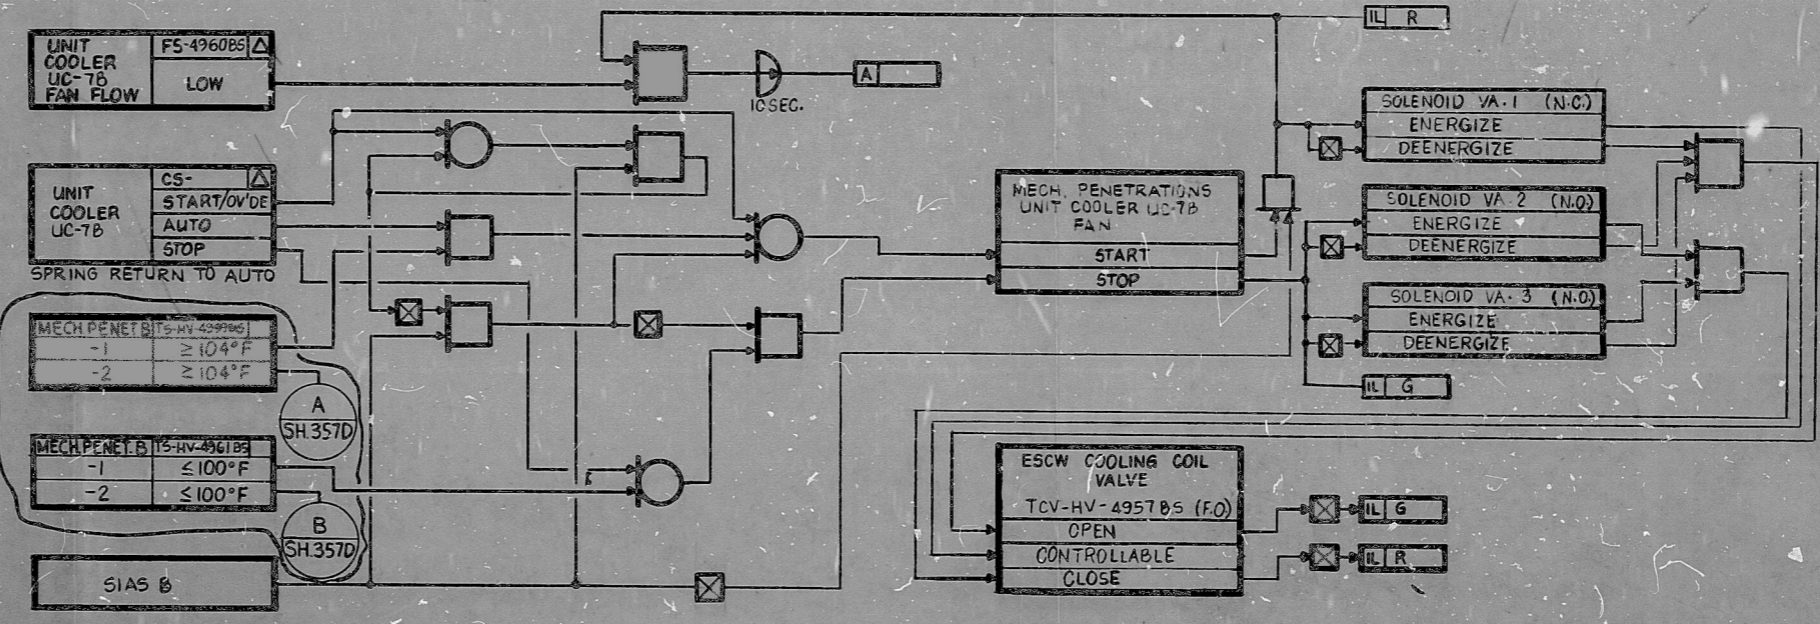

PRC
APERTURE
CARD

NUCLEAR SAFETY RELATED WPPSS QUALITY CLASS I

5									
4									
3									
2	6-11-82	PP			EBASCO SERVICES INCORPORATED	WASHINGTON PUBLIC POWER SUPPLY SYSTEM NUCLEAR PROJECT NO 3&5			WPPS-3240
1	8-1-80	PP			DIV. INSTRUMENTATION DR. BM CH. J. PAGLIANTI	INSTRUMENT SCHEMATIC - LOGIC DIAGRAM ECCS AREA-MECH. PENETRATIONS ROOM B UNIT COOLER UC-7B			D6080
REV.	DATE	BY	APPROVED	DATE	JAN. 26, 1979				SHEET 357 B

MOORE 1238 1174 409236

RIDS

8303150149

