


MA WINDUP IN PRESS. CONTROLLER  
CORRECTED IN THIS ISSUE

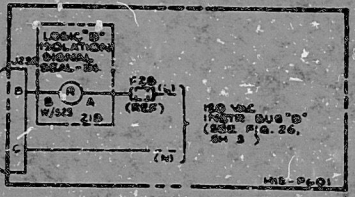

J176

J175

MIS-P-002


11

11

8.5

8.5

11

17



PDR RIDS

84Φ224Φ212

