


ALL WIRING IS (C-2)
UNLESS OTHERWISE
INDICATED ON THIS
SHEET

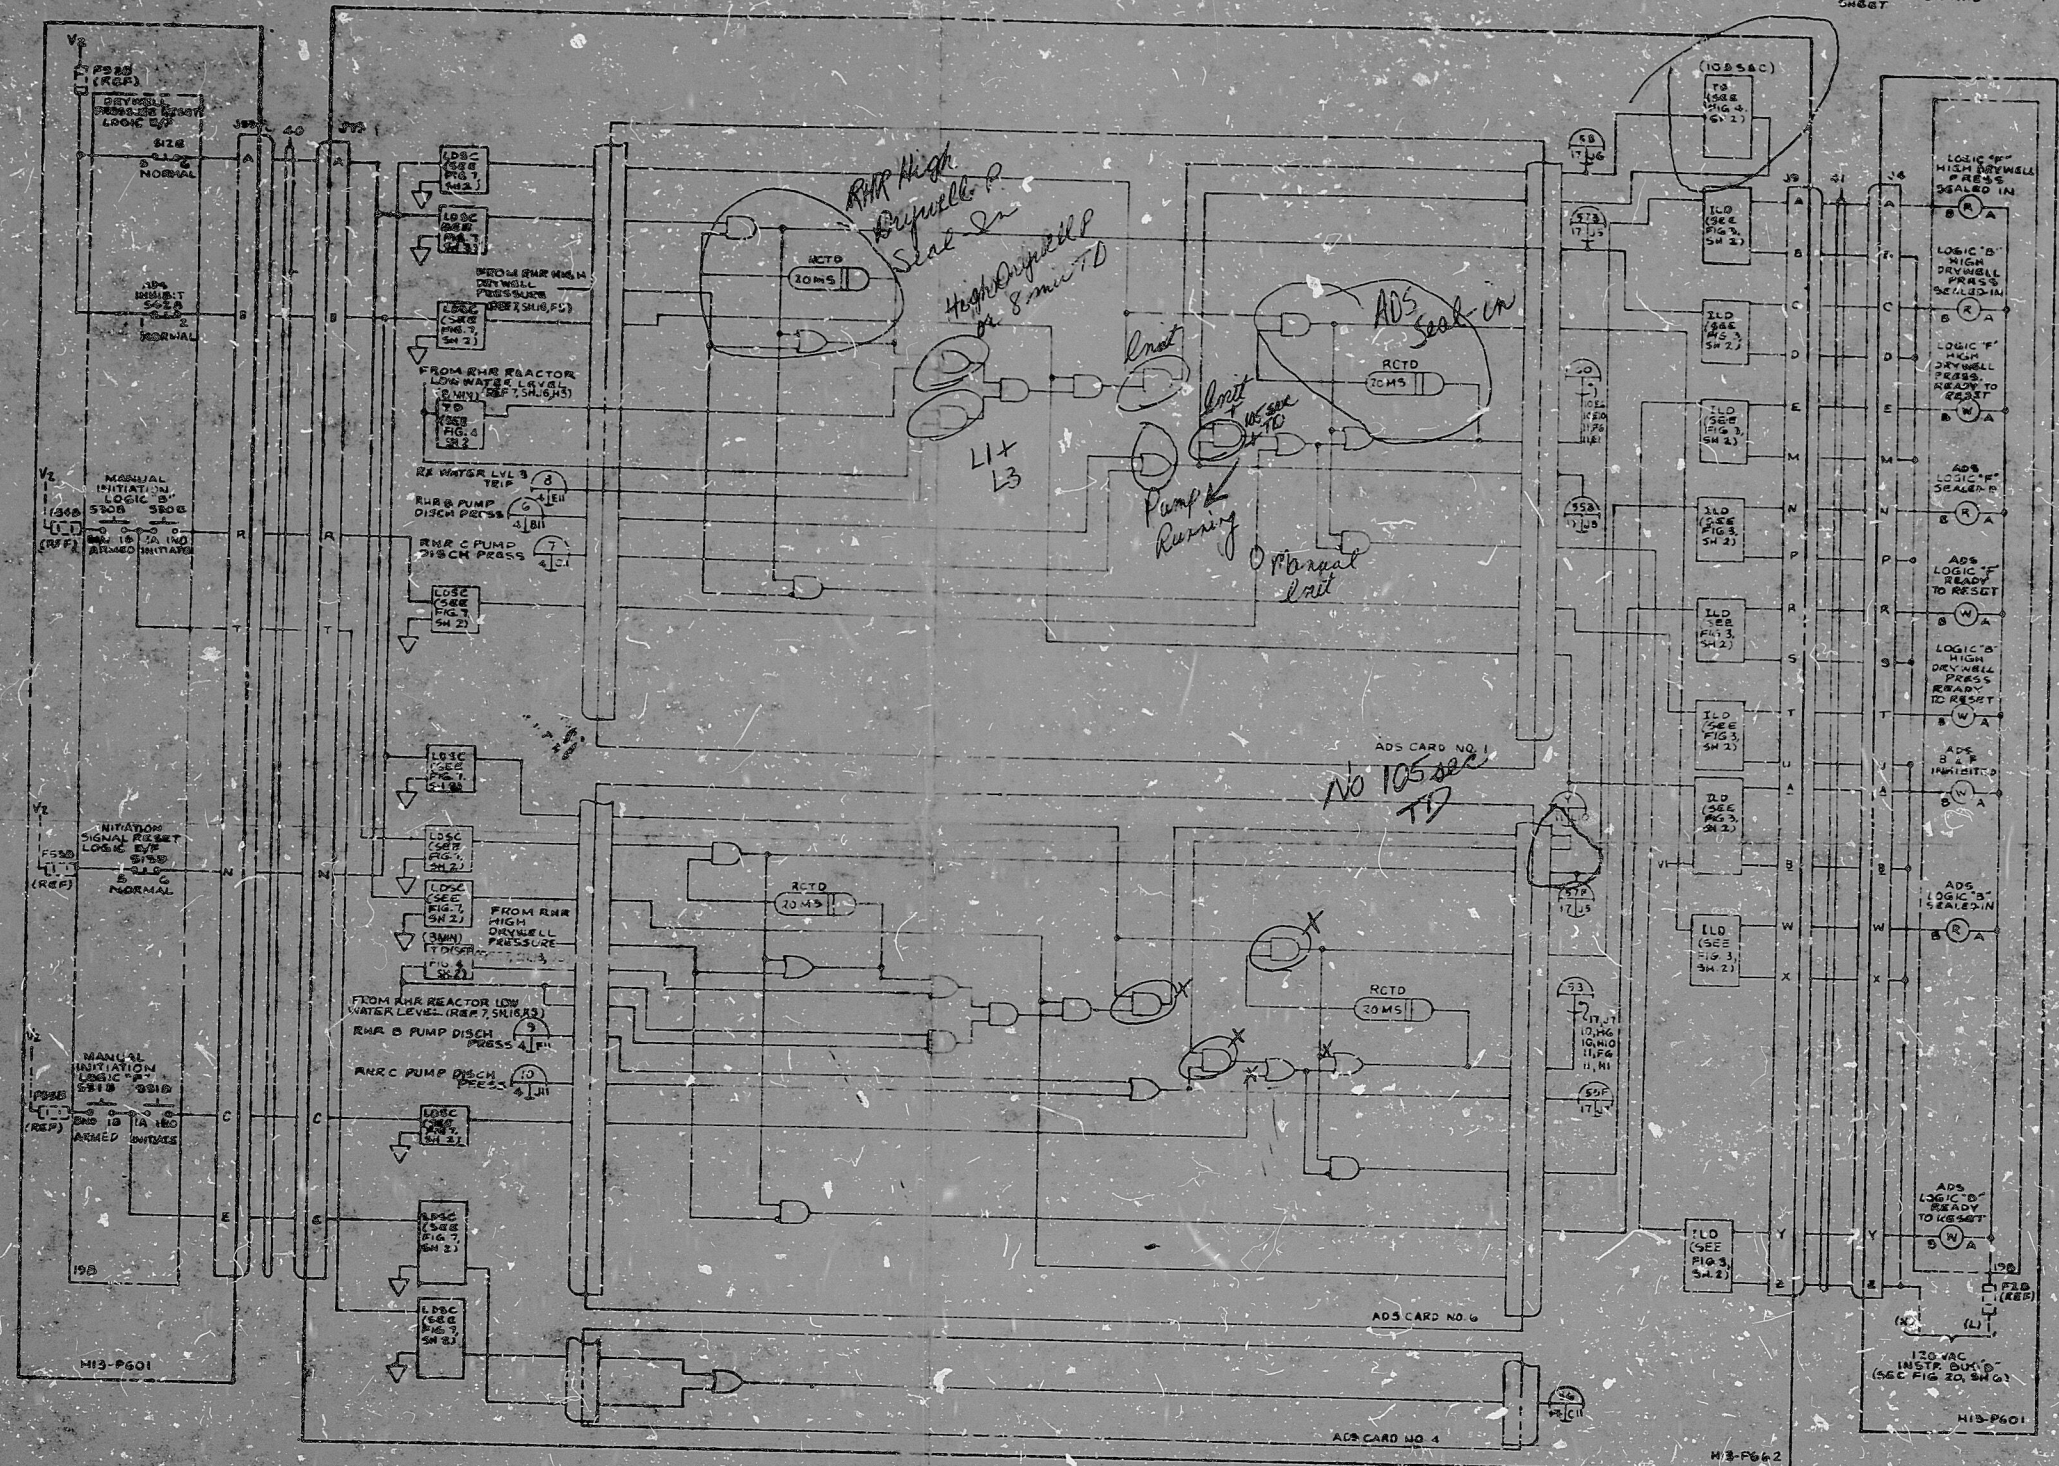

11
APERTURE
CARD

11






PDR RIDS

8402240303

