


66

68

66

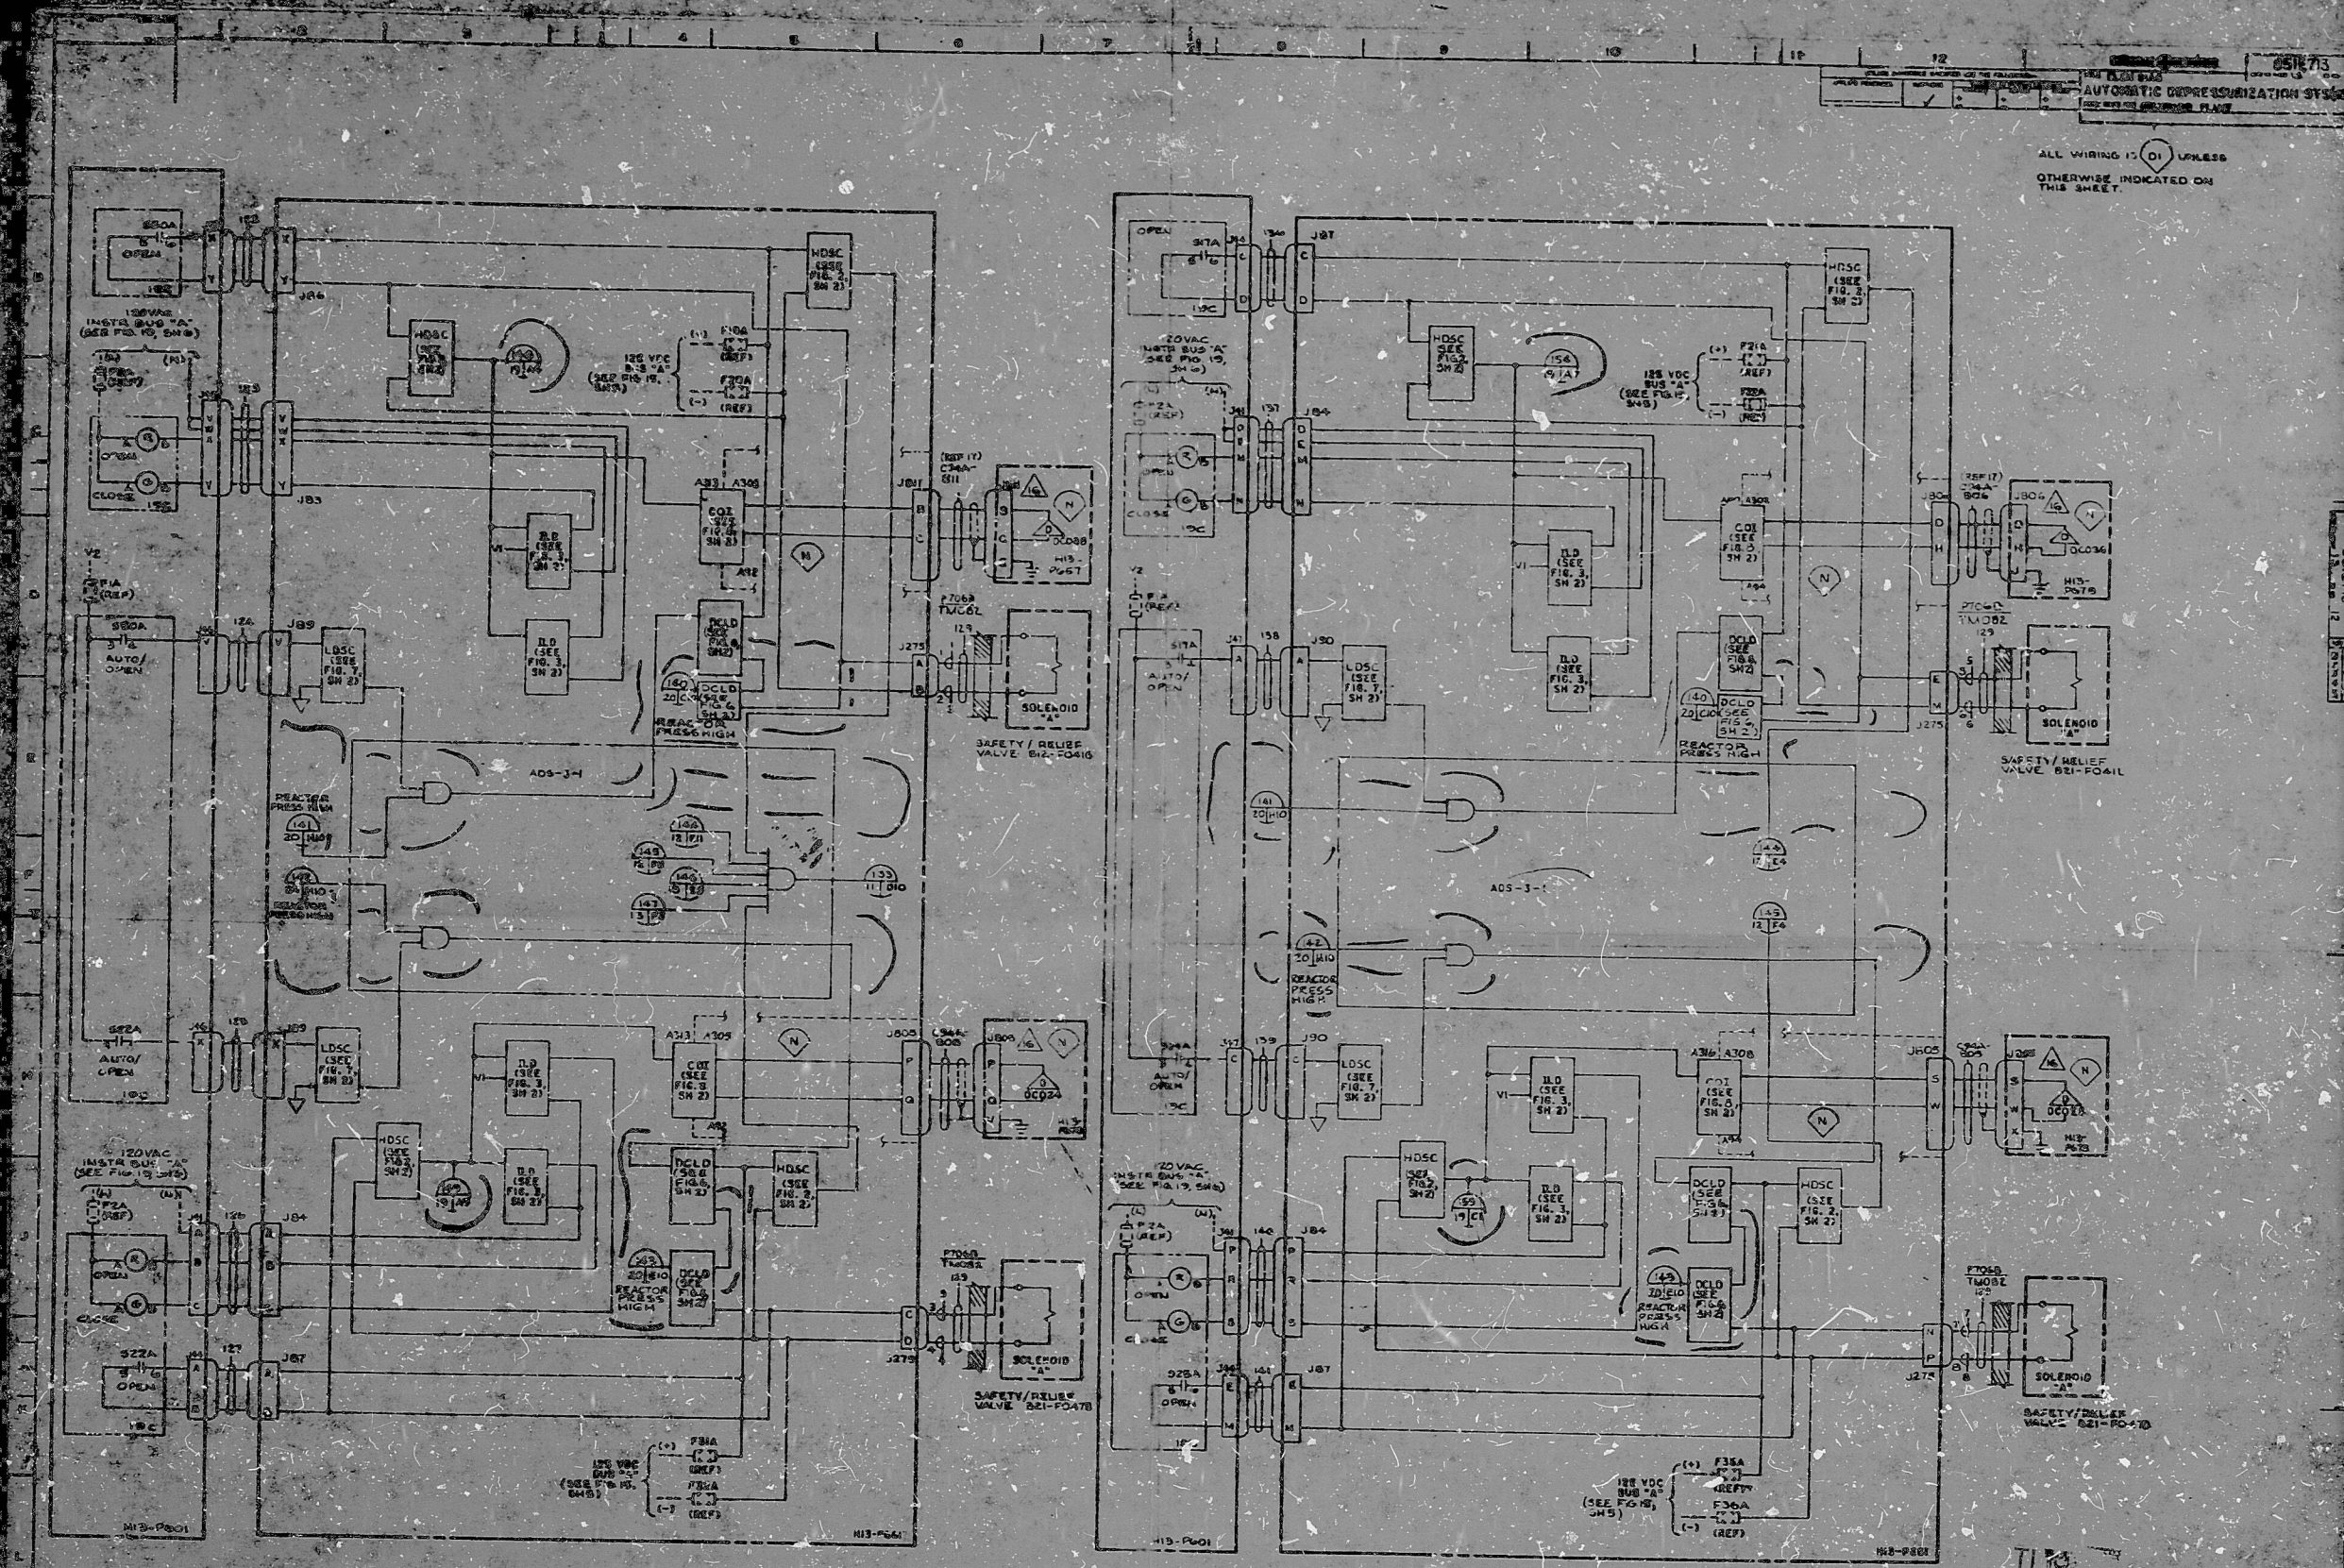

ALL WIRING IS DI UNLESS OTHERWISE INDICATED ON THIS SHEET.

TIP APERTURE CARD



11

11

8.5

8.5

11

17



PDR RIDS

8402240325

