


ALL WIRING IS (DB) UNLESS OTHERWISE INDICATED ON THIS SHEET.

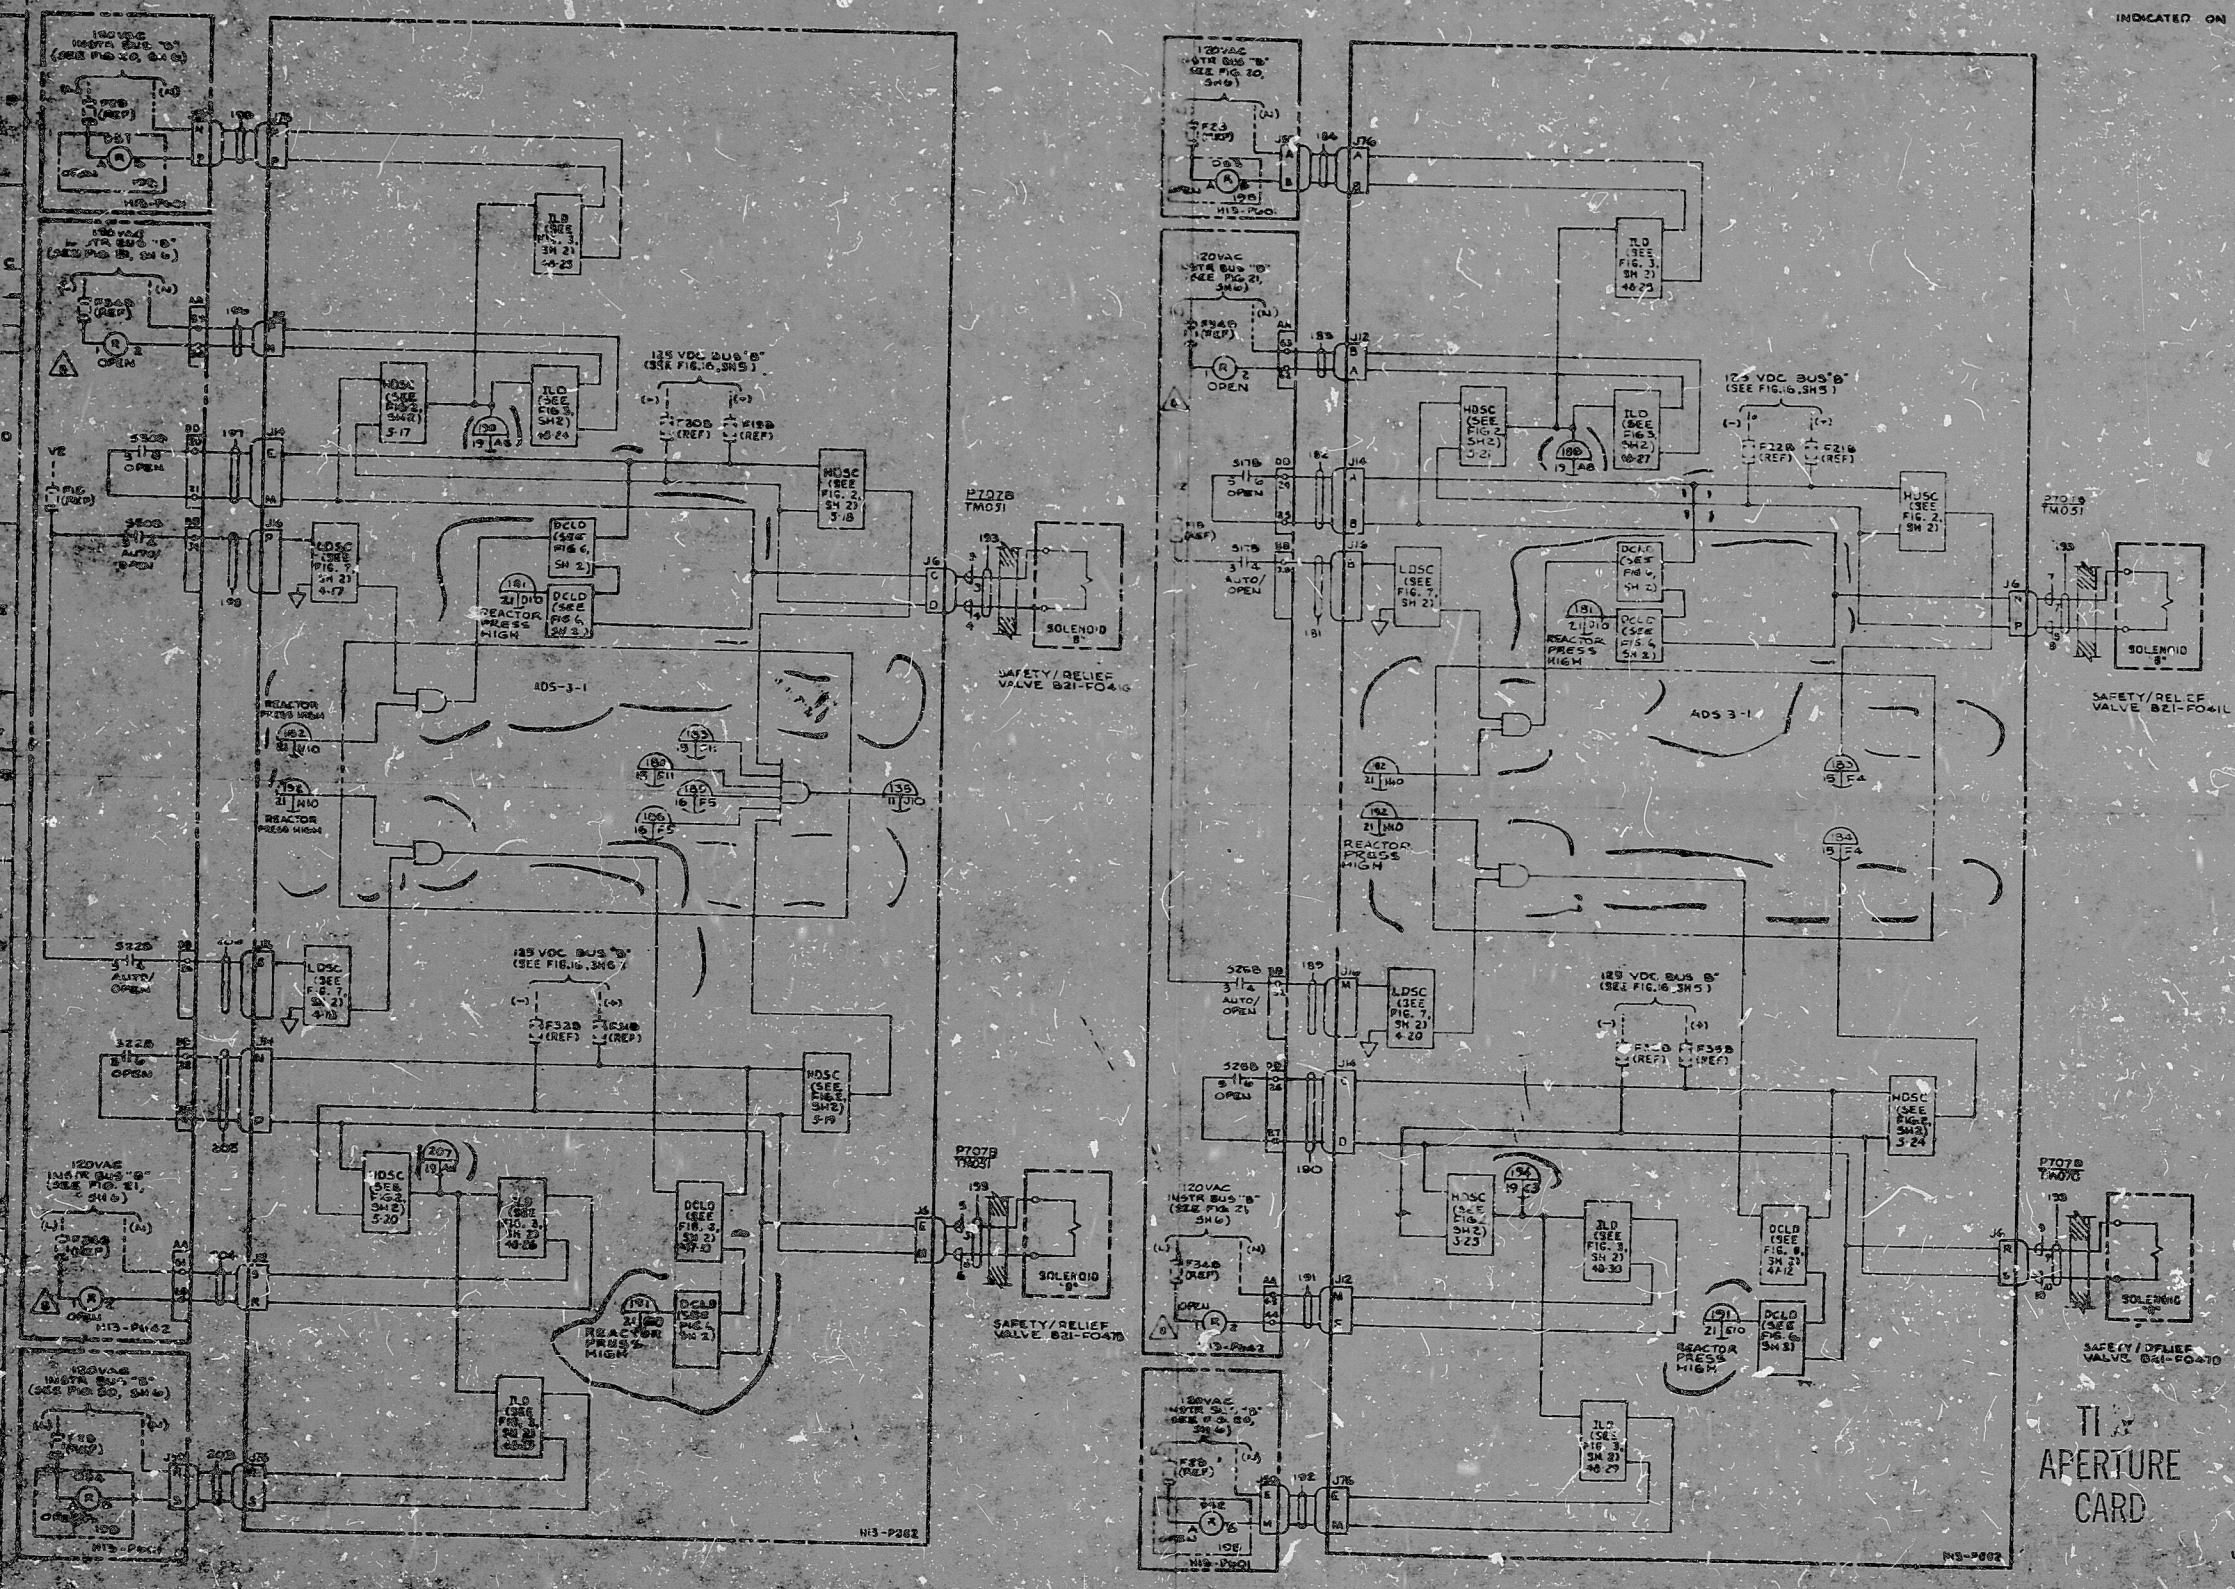

TI APERTURE CARD



21
11
8.5
8.5
11
17

PDR RIDS

84 02 24 0343

