

11


11

8.5"

8.5"

11"

17"

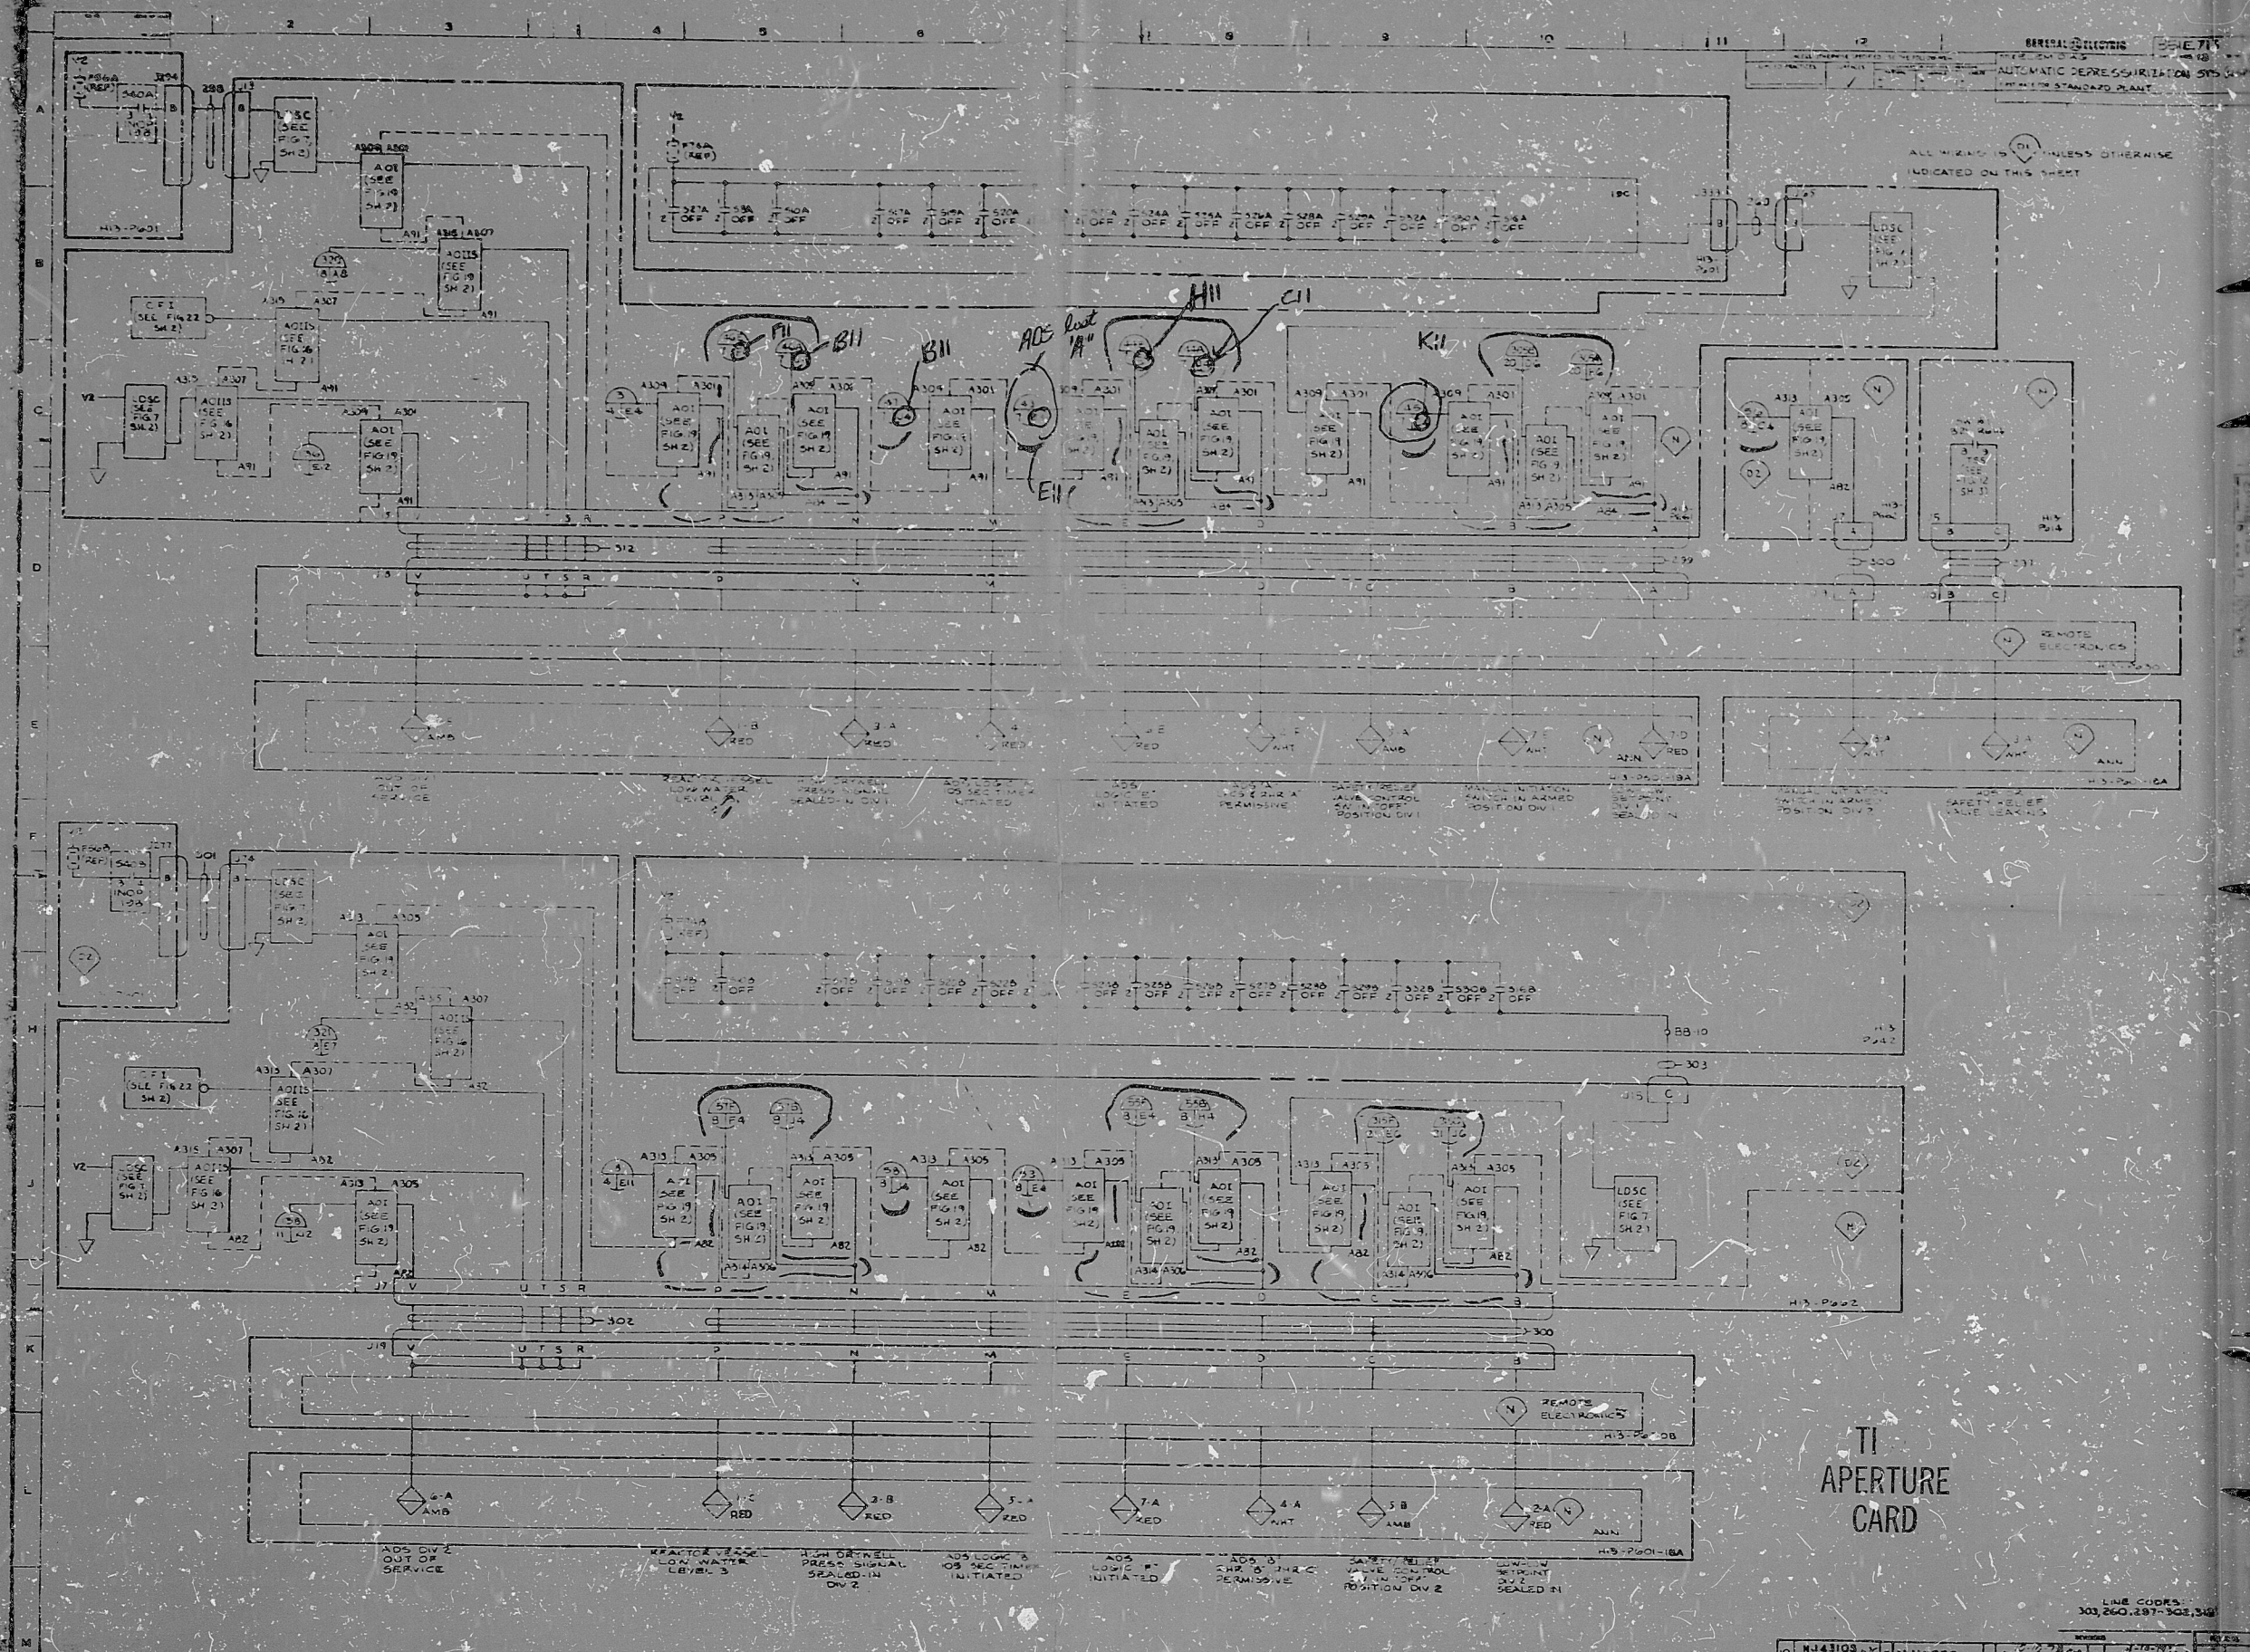

TI
APERTURE
CARD


NO.	DESCRIPTION	REV.	DATE	BY	CHK.
0	NJ43108	1			
1	NJ41703	5			
2	NJ45263	4			
3	NJ14530	1			
4	NJ19290	1			

PDR RID

8402-240351

